



23

ATHERTONS ADDITION
TO ELIZABETH CITY

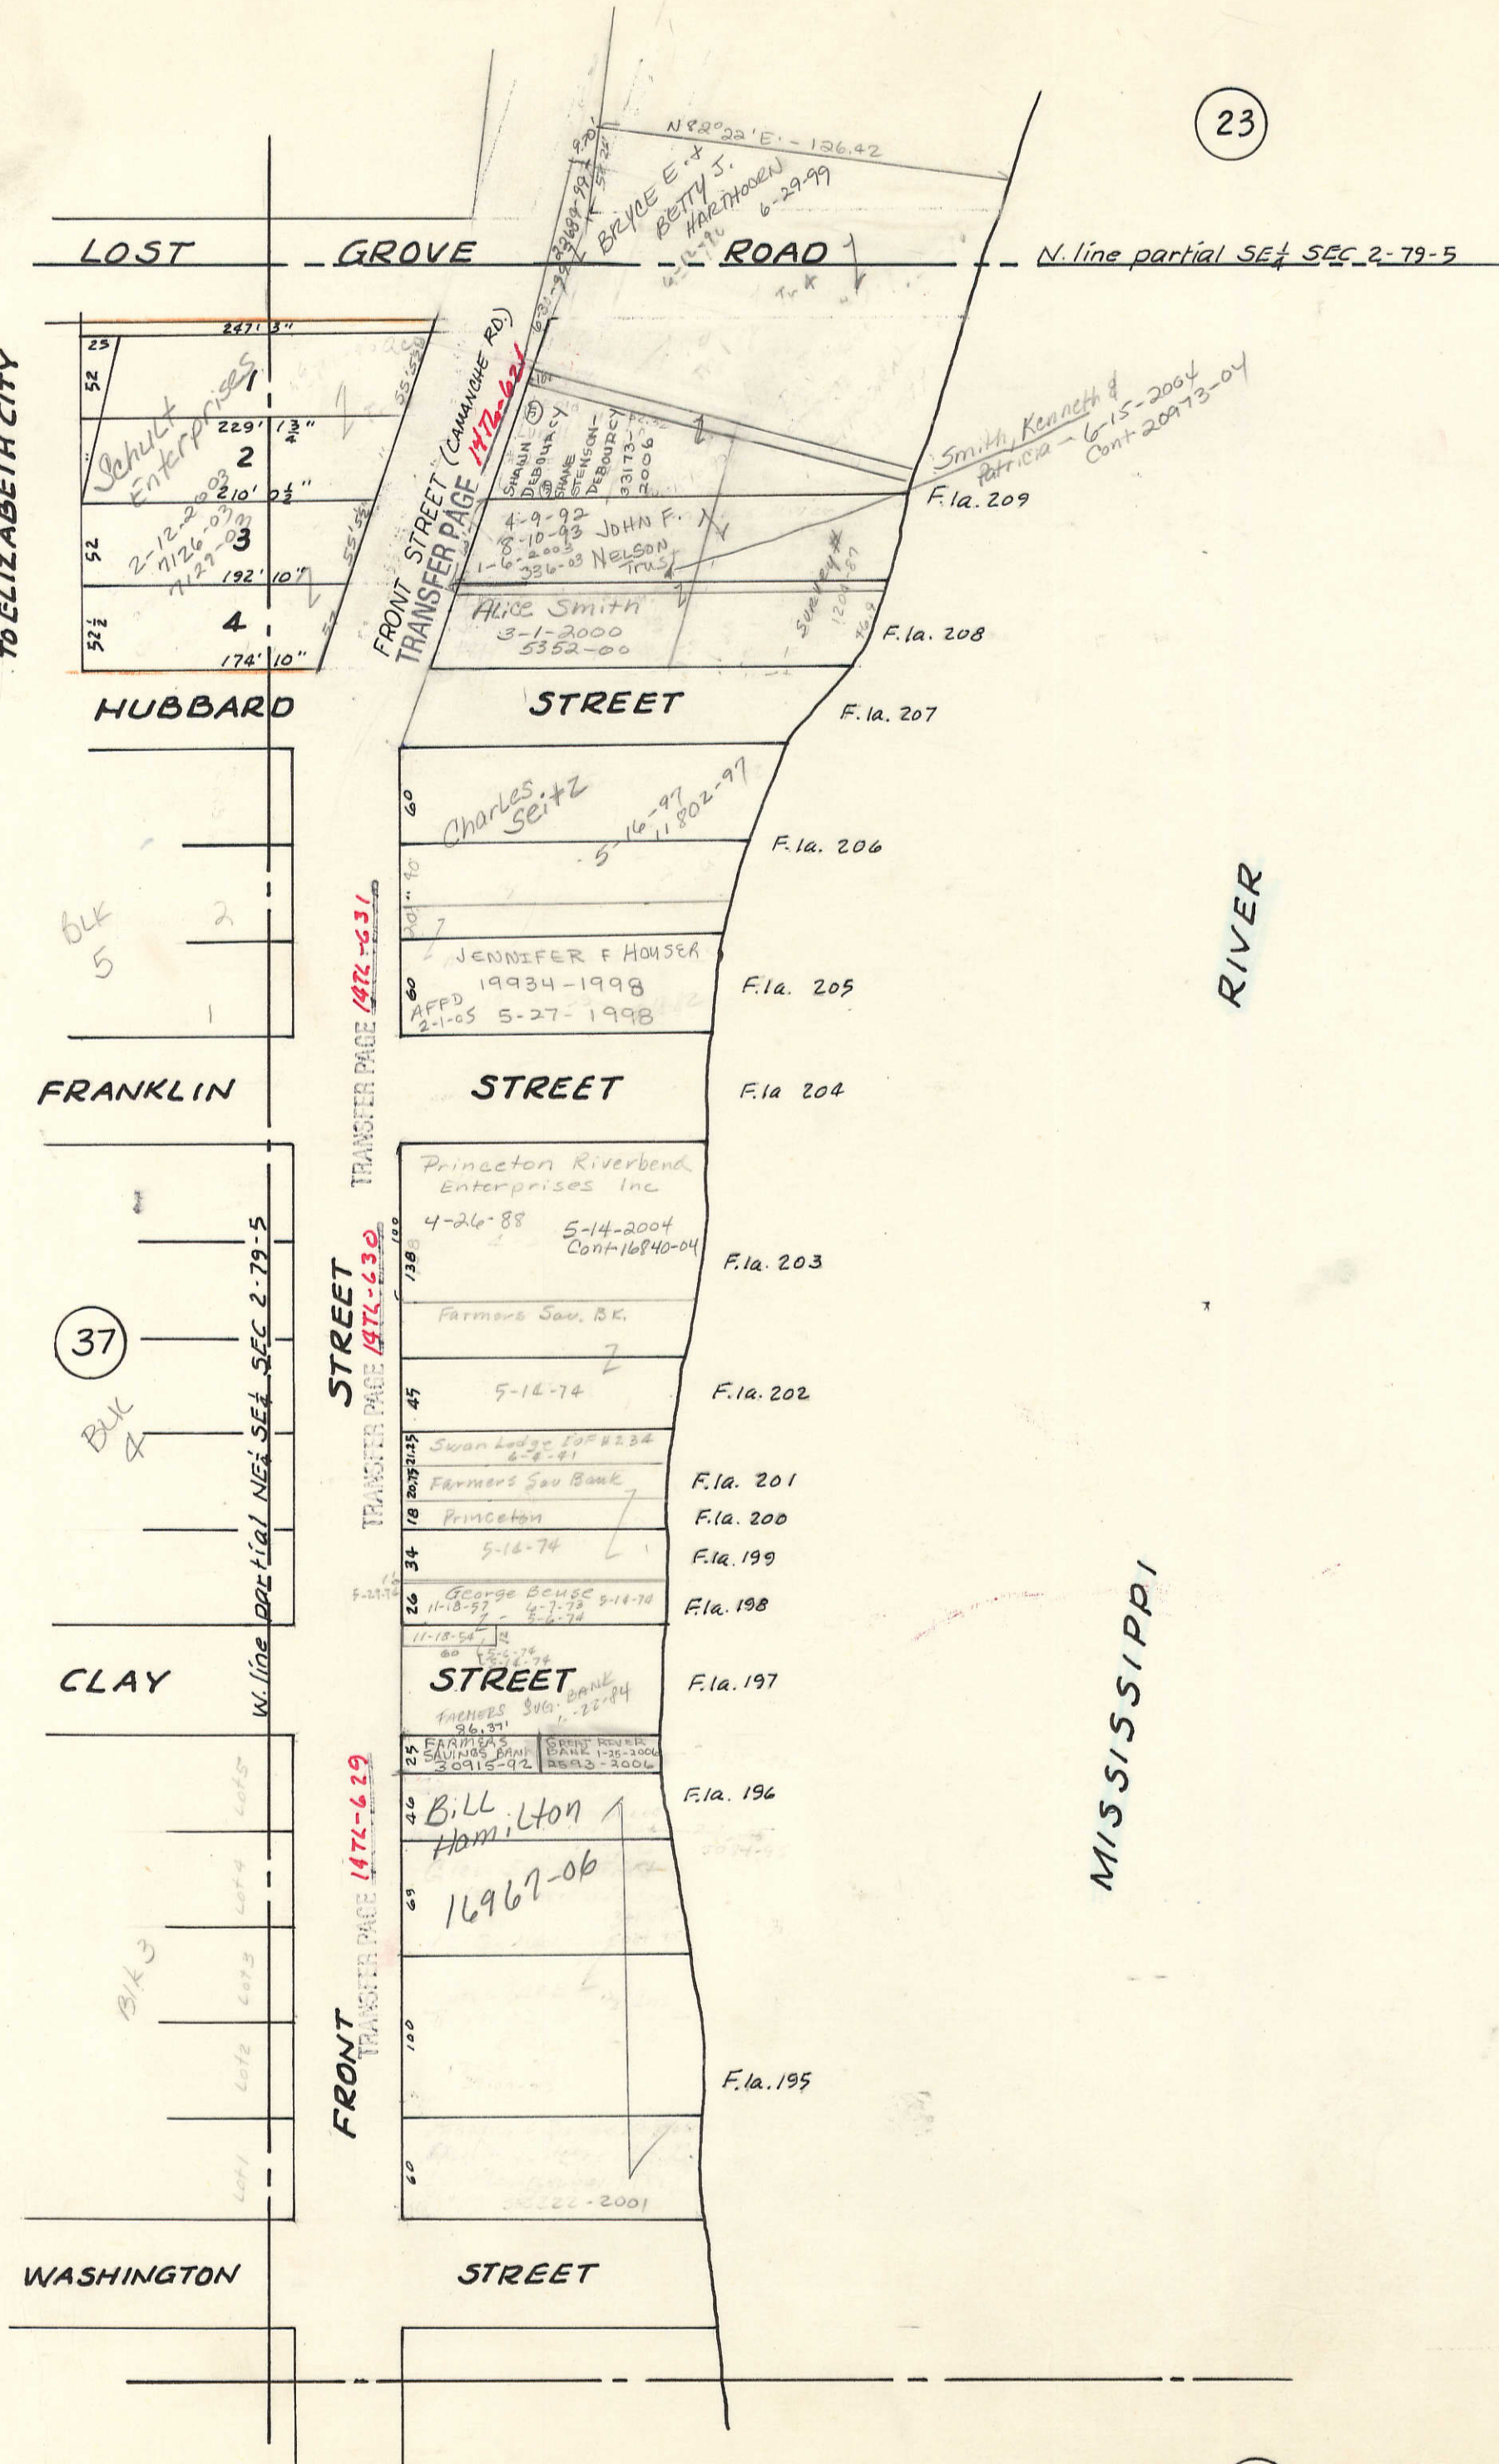

LOST GROVE ROAD

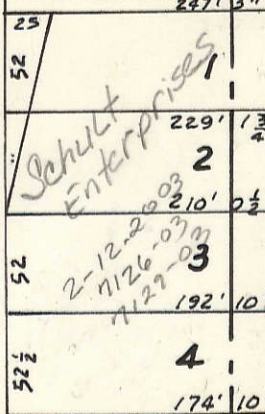

HUBBARD STREET

FRANKLIN STREET

CLAY STREET

WASHINGTON STREET

55

