



PRINCETON TOWNSHIP NE 1/4 NE 1/4 SEC 34-80-5

TRANSFER PAGE Blds-410

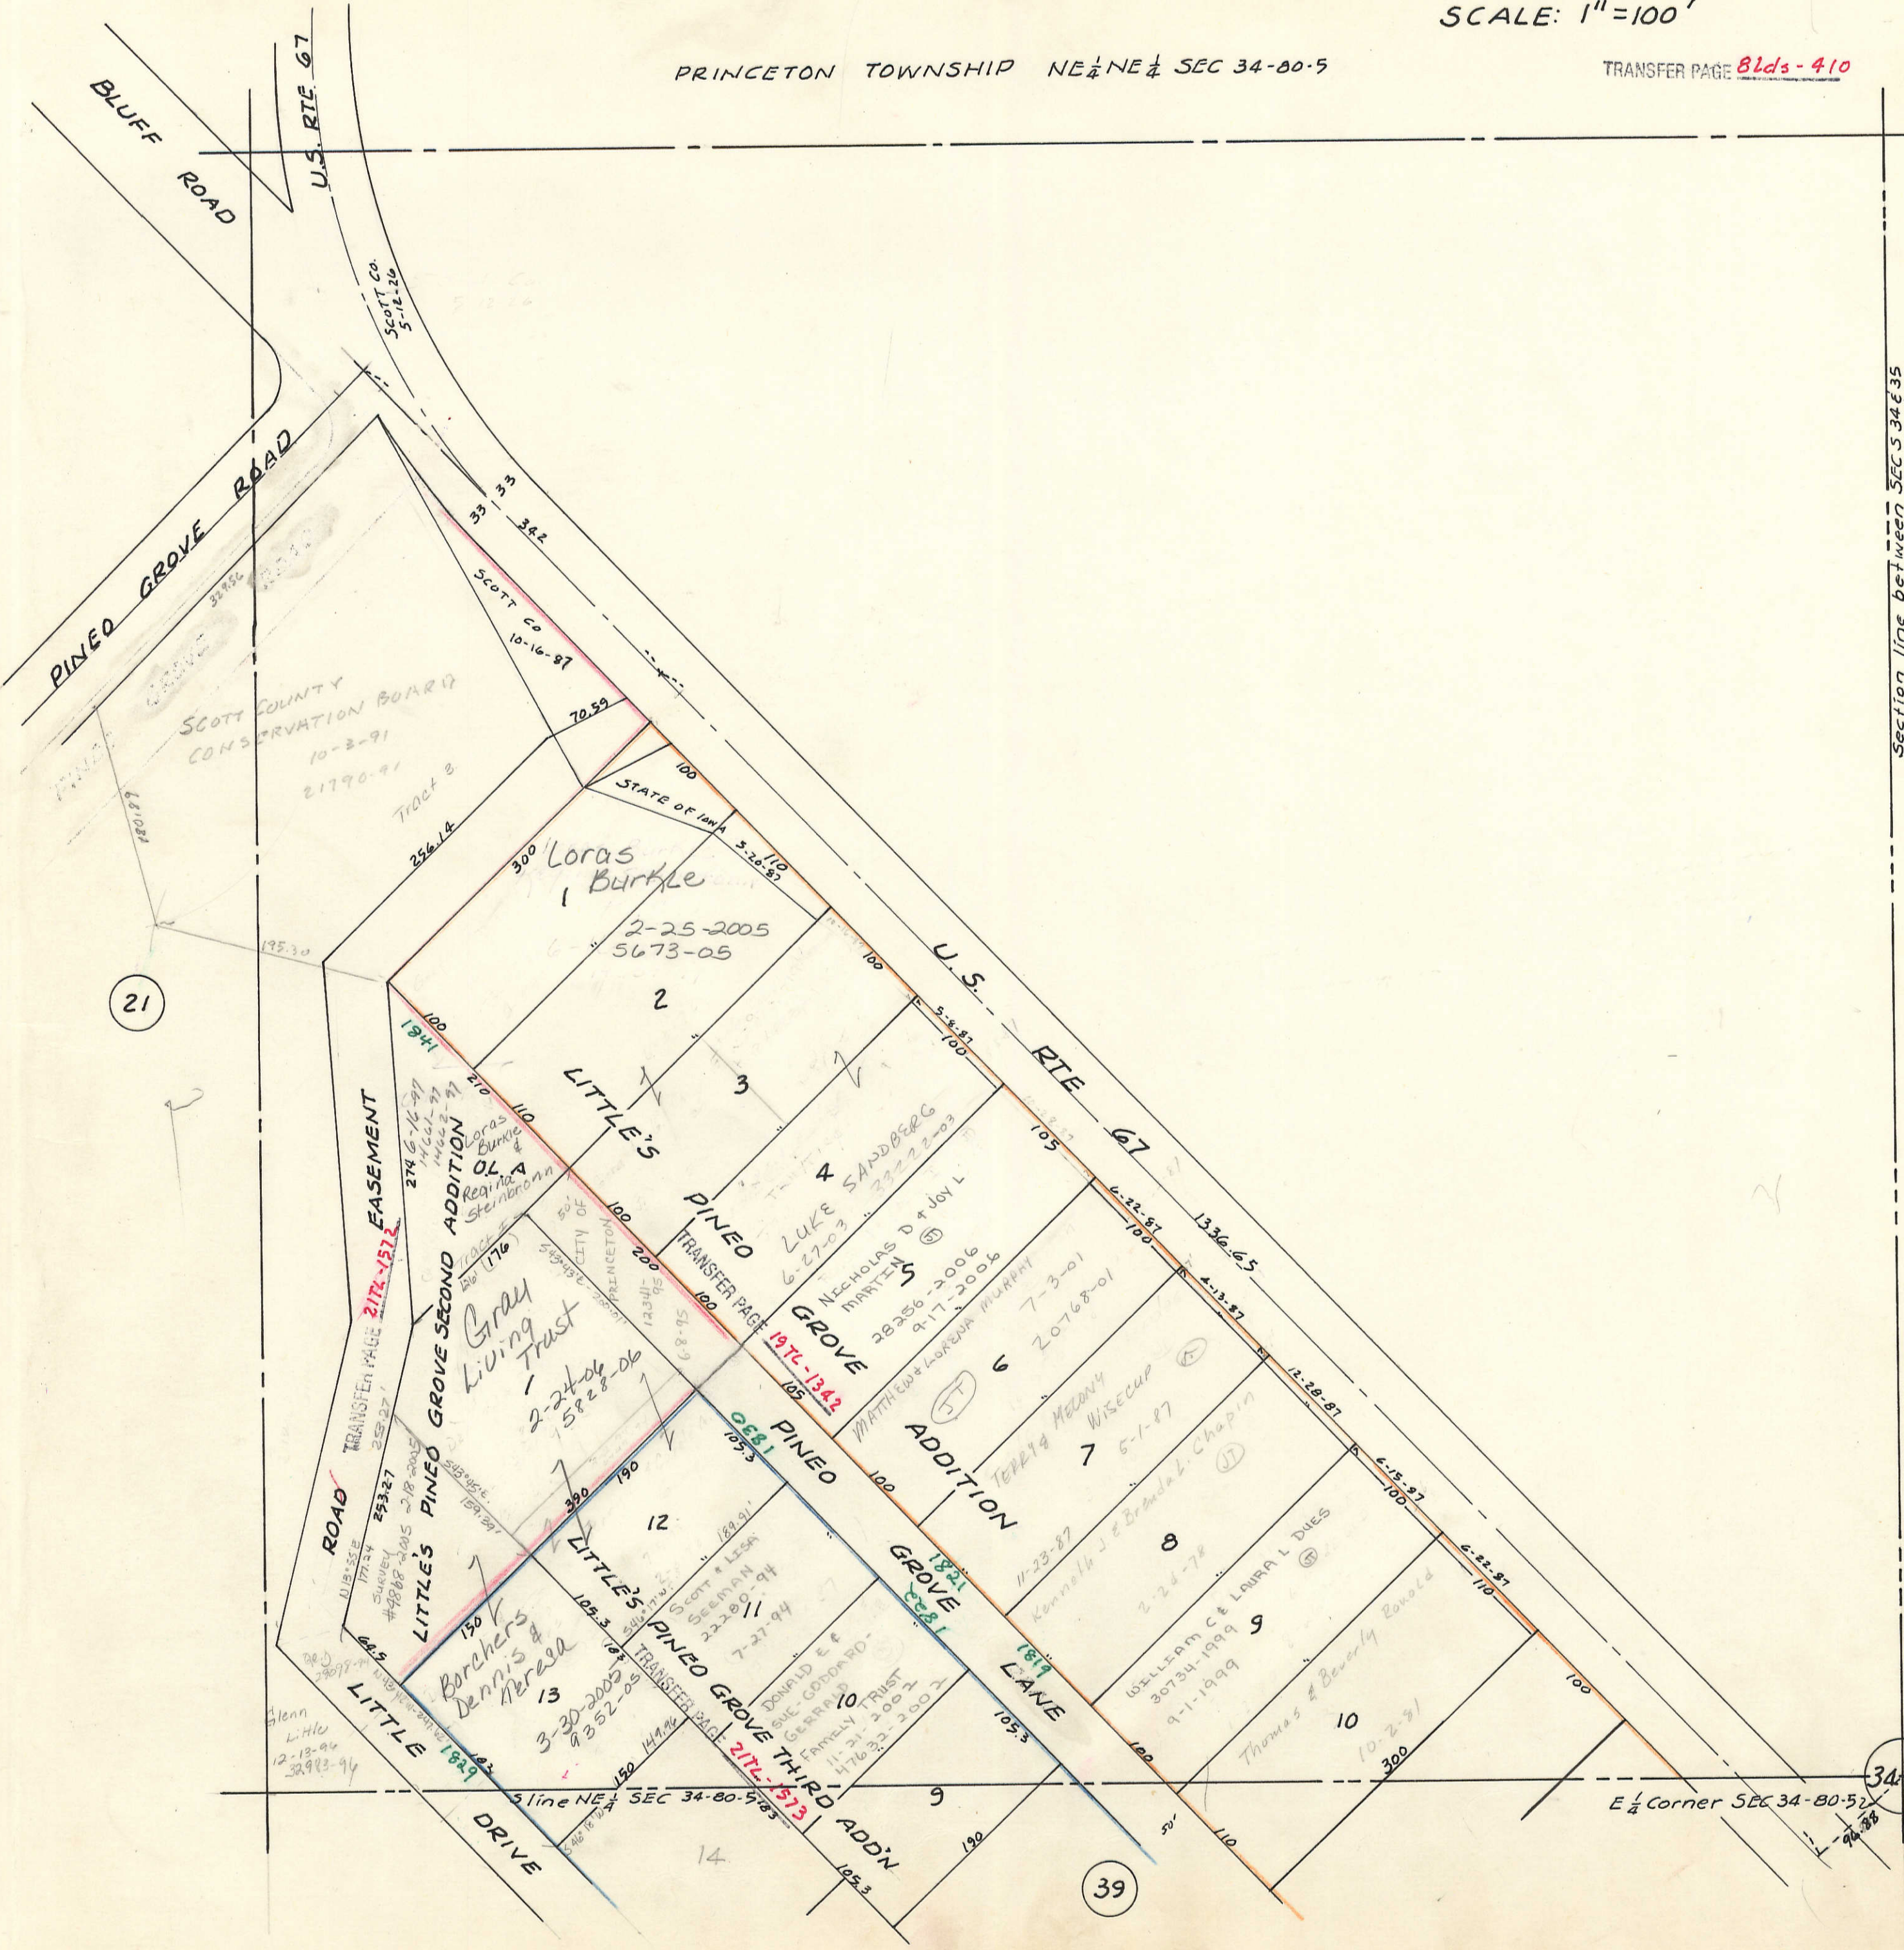

Section line between SEC 34 & 35

PRINCETON TOWNSHIP SW 1/4 NW 1/4 SEC 35-80-5

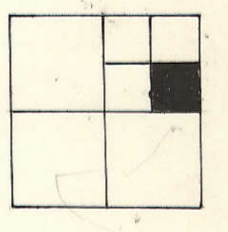

21

39

34-35

E 1/4 Corner SEC 34-80-5