



NOTE: Former Pages 55, 56,  
57 and 58 are incorporated  
on this one Page 55

Pl. 55	Pl. 56
Pl. 58	Pl. 57

SE 1/4 SE 1/4 SEC. 6-78-2  
CITY OF WALCOTT  
SCALE: 1 IN. = 100 FT.

TRANSFER PAGE 514-37

39

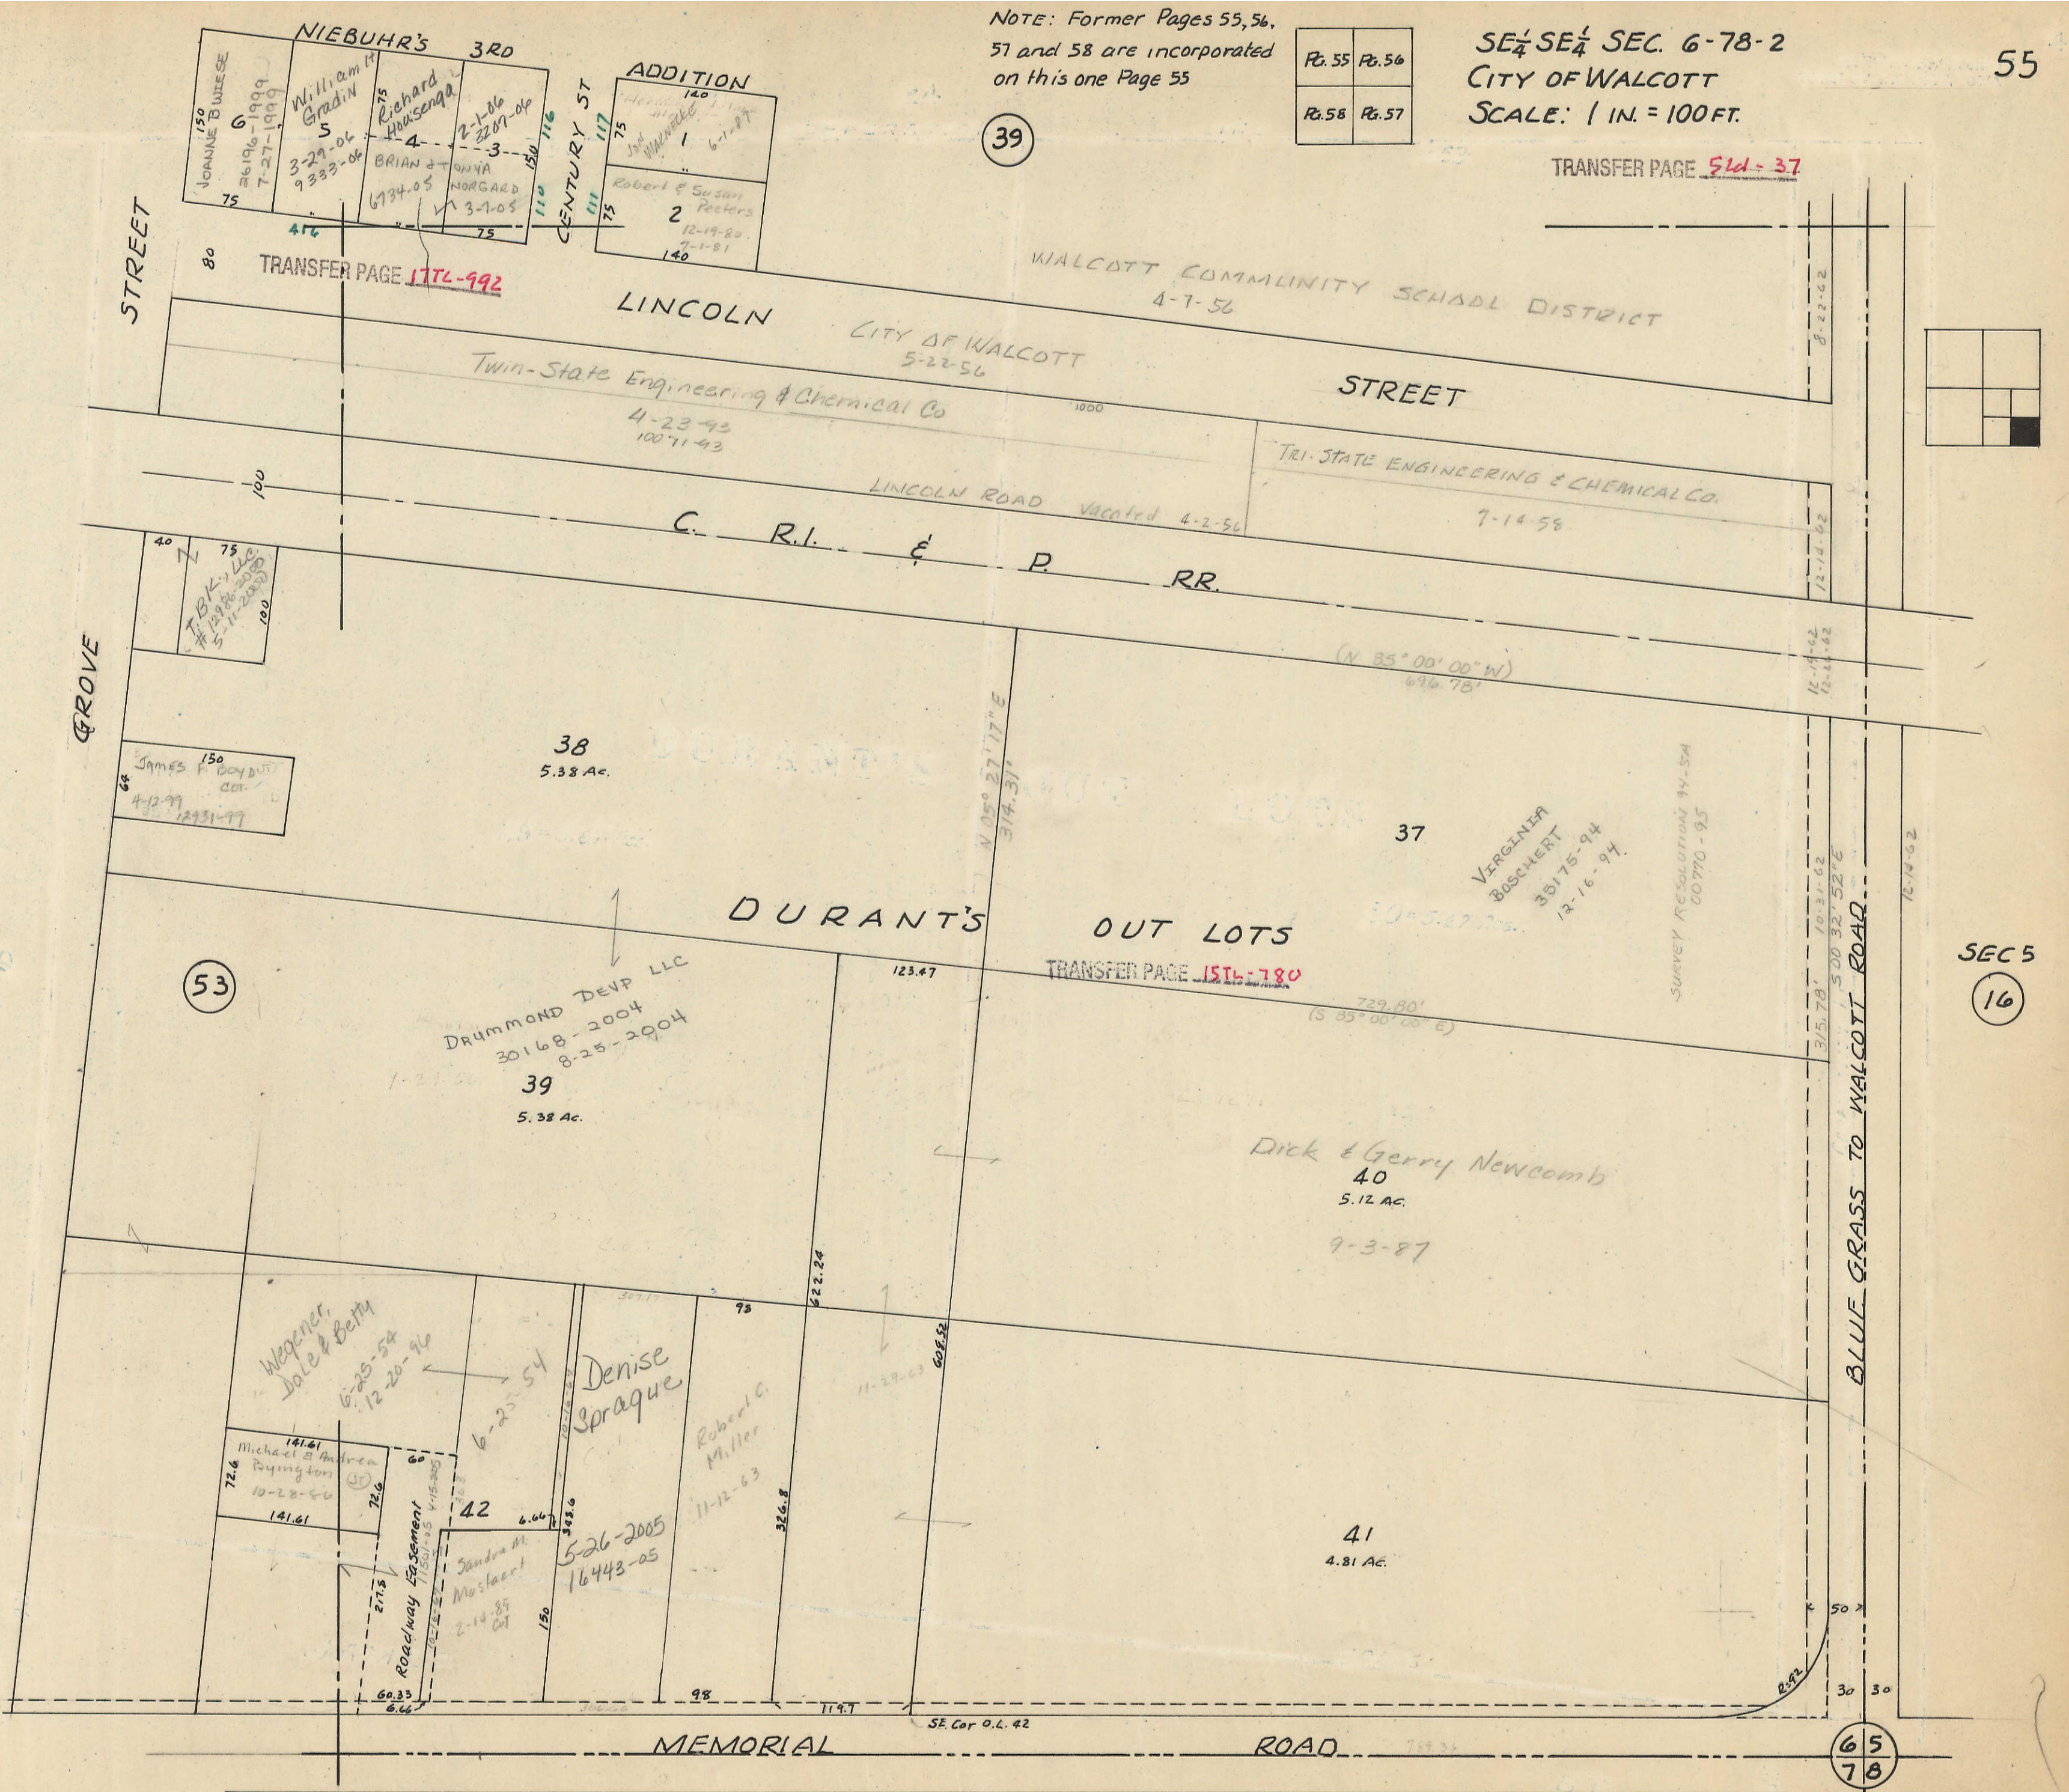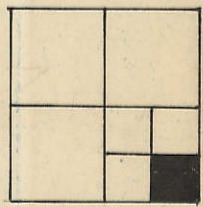

53

SEC 5  
16

65  
78

SEC. 7  
7