


TRANSFER PAGE 71ds-250

35

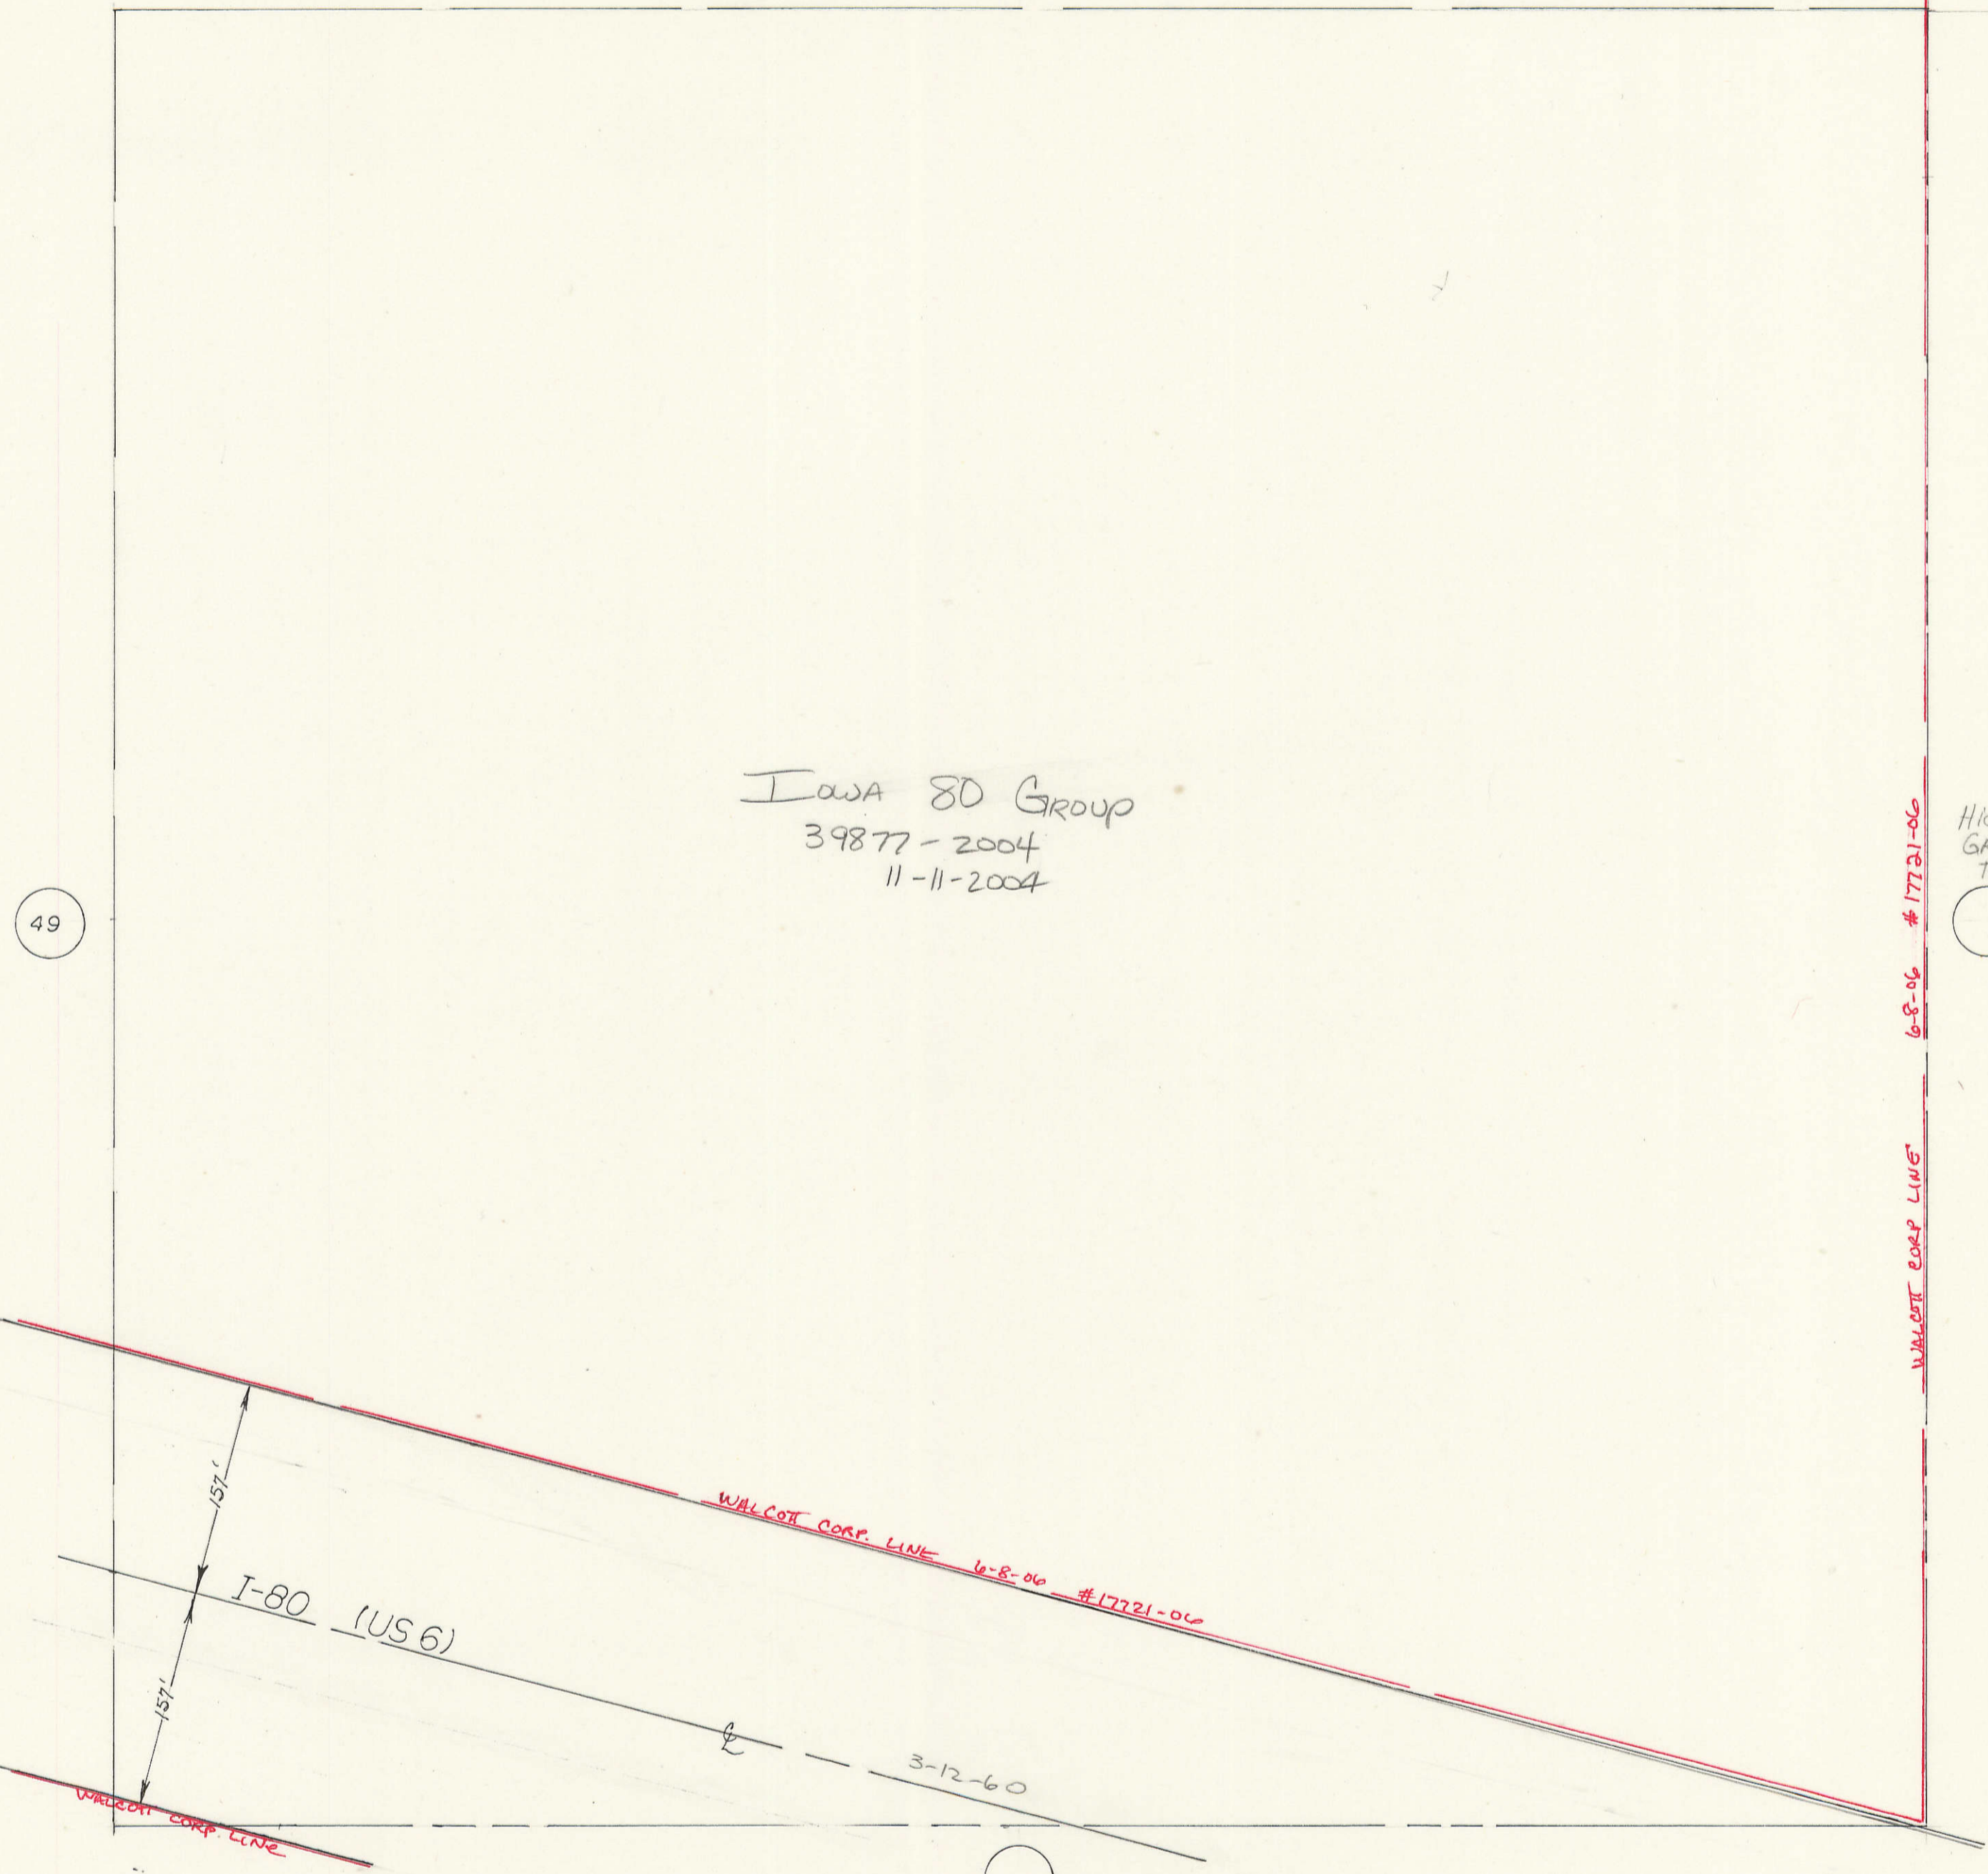

Iowa 80 Group
39877-2004
11-11-2004

Hickory
Grove
Twp

49

SEC. 32