
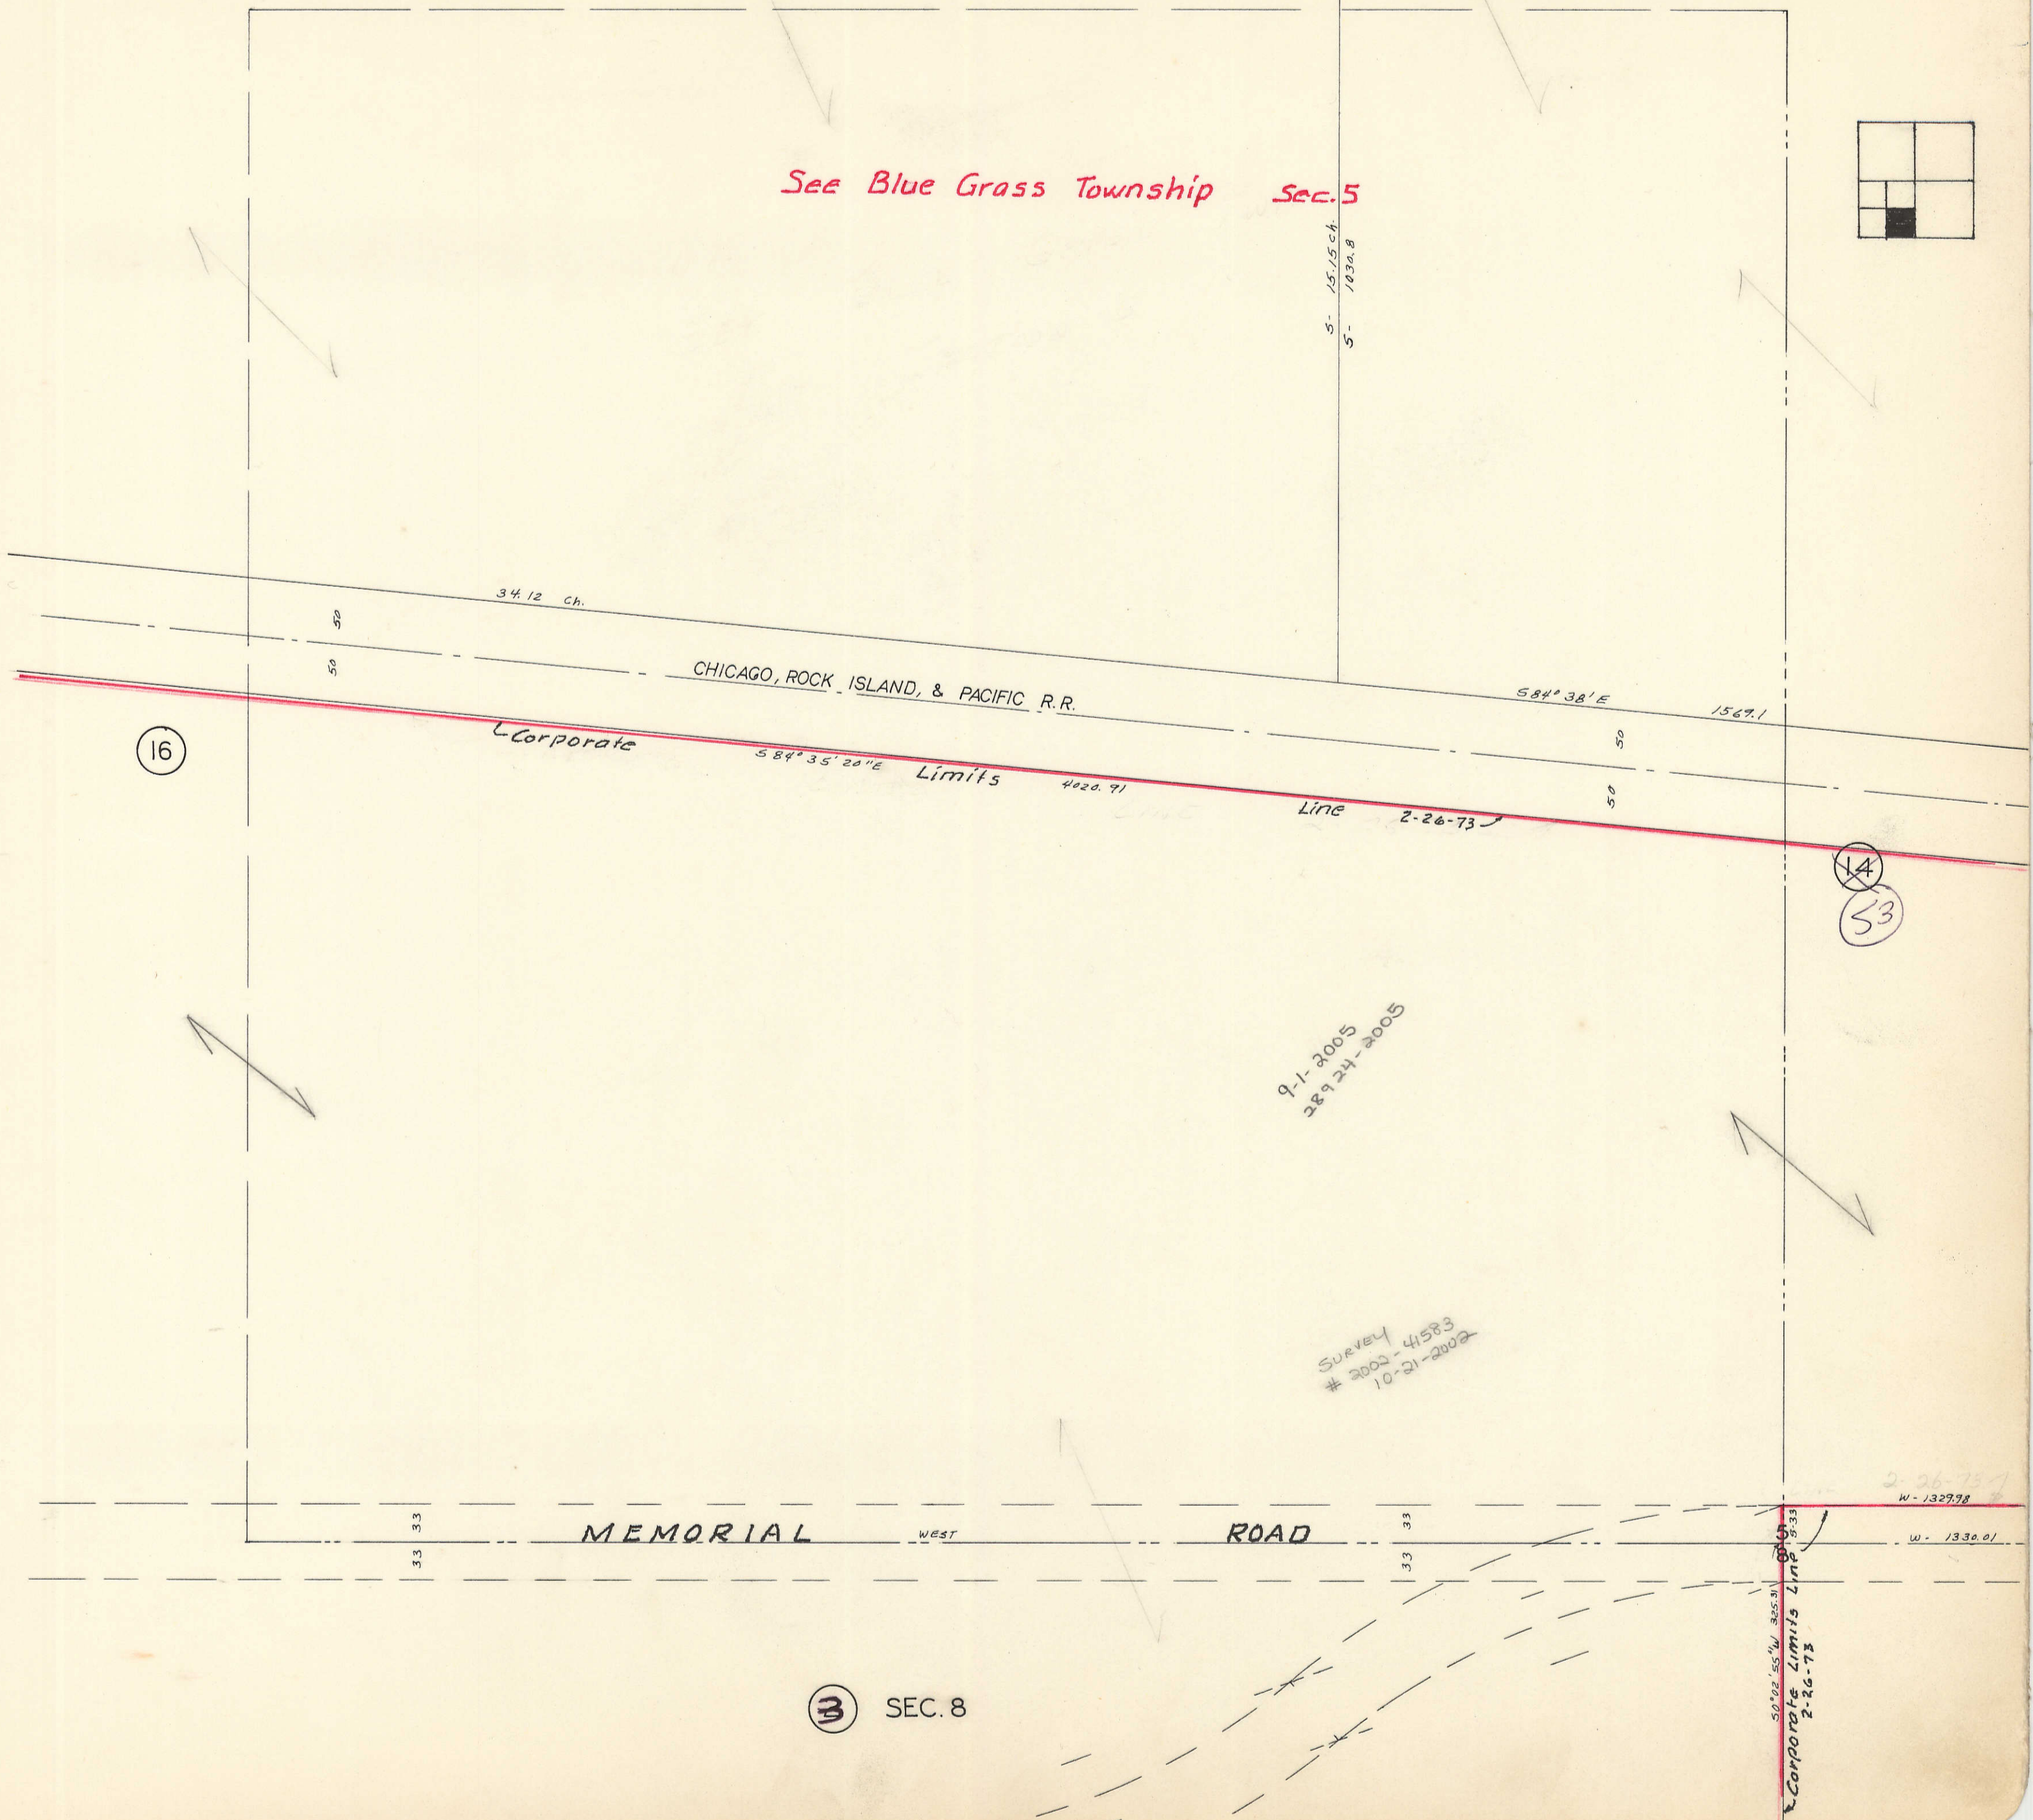


See Blue Grass Township Sec. 5

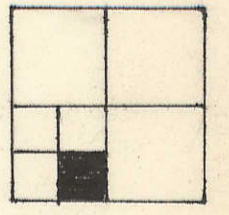

3 SEC. 8