
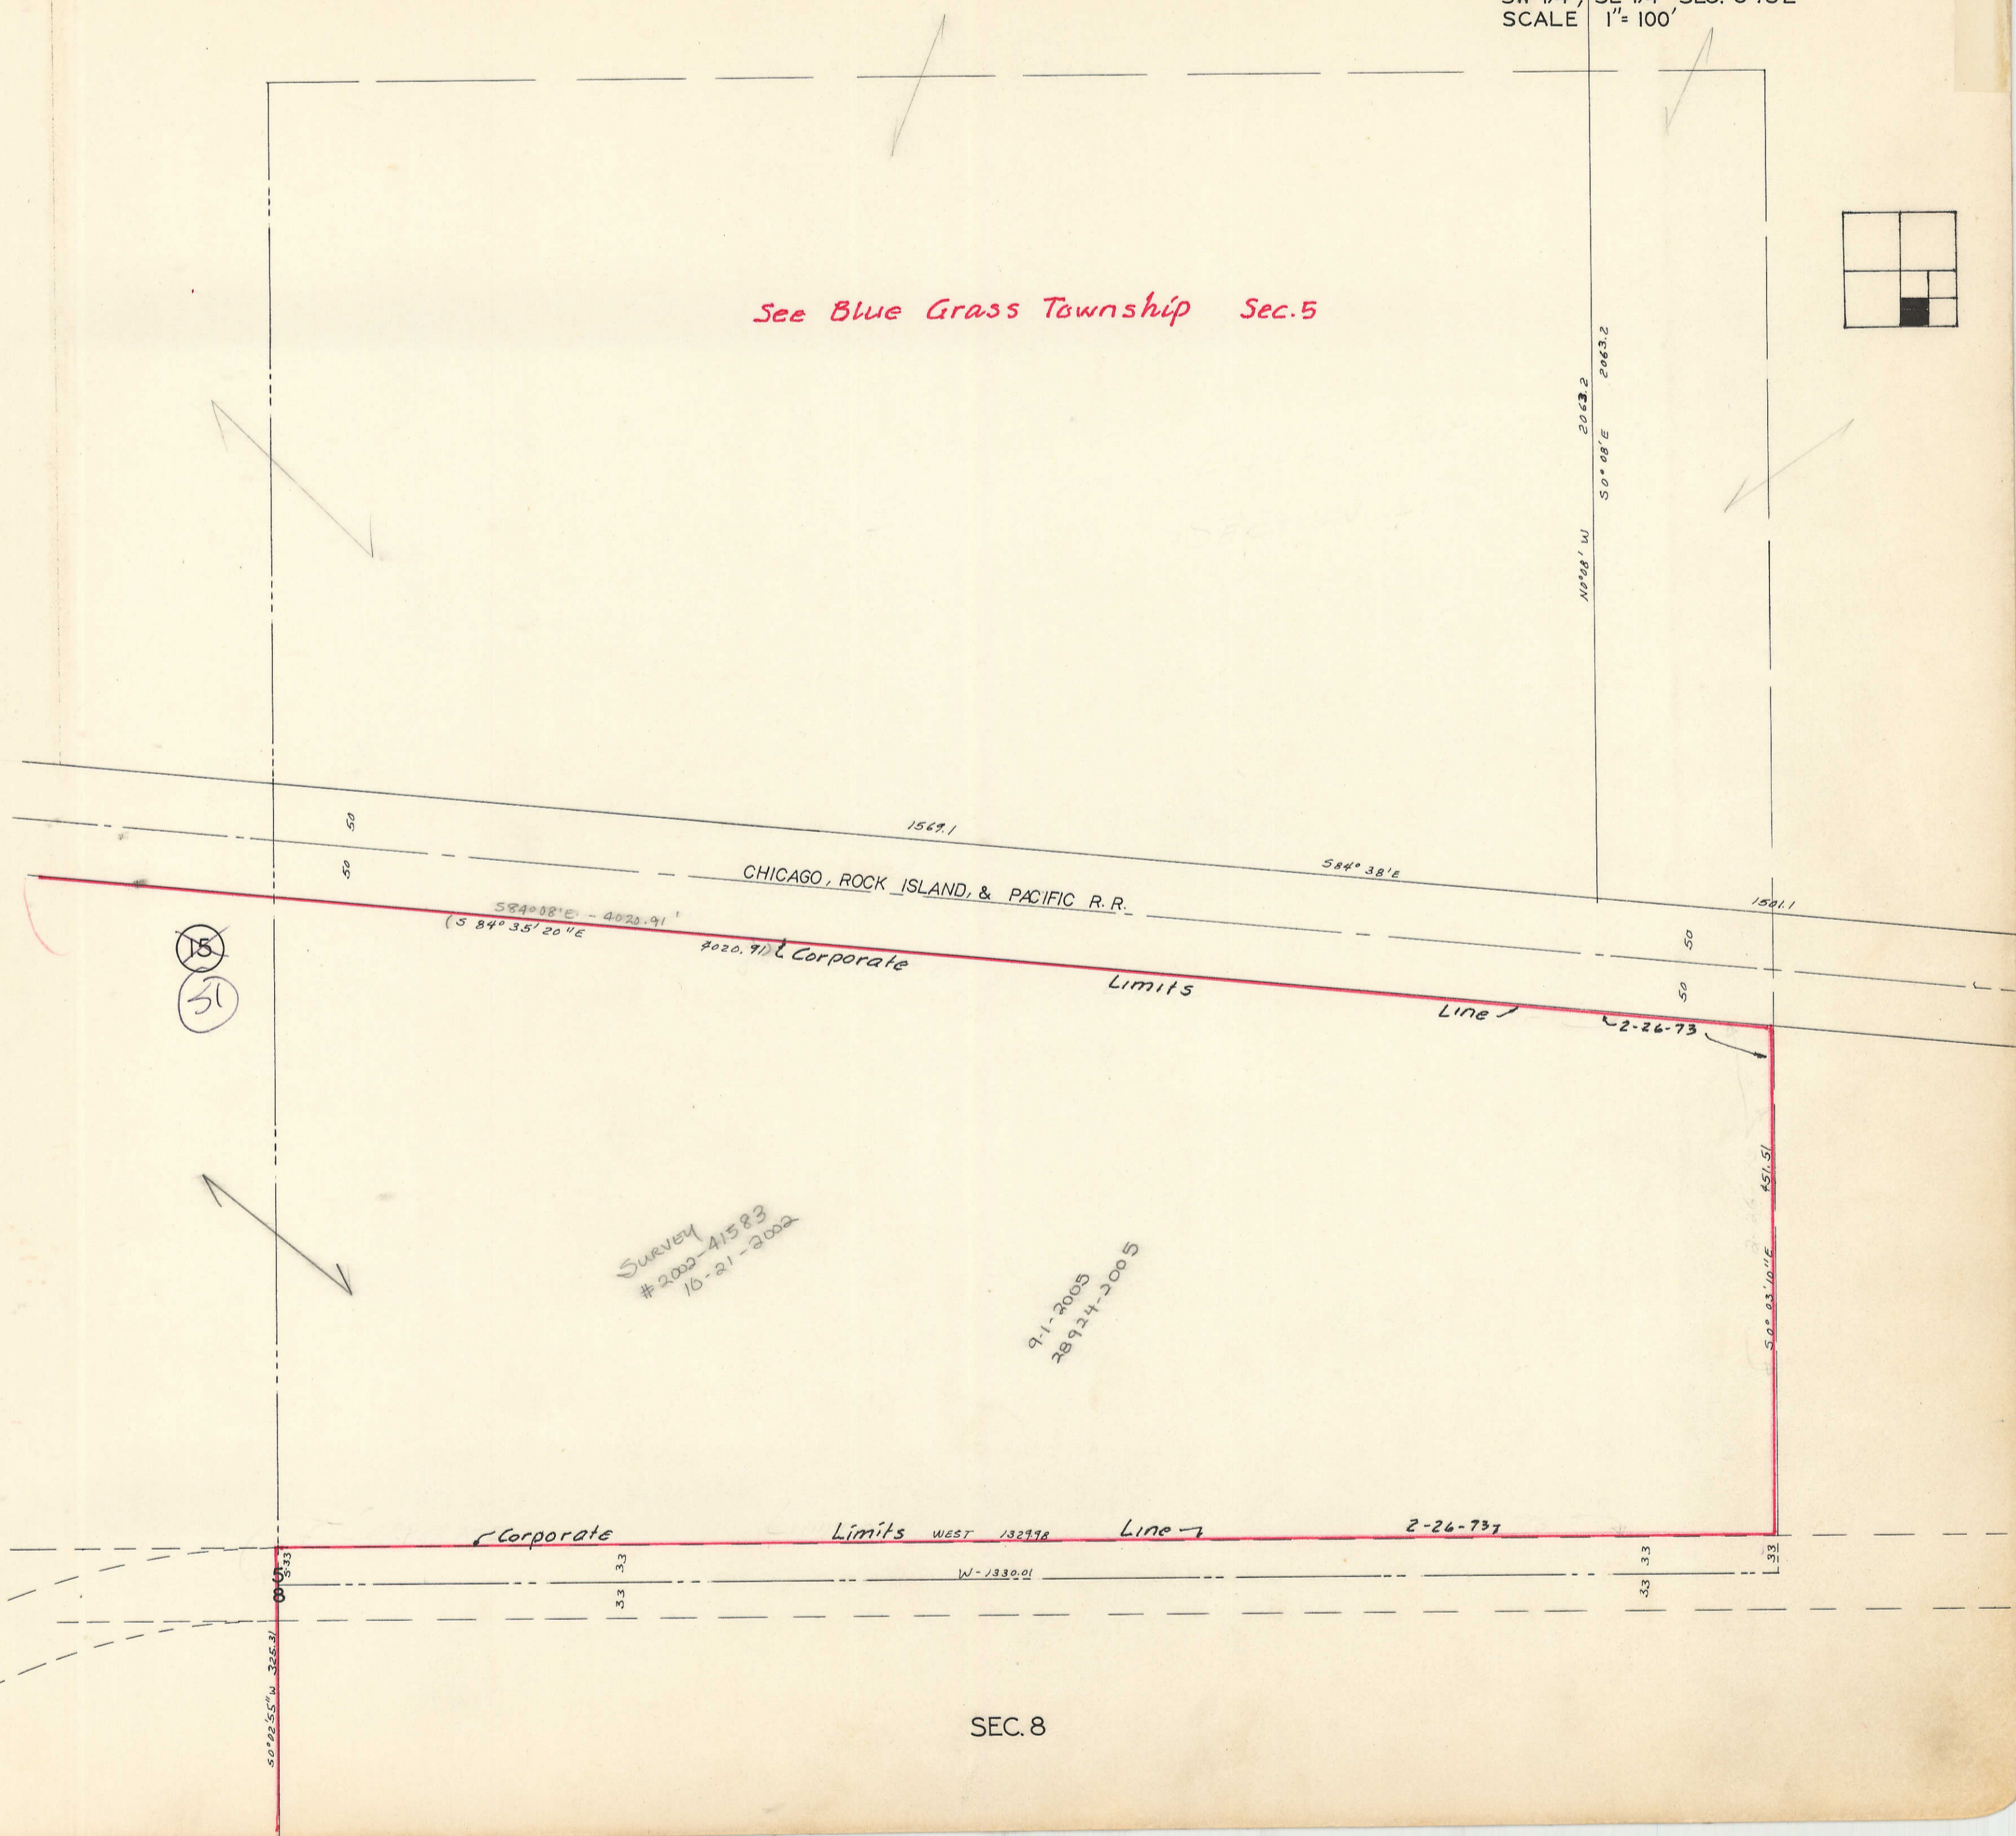


CITY OF WALCOTT  
SW 1/4, SE 1/4 SEC. 5-78-2  
SCALE 1" = 100'

See Blue Grass Township Sec. 5

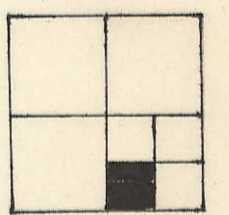

15  
31

Survey  
#2002-41583  
10-21-2002

9-1-2005  
28924-2005

SEC. 8