SE¼ SW¼ SECTION 23-80-2
ALLEN'S GROVE TWP
SCALE: 1 in. = 100 ft.

TRANSFER PAGE 51ds 18

23-35

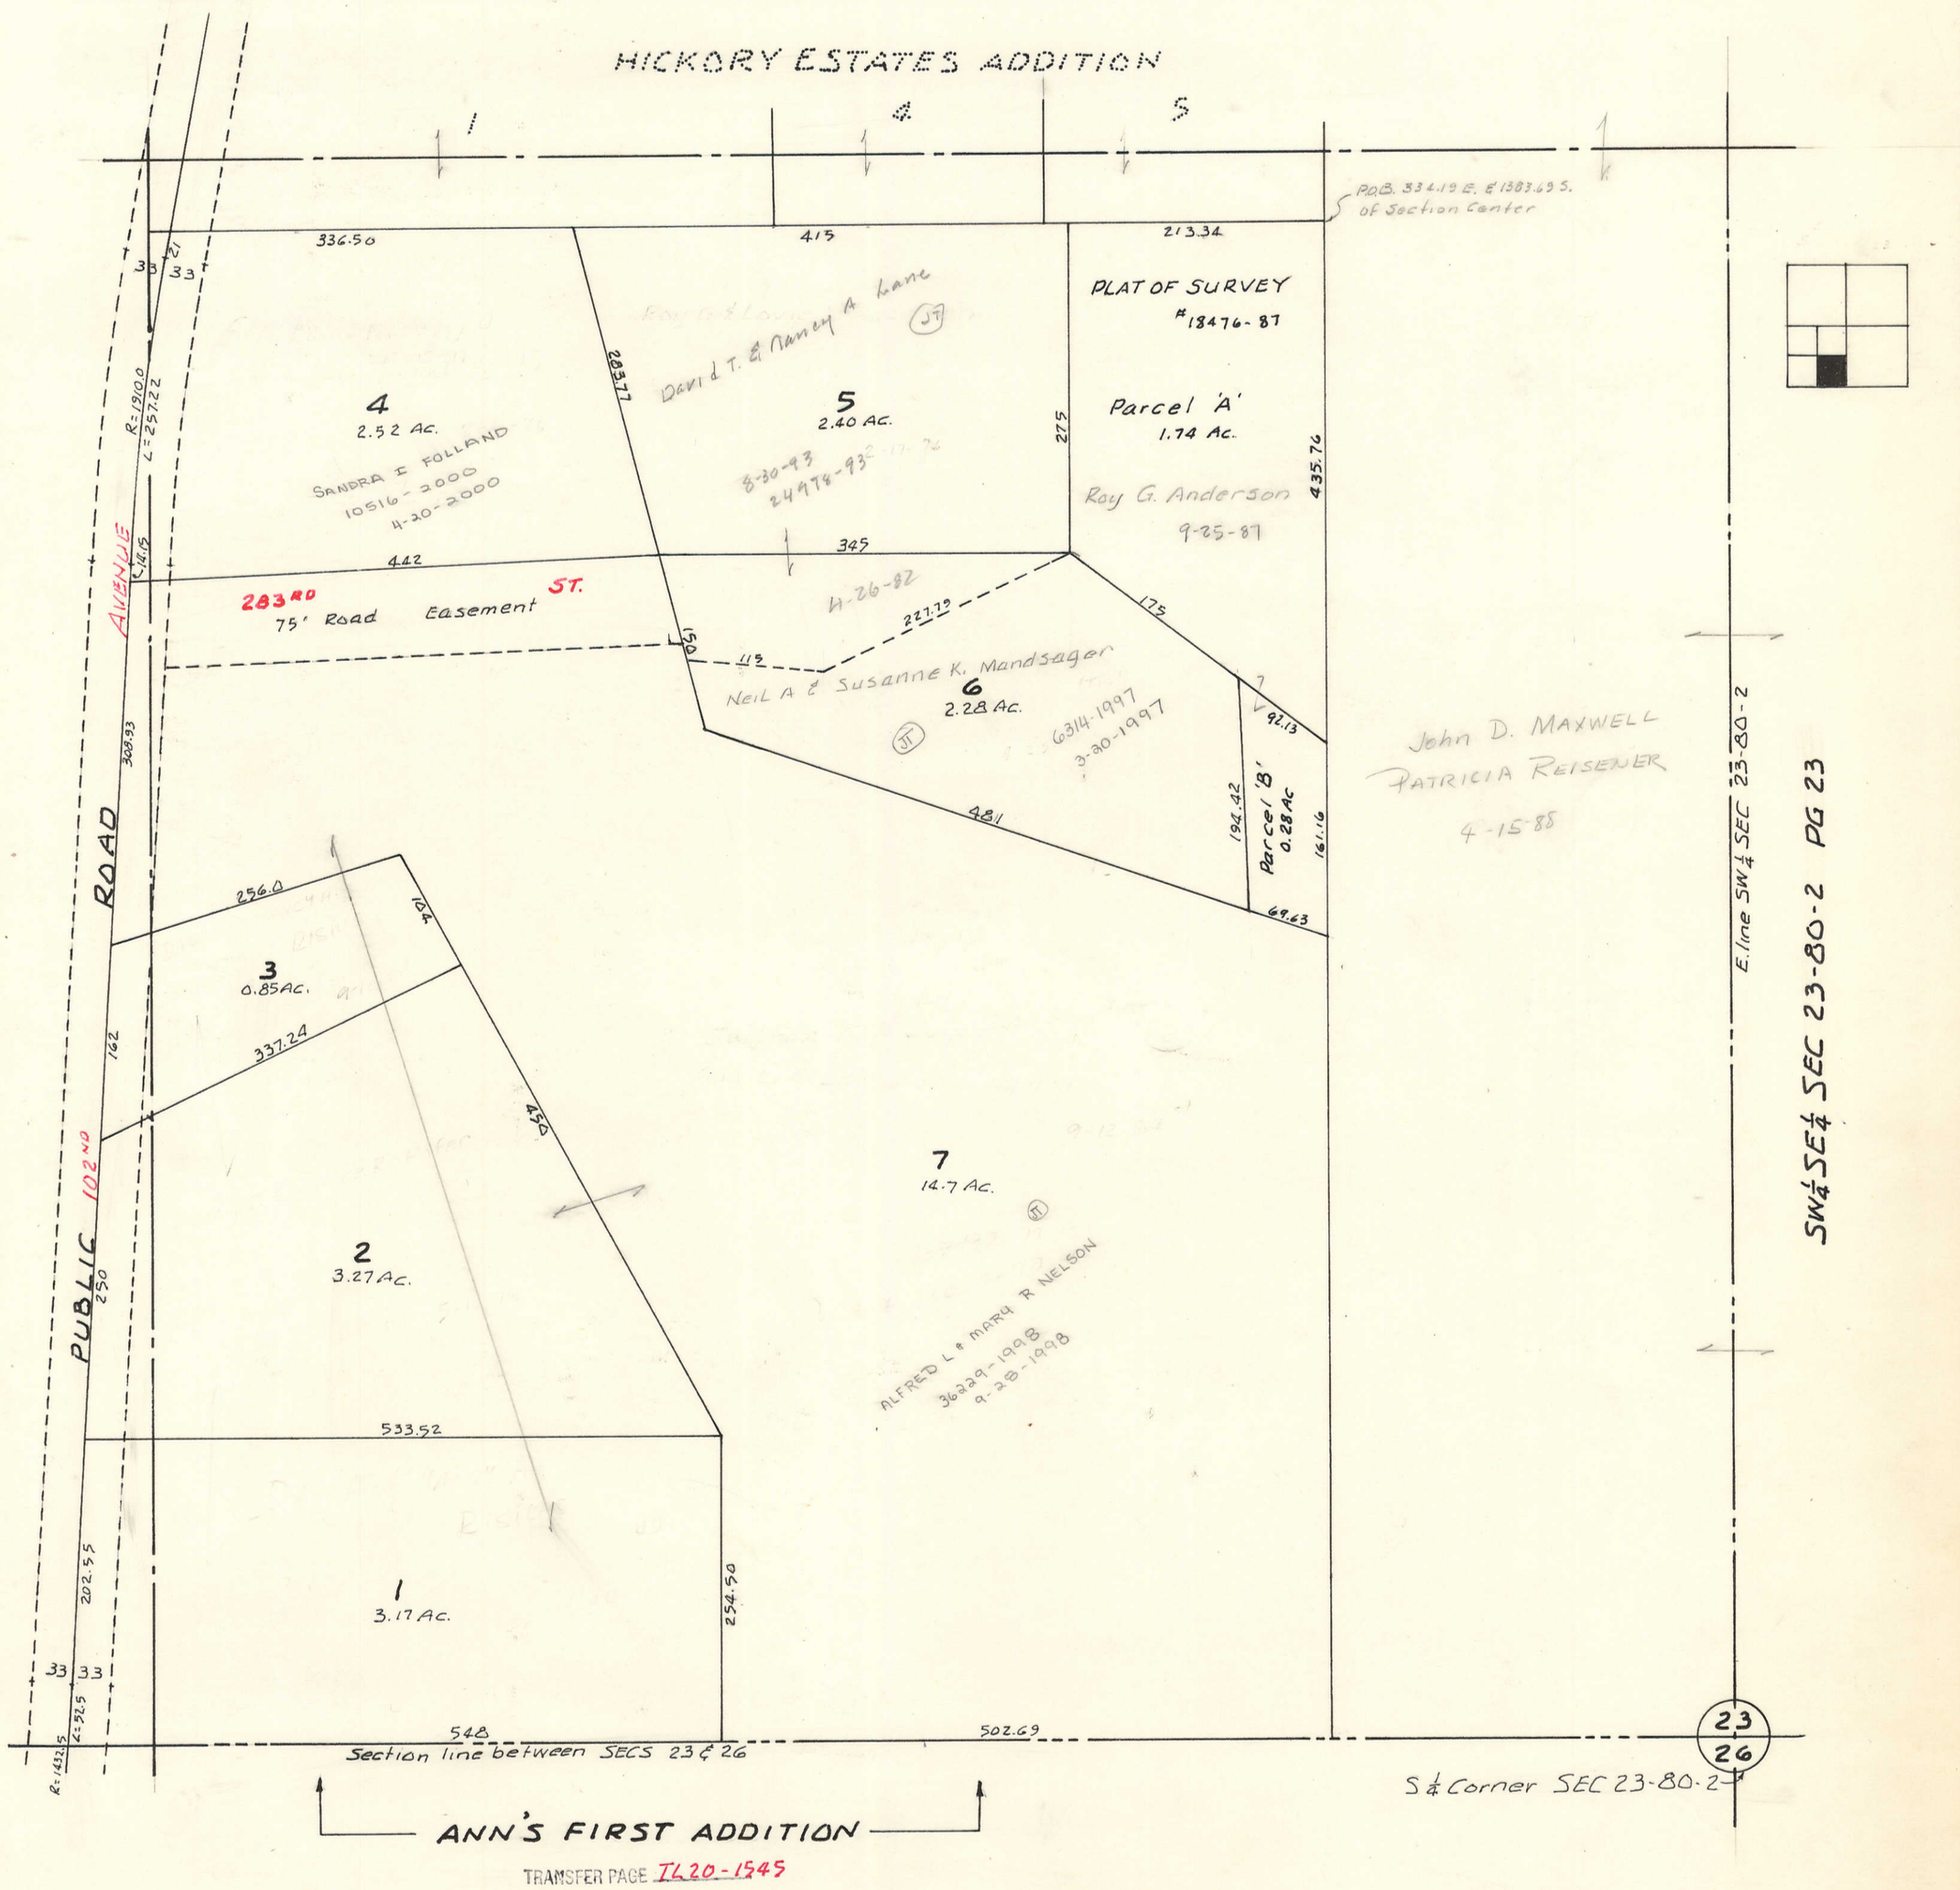


ANN'S FIRST ADDITION

TRANSFER PAGE IL20-1545

NE¼ NW¼ SEC 26-80-2 PG 26