



NE 1/4 NW 1/4 SEC 27-78-2
BLUE GRASS TOWNSHIP
SCALE: 1"=100'

SEC 22

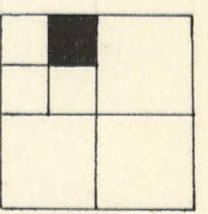

BLANKS TO:
BRADLEY & DORIS OWENS
3-13-03 12489-03

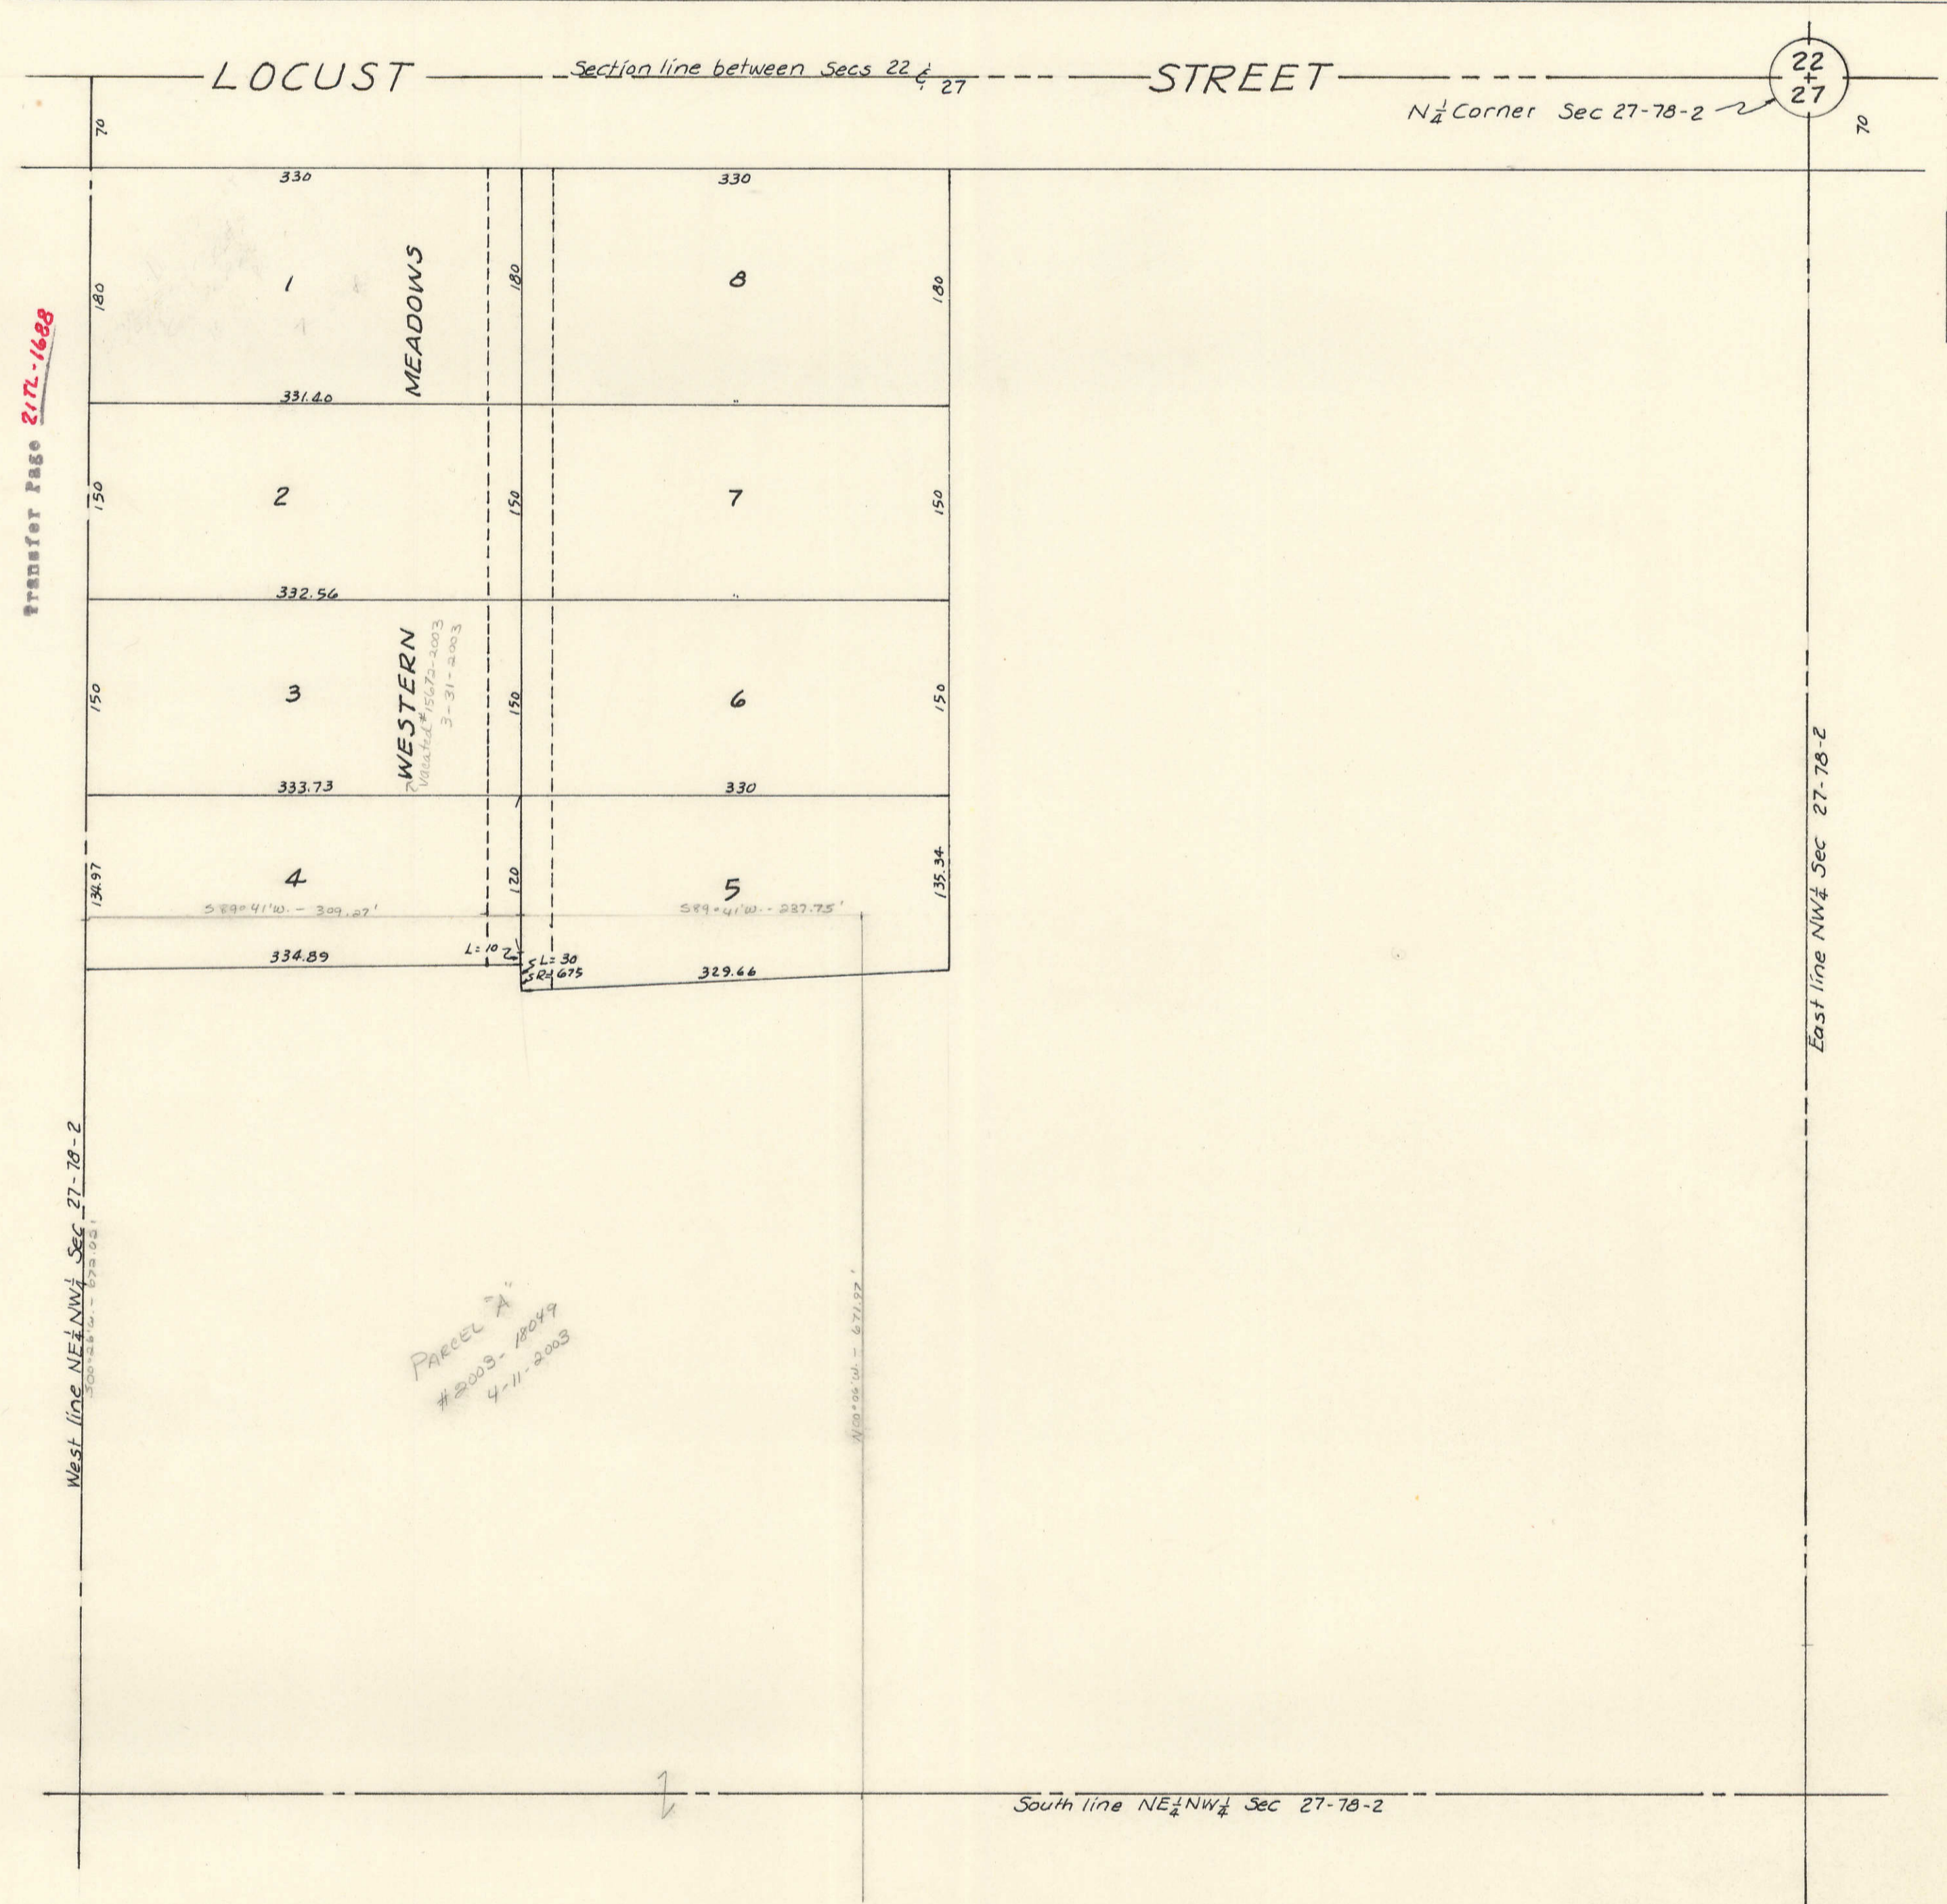


WESTERN
3-31-2003

PARCEL A
#2003-18049
4-11-2003

27.

27.

27.