


NE 1/4 SEC 1-77-2  
BUFFALO TOWNSHIP  
SCALE: 1" = 100'

1-3

TRANSFER PAGE 54-69

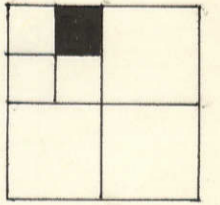



SECTION 36-78-2 BLUE GRASS TOWNSHIP

Section line between SECS 1-77-2 & 36-78-2 ROUTE U.S. 61

N. 1/4 Corner SEC 1-77-2

36

Tract A  
TRANSFER PAGE 1772-1062

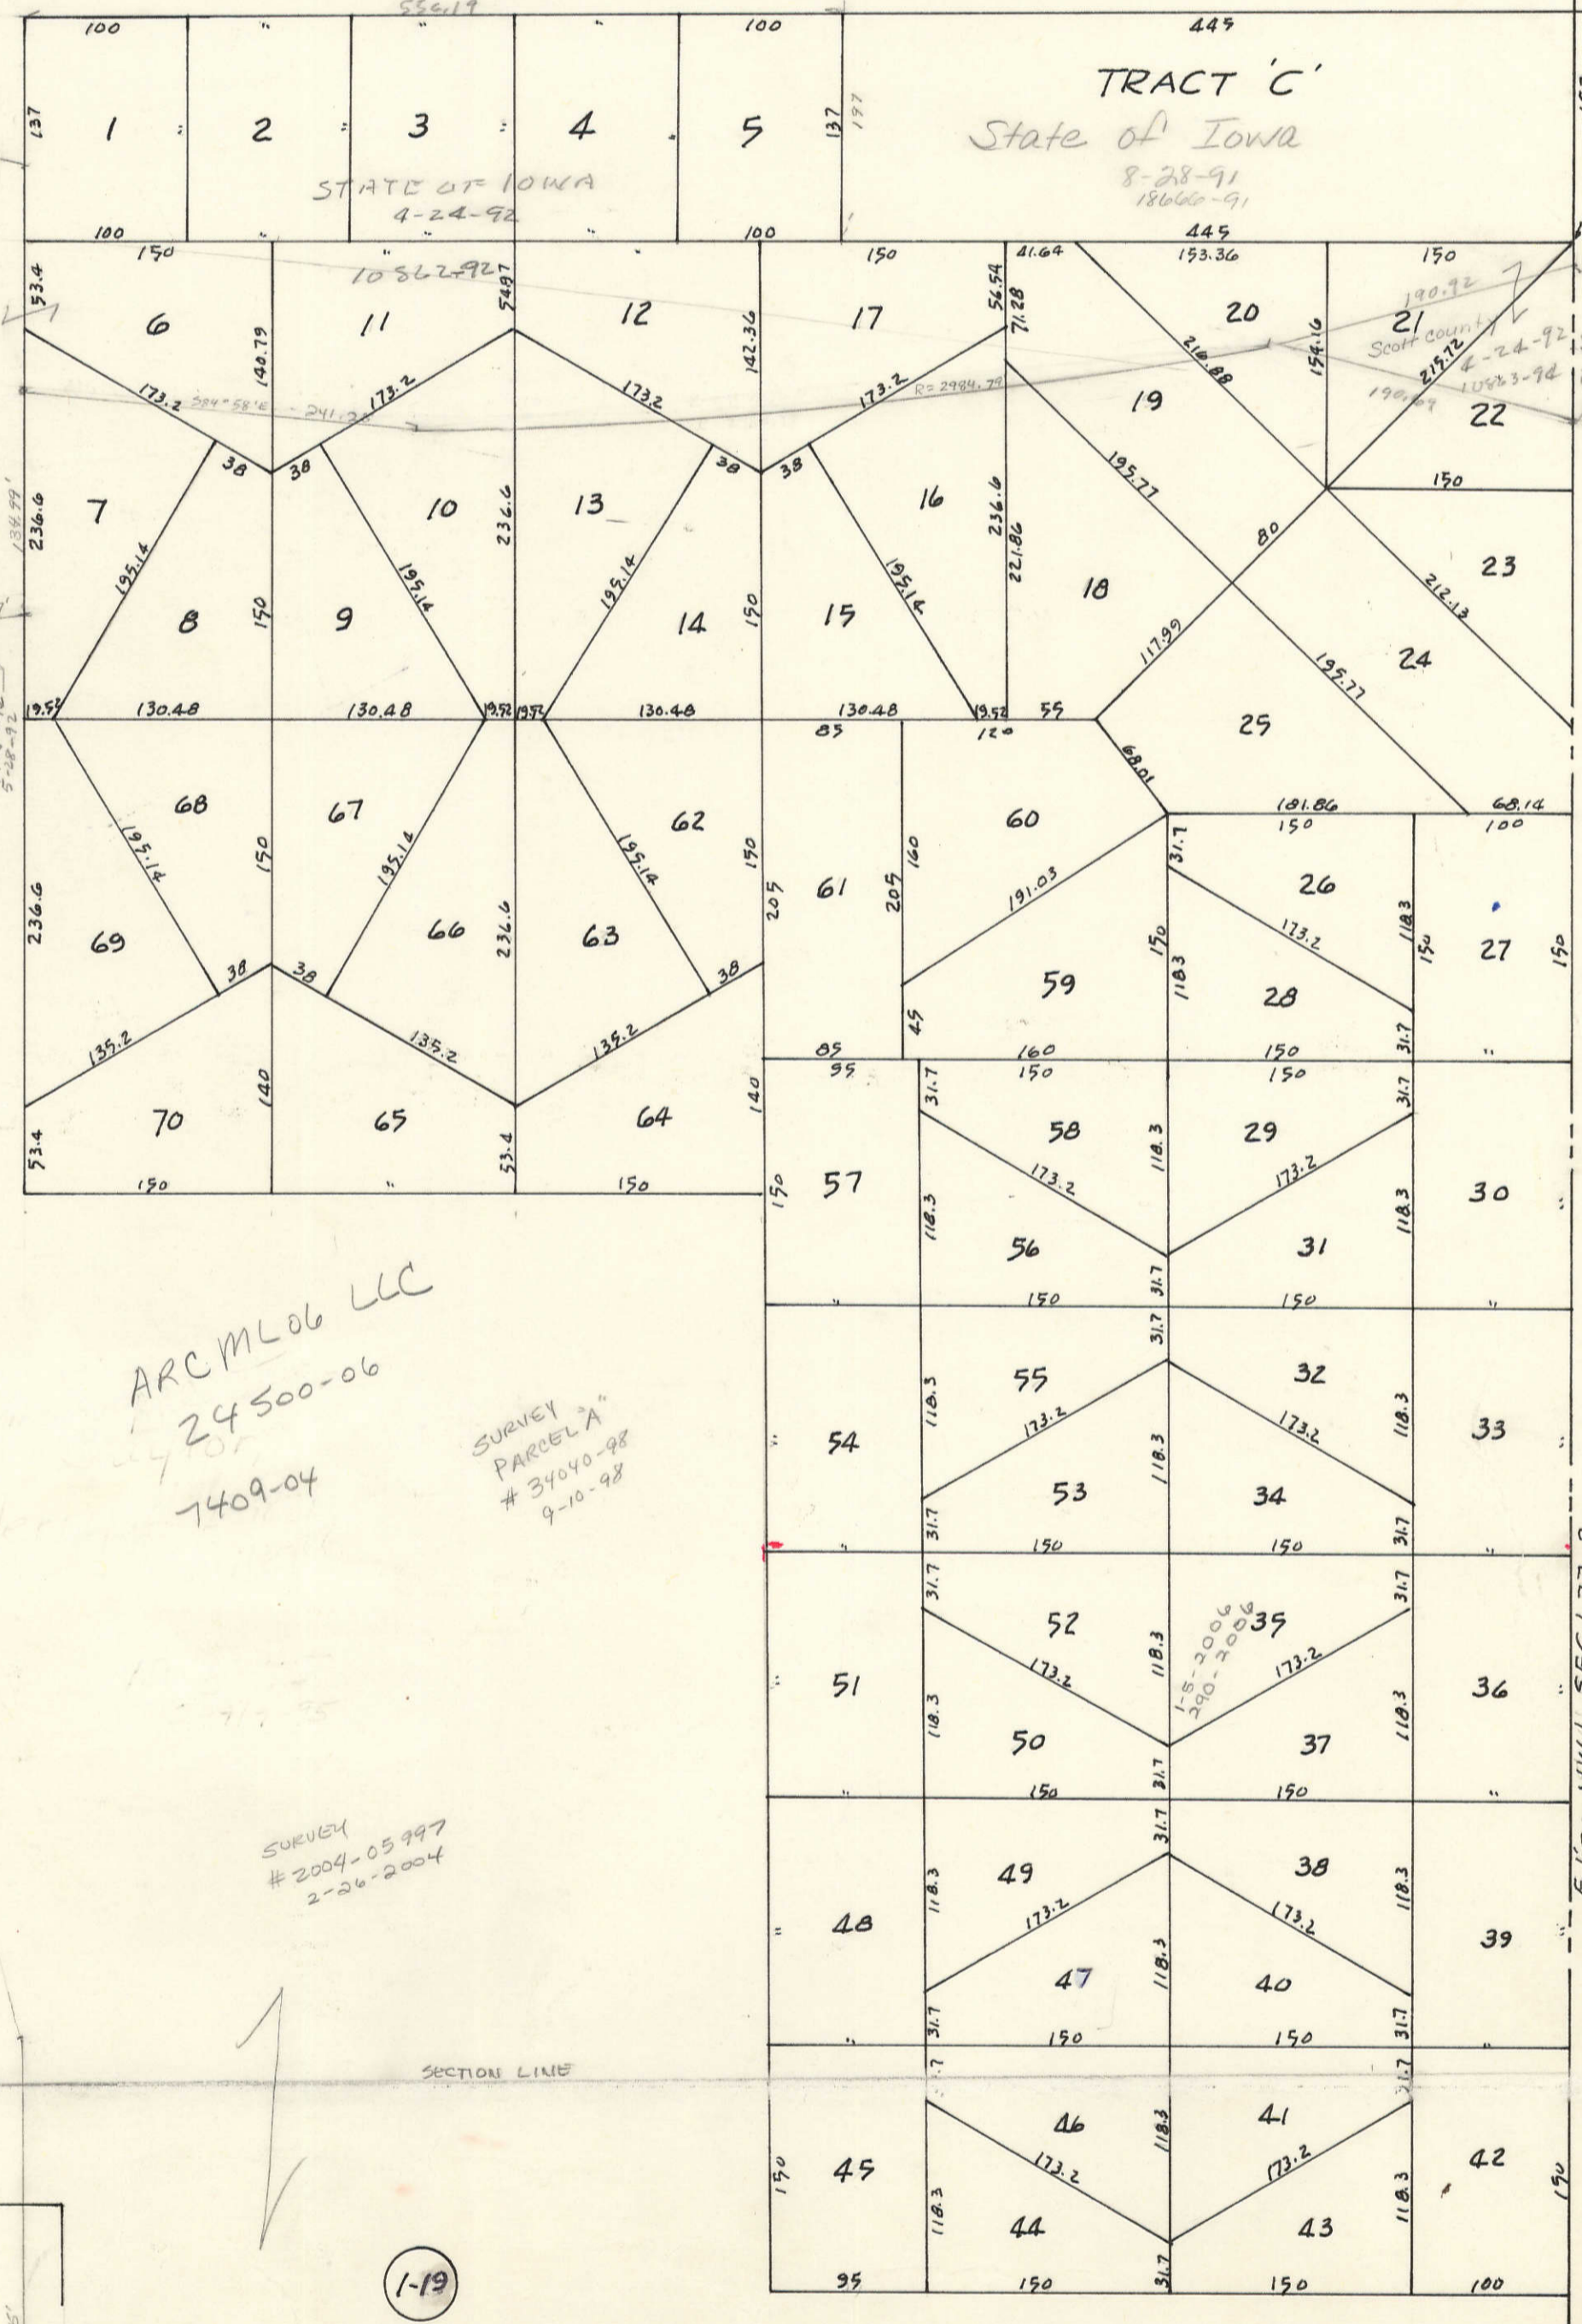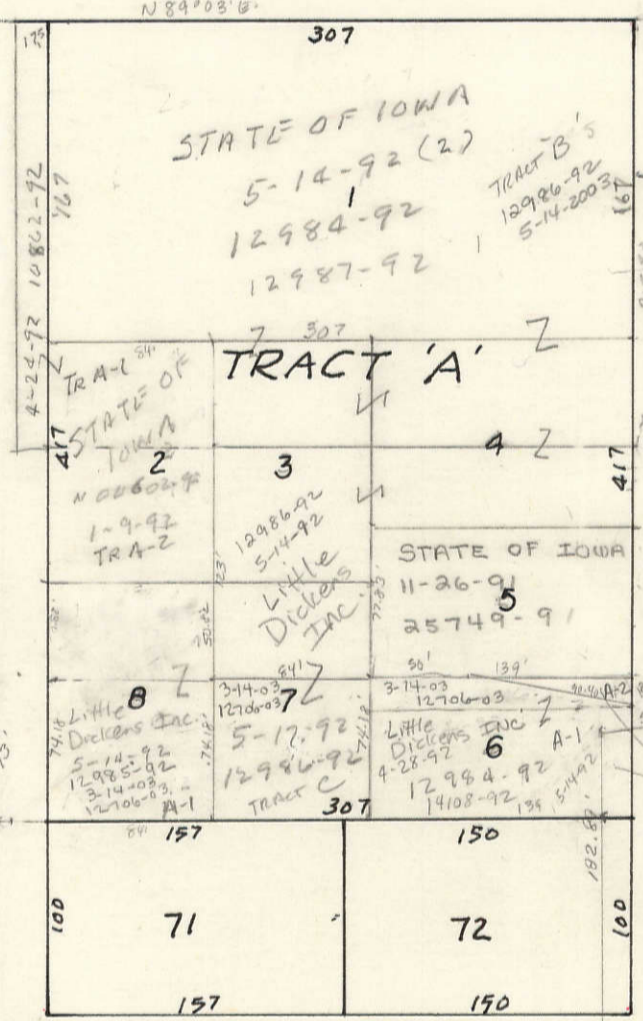

LAKE SIDE MANOR

1772-1067  
1068  
1069  
1070

SEC 1

1

1-1

100	100
73	74
75	76
77	78
79	80
81	82
83	84
100	100

Survey Parcel B  
#24040-98  
9-10-98

ARC MLO6 LLC  
24500-06  
7409-04

SURVEY PARCEL A  
#34040-98  
9-10-98

SURVEY  
#2004-05997  
2-26-2004

MNB ENTERPRISES  
6-4-2004

1-19

E line NW 1/4 SEC 1-77-2