
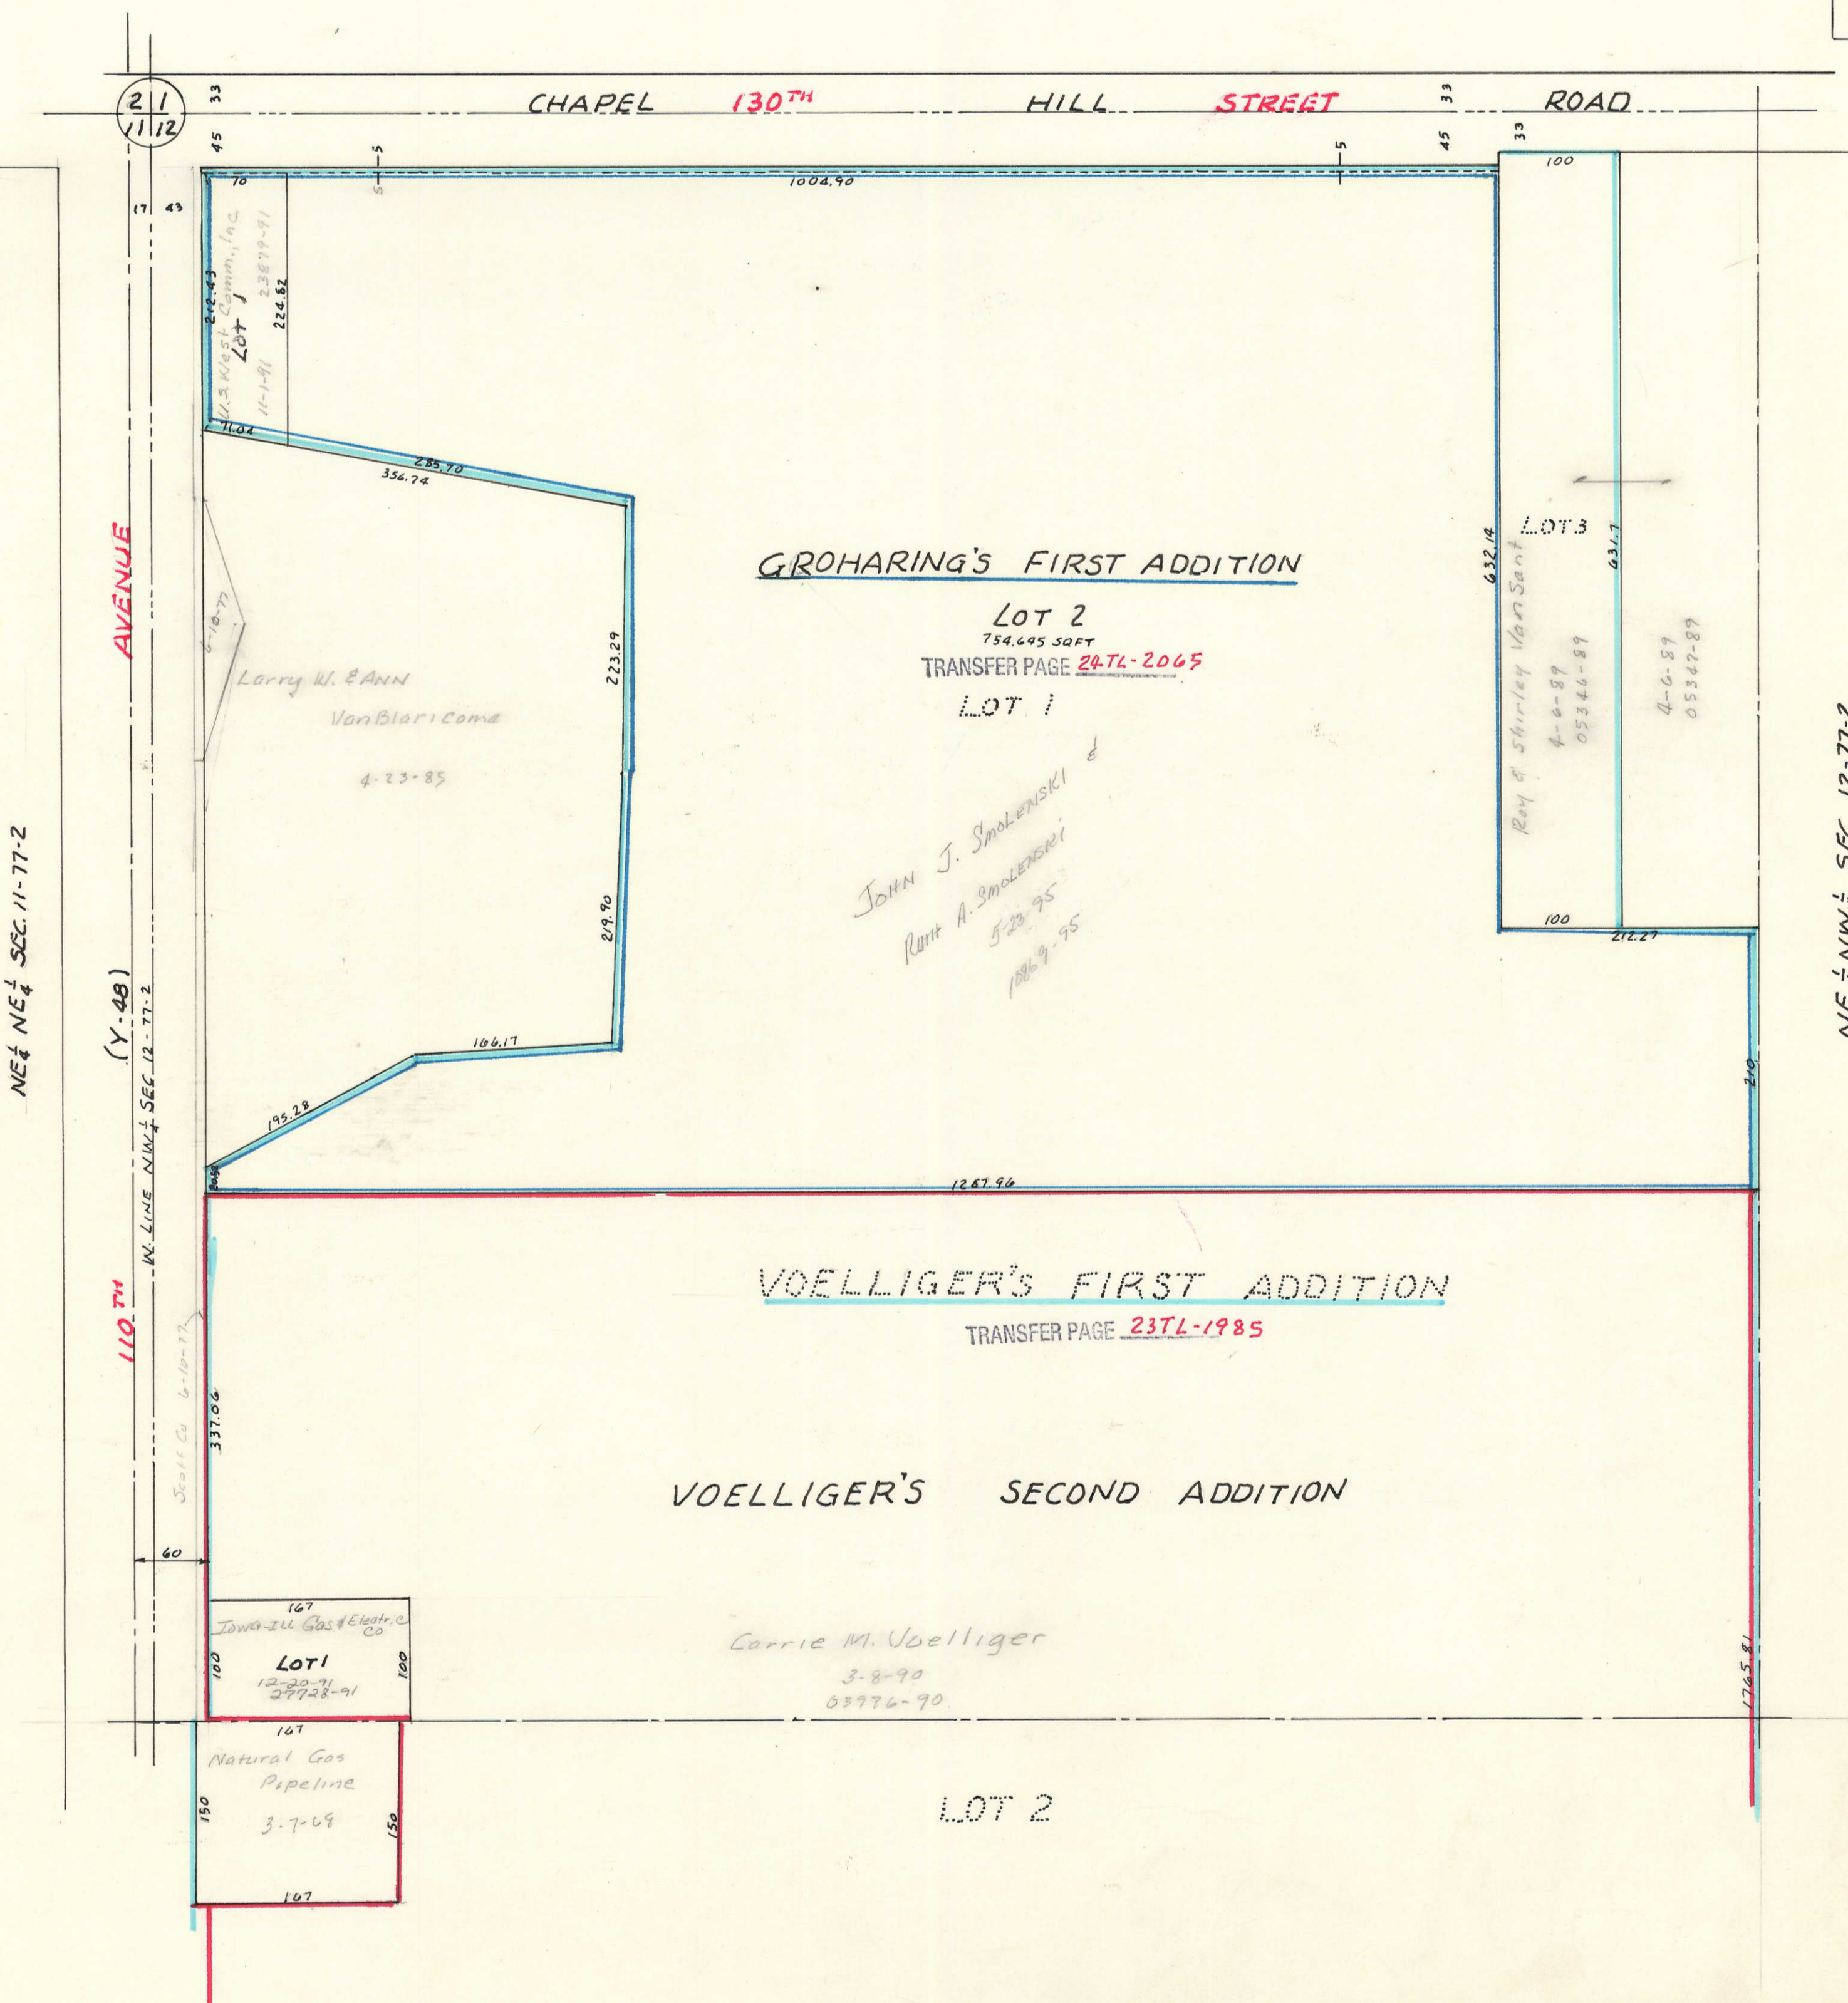


NW 1/4 NW 1/4 SEC. 12-77-2
BUFFALO TOWNSHIP
SCALE: 1 IN. = 100 FT.

TRANSFER PAGE 511-80

SW 1/4 SW 1/4 SEC. 1-77-2

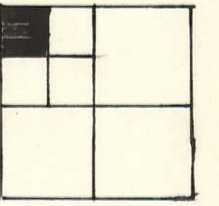

NE 1/4 NE 1/4 SEC. 11-77-2

110TH AVENUE (Y-48)
M. LINE NW 1/4 SEC. 12-77-2

NE 1/4 NW 1/4 SEC. 12-77-2

(12-17)