



NE 1/4 SE 1/4 SEC 15-77-2
BUFFALO TOWNSHIP
SCALE: 1 IN. = 100 FT.

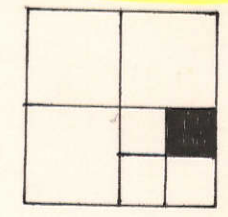

TRANSFER PAGE 51d-83

E 1/4 Corner SEC 15-77-2

15-23

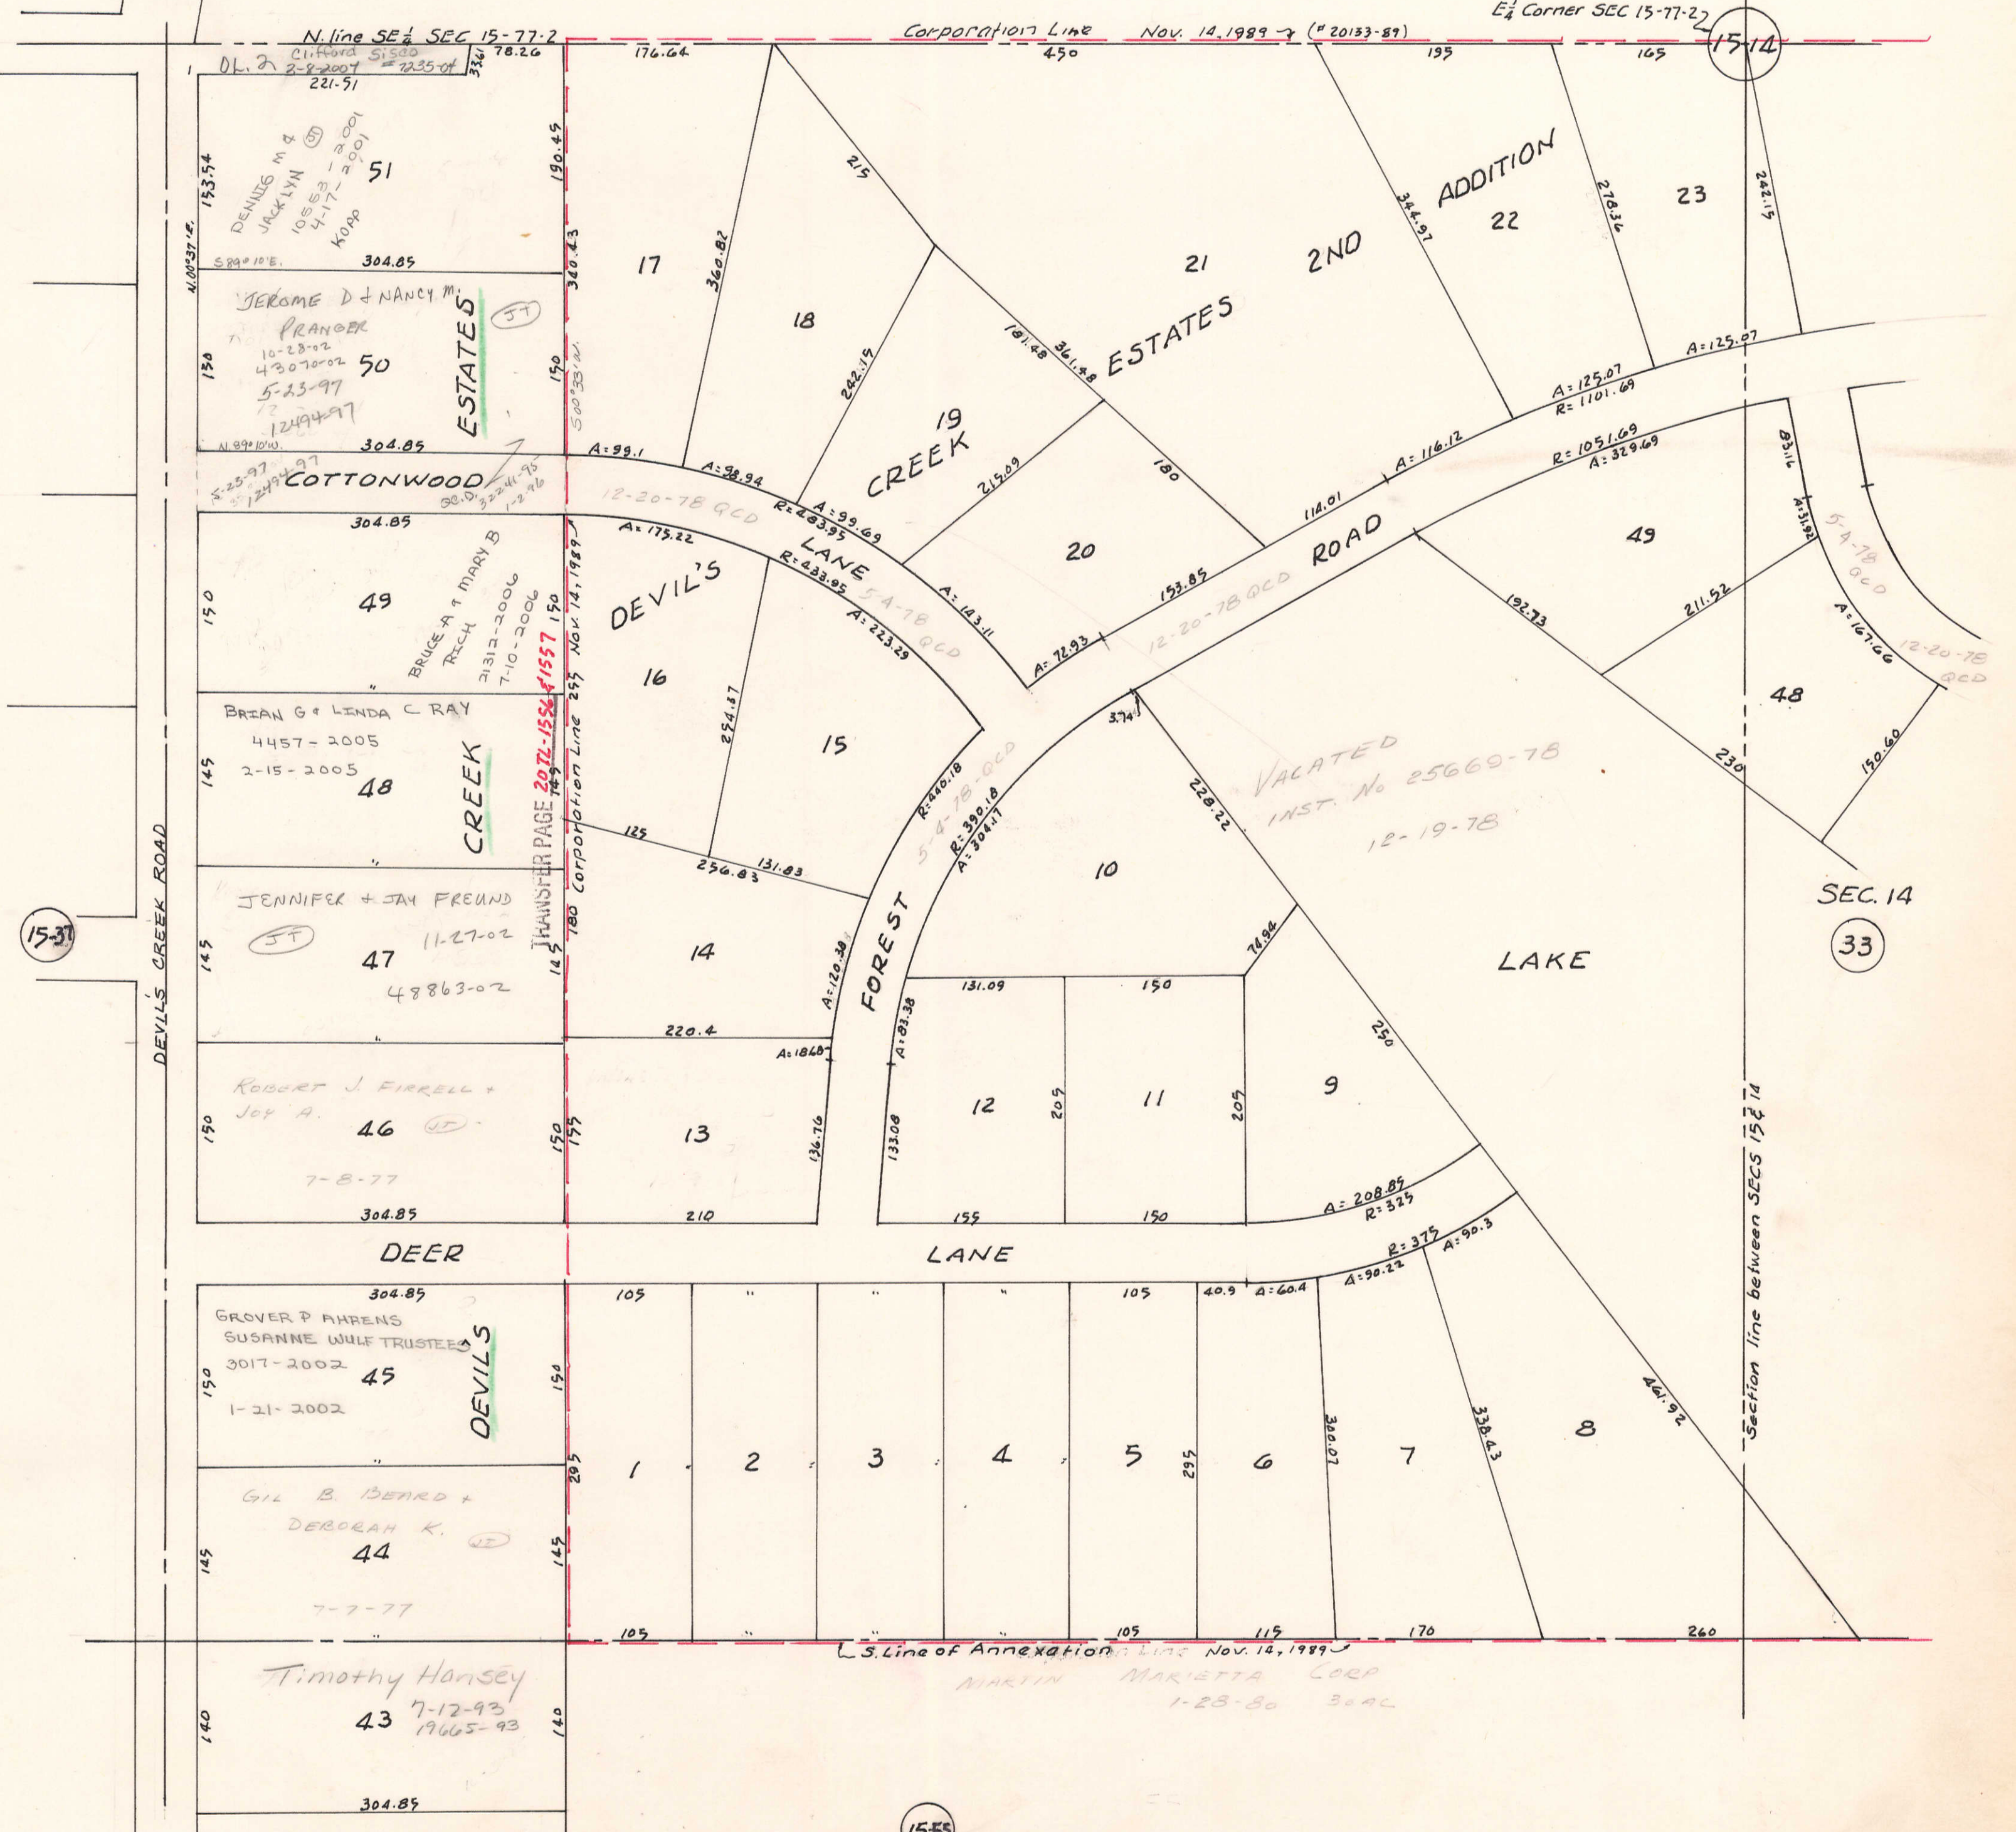

15-31

15-14

SEC. 14
33

15-55

Corporation Line Nov. 14, 1989 (# 20133-89)

L.S. Line of Annexation: Line Nov. 14, 1989
MARTIN MARIETTA CORP
1-28-80 30AC

DEVIL'S CREEK ROAD

DEVIL'S CREEK ESTATES

DEVIL'S CREEK

DEER LANE

FOREST LANE

ROAD

LAKE

VACATED
INST. No 25660-78
12-19-78

Section line between SECS 15 & 14