




SE 1/4 NE 1/4 SEC 6-80-4  
BUTLER TOWNSHIP  
SCALE: - 1" = 100'

TRANSFER PAGE 544s-98

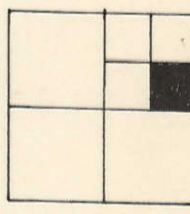

TRANSFER PAGE 171L 807(1-30) 808(31-60) 809(61-89) 6-7

IDLE HOUR REST ADDITION

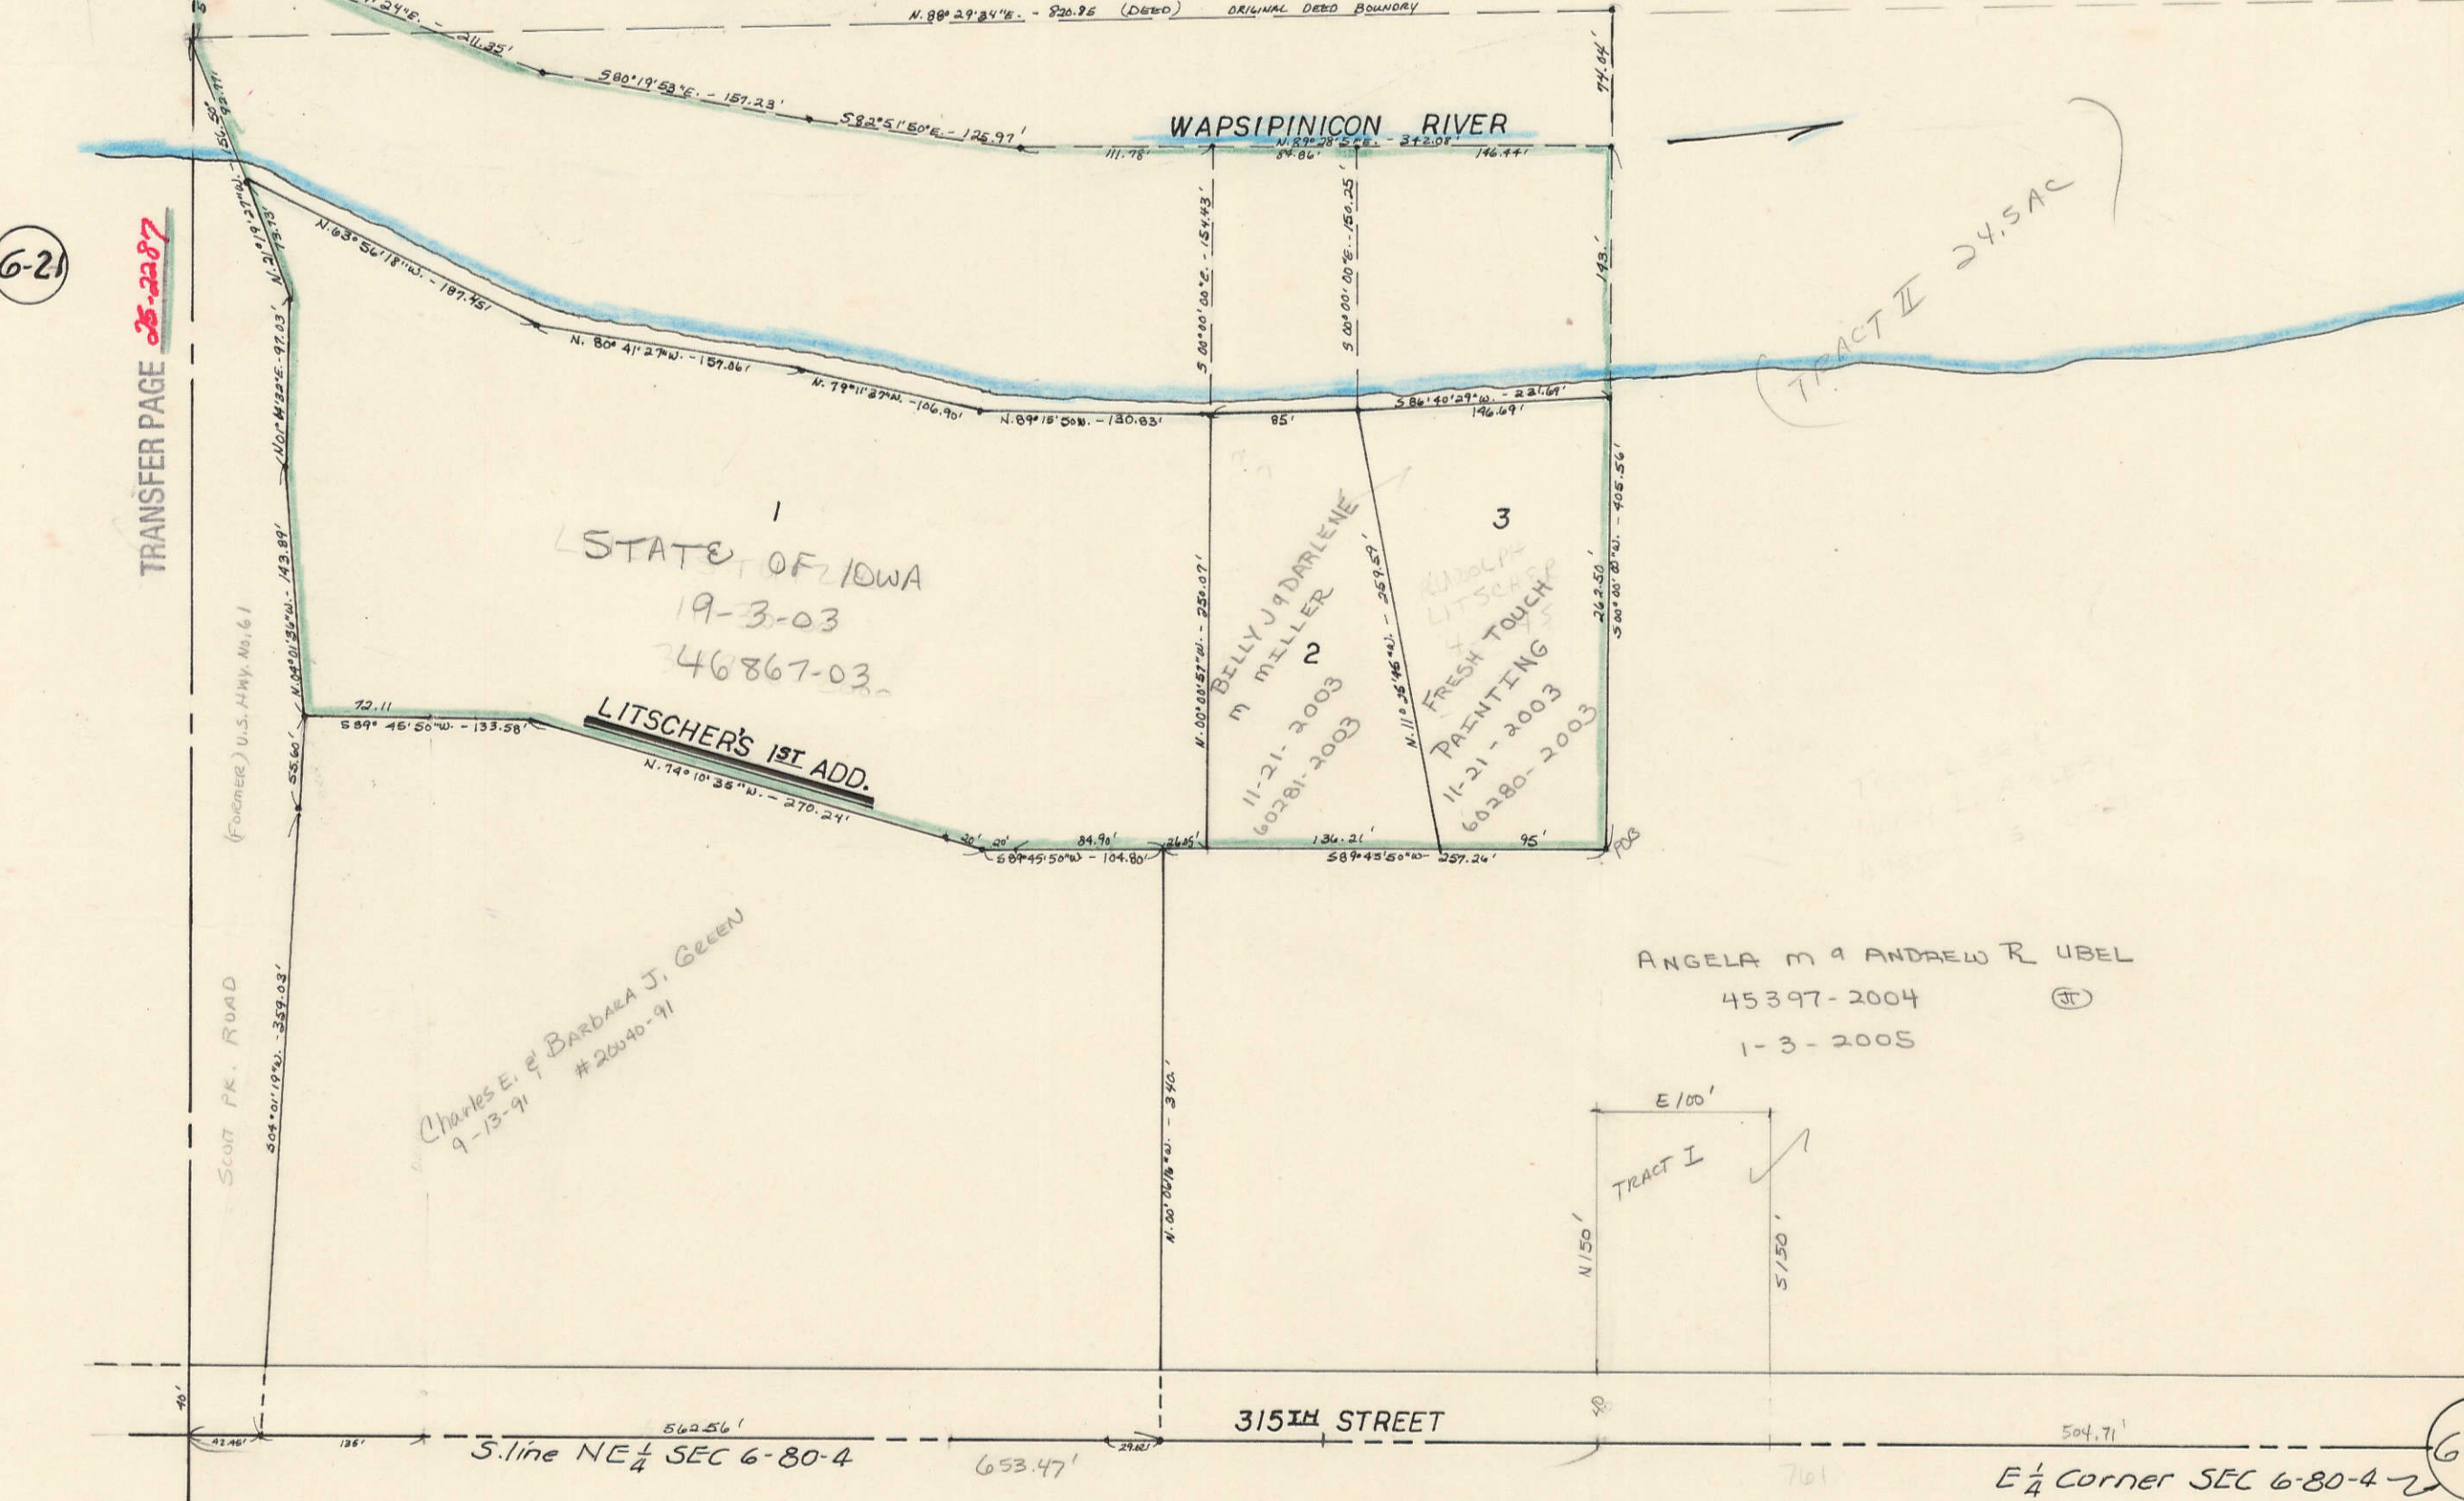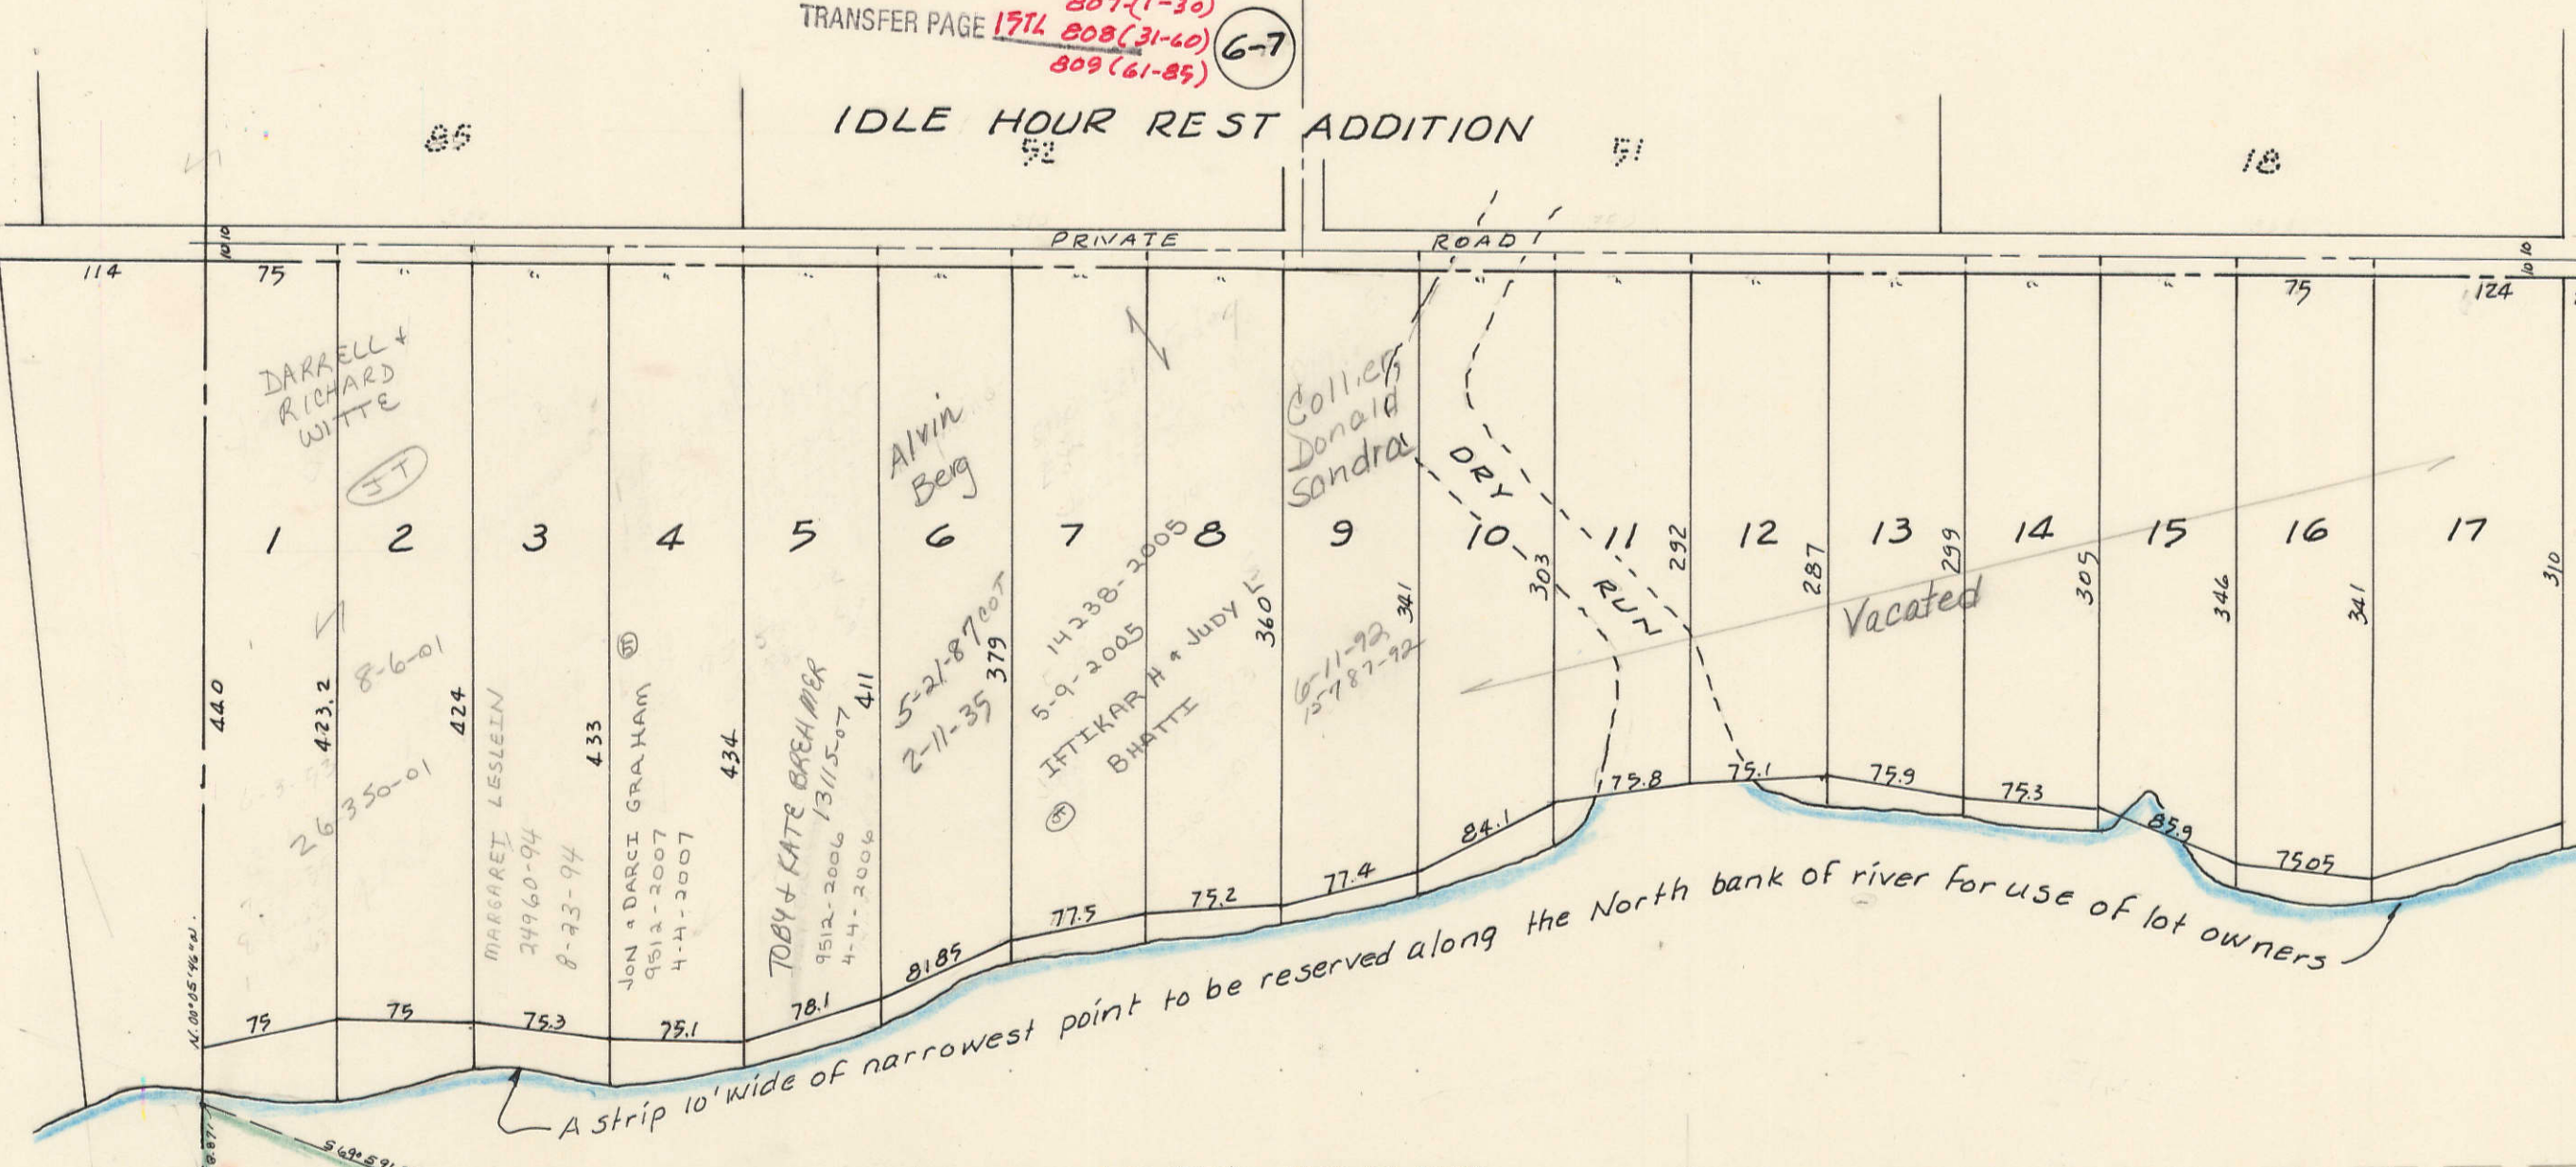

6-21  
TRANSFER PAGE 28-2287

SEC 5  
5  
SW 1/4 NW 1/4

SEC 6  
6  
NE 1/4 SE 1/4

6-5