


SECTION 28

SCALE IN CHAINS

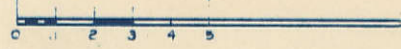

Township 80-North; Range 4

EAST OF THE FIFTH PRINCIPAL MERIDIAN

SCOTT COUNTY, IOWA


BUTLER TOWNSHIP

SCALE IN FEET



NORTH SECTION 21

Transfer Page 52d-120

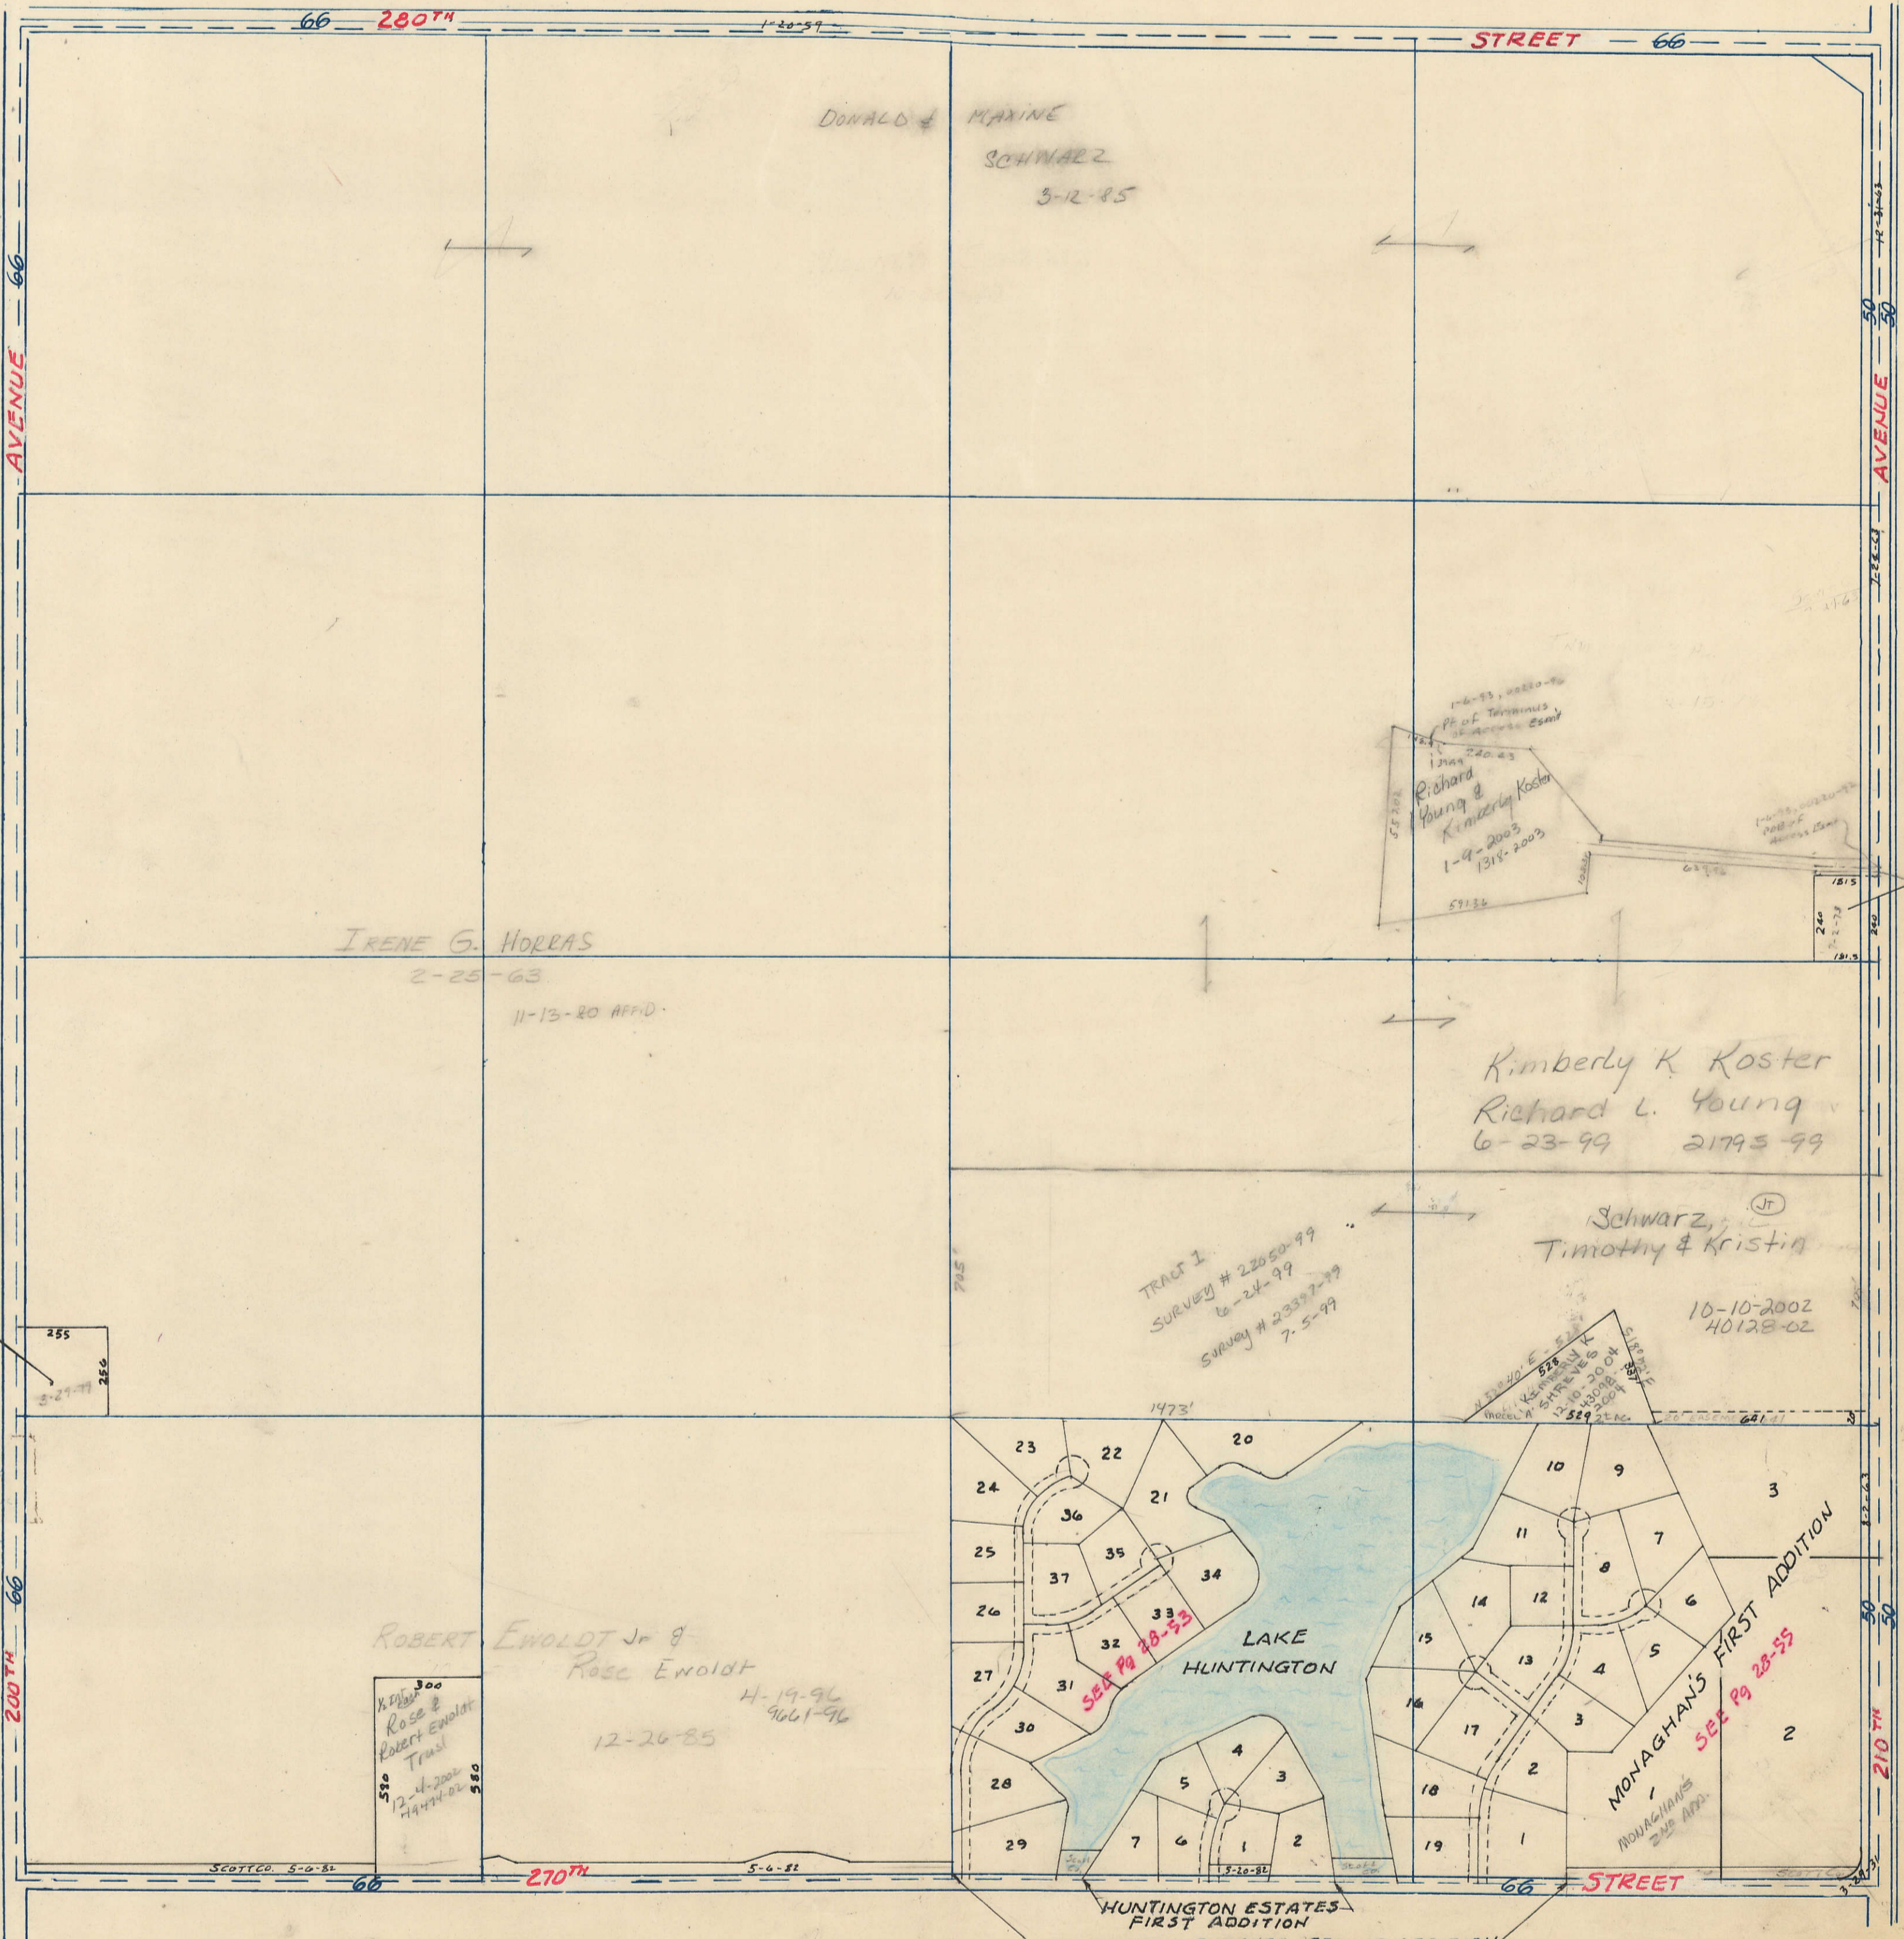

SOUTH SECTION 33

HUNTINGTON ESTATES FIRST ADDITION
HUNTINGTON ESTATES SECOND ADDITION

SECTION 29

SECTION 27 EAST

ROBERT EWOLDT JR &
Rose Ewaldt
4-19-96
12-26-85

Kimberly K Koster
Richard L. Young

Schwarz, Jr
Timothy & Kristin
10-10-2002
40128-02

TRACT 1
SURVEY # 22050-99
6-24-99
SURVEY # 23397-99
7-5-99



HUNTINGTON ESTATES FIRST ADDITION
HUNTINGTON ESTATES SECOND ADDITION

Dennis F & Betty F Anderson