

SECTION 8

Township 80-North; Range 4

EAST OF THE FIFTH PRINCIPAL MERIDIAN

SCOTT COUNTY, IOWA

BUTLER TOWNSHIP

SCALE IN CHAINS



SCALE IN FEET




Transfer Page 5W-100

NORTH SECTION 5

SECTION 7 WEST

SECTION 9 EAST

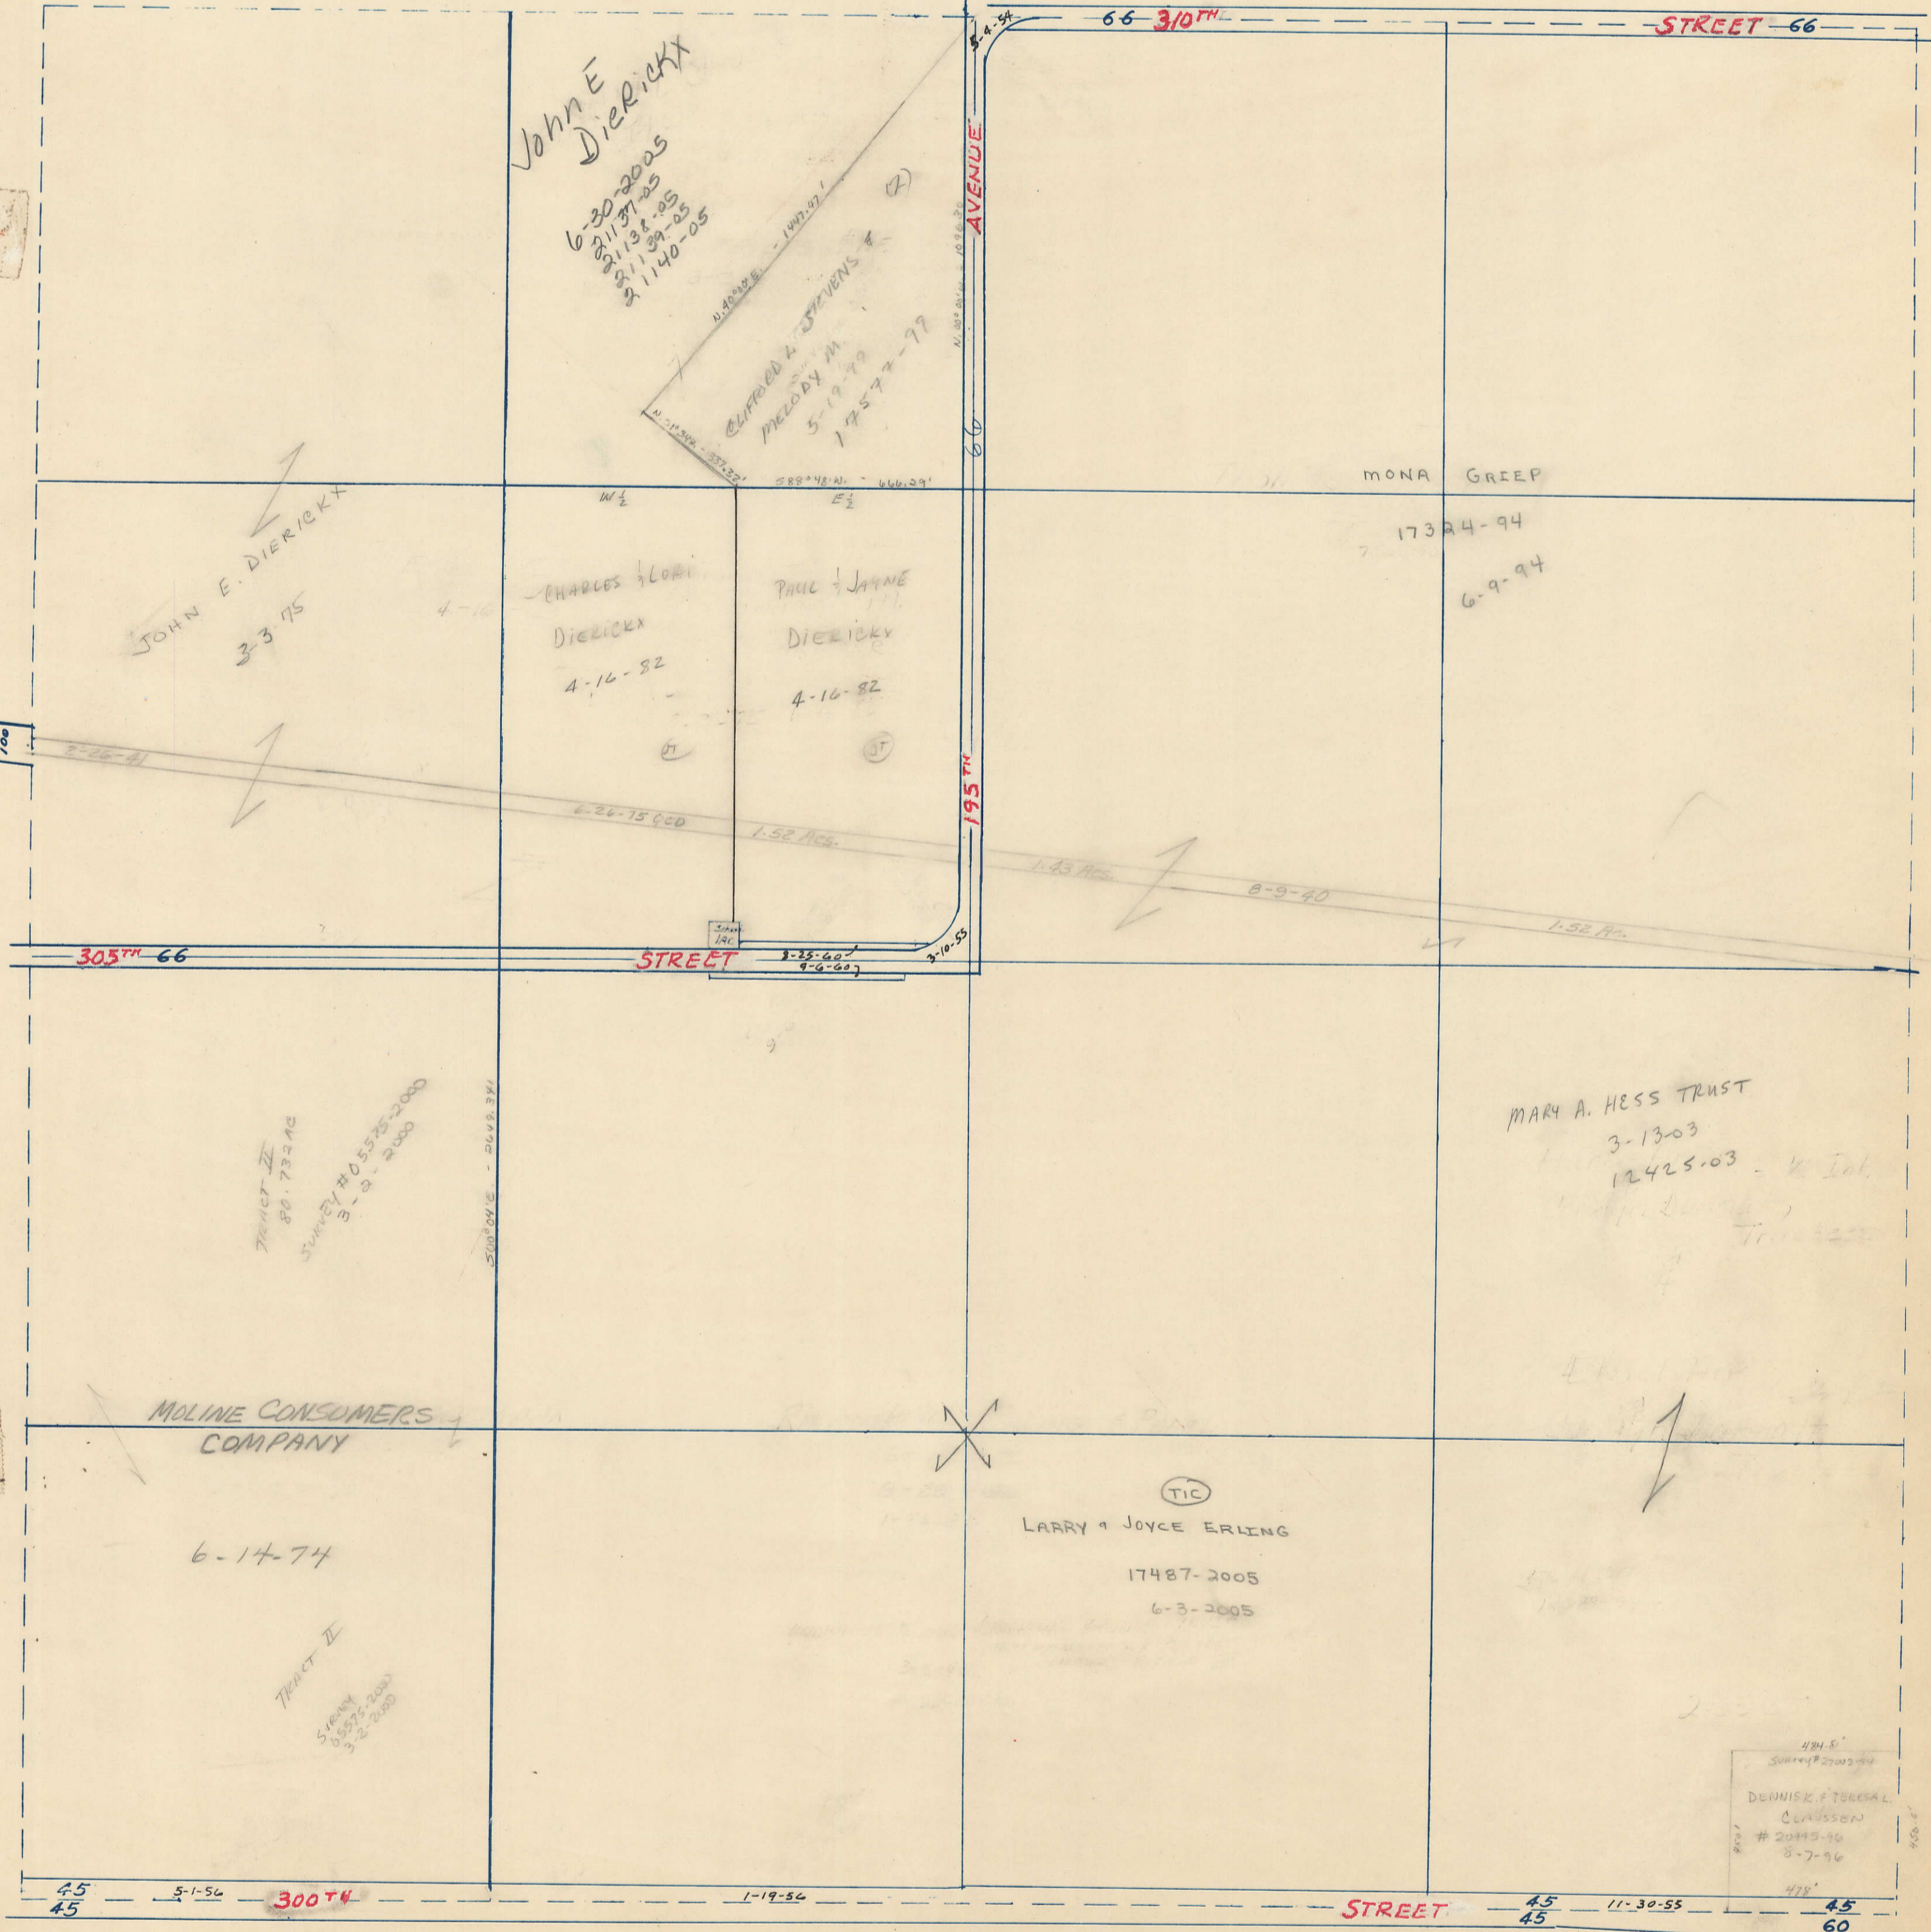

SOUTH SECTION 17