


SEC. 33

NW 1/4, NE 1/4 SEC. 4-78-5
TOWN OF LECLAIRE
SCALE: 1"=100'

Corporate Limits
WISCONSIN STREET
Section line between SEC 4-78-5 & 33-78-5
8-25-69

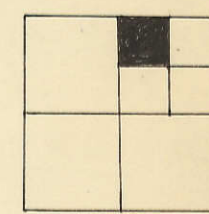


Lois A. Schurr - 1/2 Int
William Schurr - 1/2 Int

10-25-93
31701-93

3-27-84

3

7

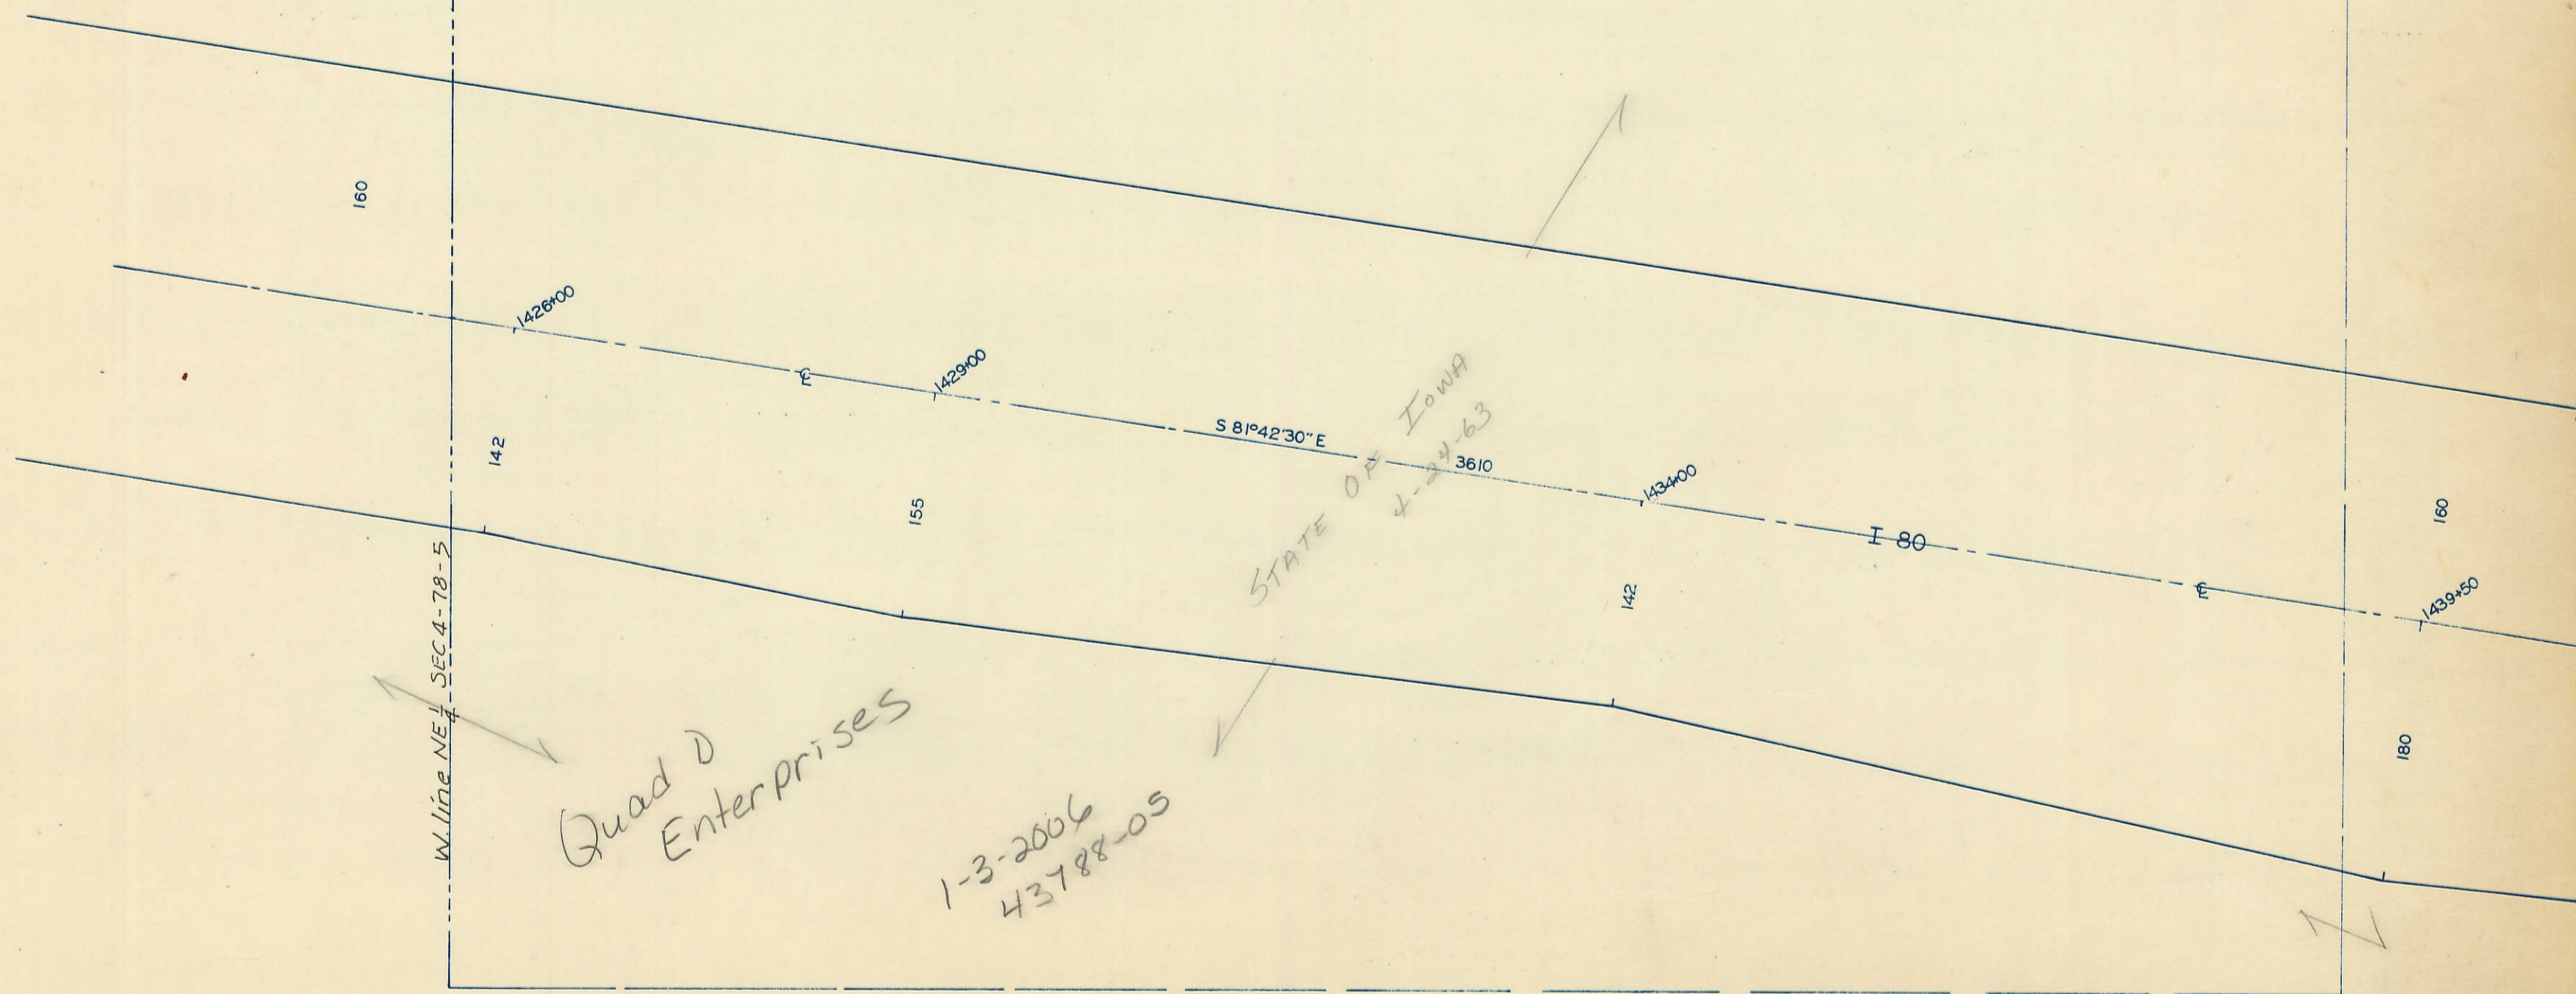

Quad D Enterprises

1-3-2006
43788-05

21