

NW 1/4, SW 1/4 SEC. 4-78-5
TOWN OF LE CLAIRE
SCALE: 1"=100'

SEC. 5

*Joe owner
See pg 39
Sec 5*

*BLANKS TO
Country Club
EAST
2003-1395
3-18-2003*

*1310.60
line between SECS. 4 & 5*

Pebble Creek Golf Course

*116
5-27-2005
16703-05*


Pebble Creek Golf

*5-27-2005
16704-05*

*Pebble Creek Golf Course
4-7-2006
10472-06*

*41891-04
12-2-2004*

*BETTY HOLLAND CLAUSSEN
6-26-81
11-3-89 WD
119244-89*

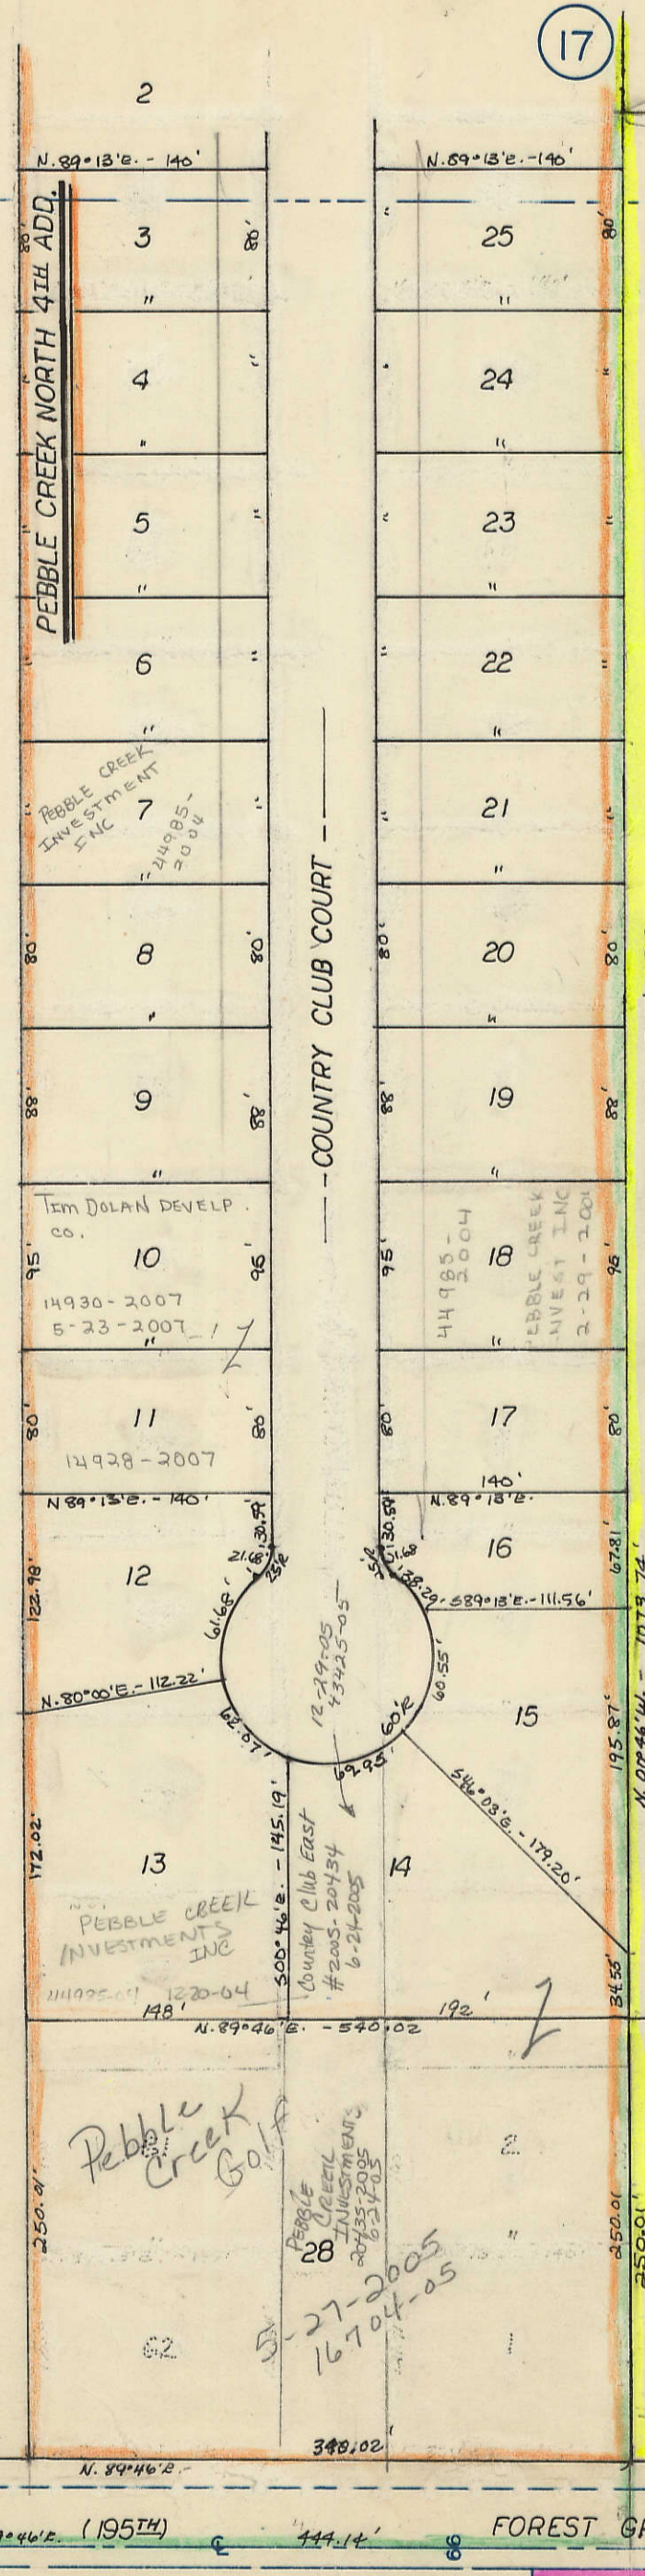

17

35