

SW 1/4, SW 1/4 SEC. 3-78-5
TOWN OF LE CLAIRE
SCALE: 1"=100'

33


SEC 4

55

TRANSFER PAGE 25A-242

51

HOLLOWES OF RIVER BEND 3RD ADDN

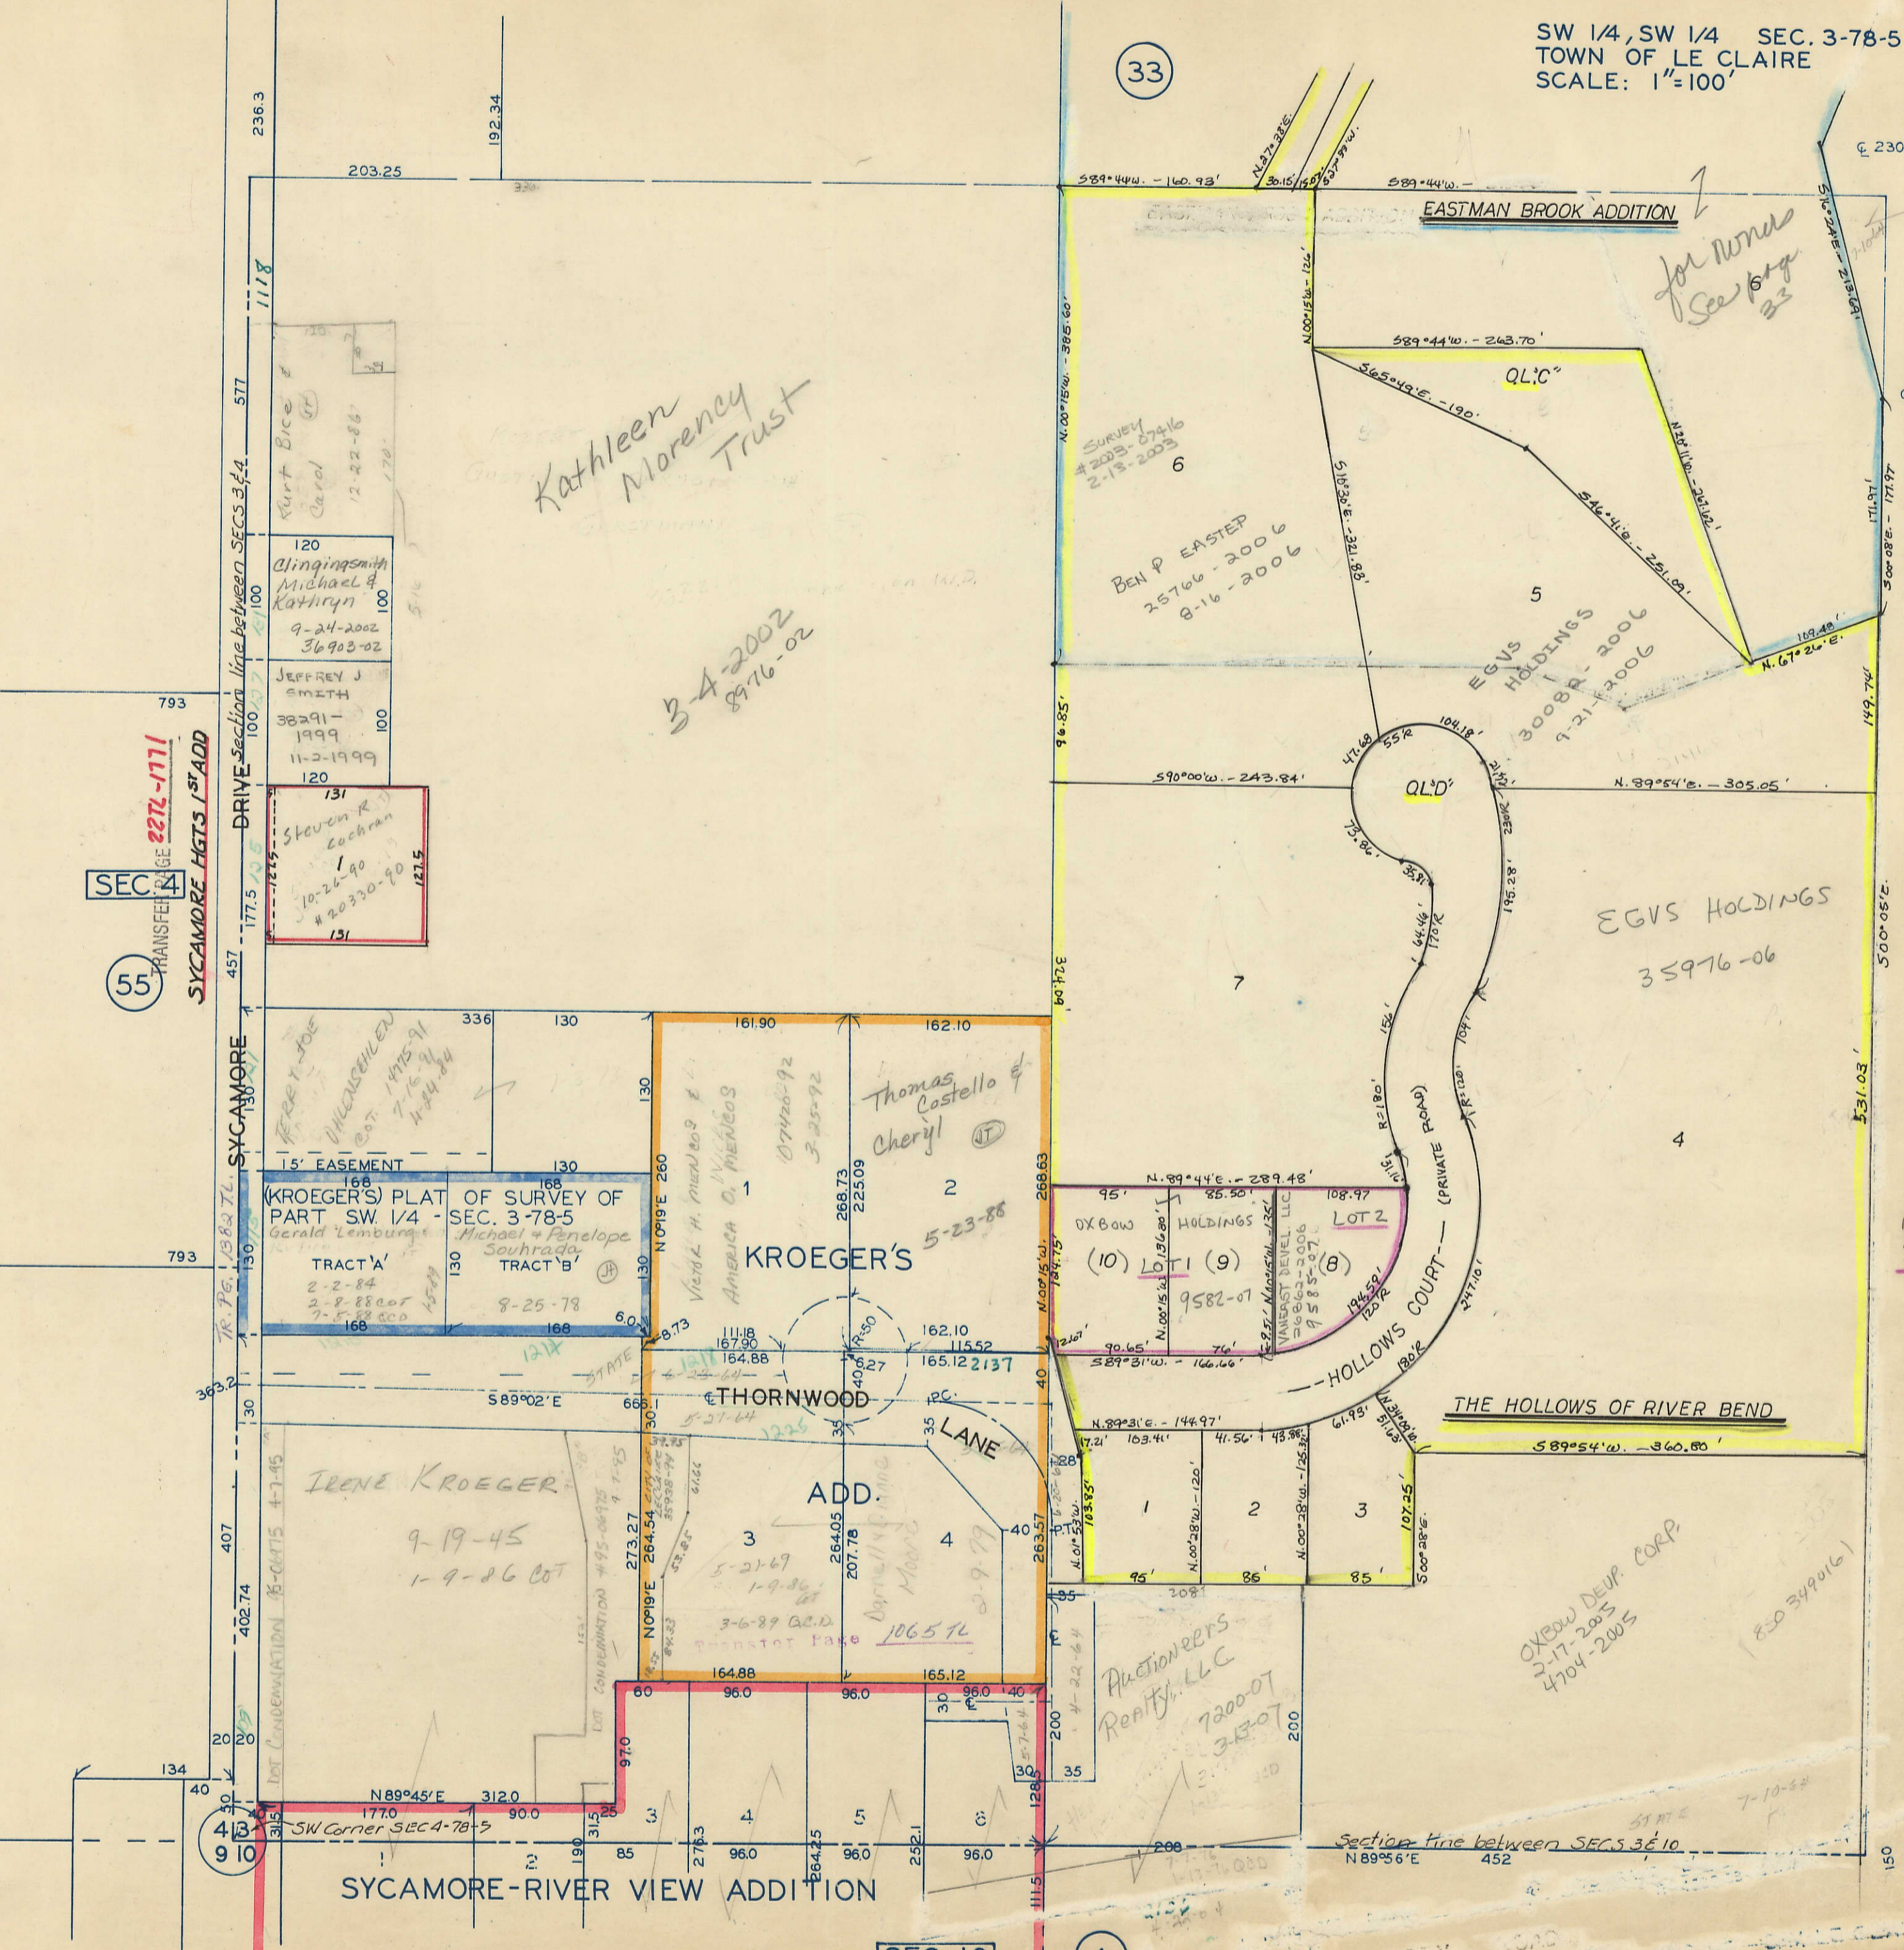

TRANSFER PAGE 227L-1711
SYCAMORE HIGTS 1ST ADD

DRIVE Section line between SECS 3 & 4

TR. PG. 1583 TL. SYCAMORE

DOT CONDEMNATION 15-CARTS 4-7-45
DOT CONDEMNATION 495-0478 4-7-45

SYCAMORE-RIVER VIEW ADDITION

SEC. 10

1

Section line between SECS 3 & 10

COPY