


NW 1/4, NW 1/4 SEC. 10-78-5  
TOWN OF LE CLAIRE  
SCALE: 1" = 100'

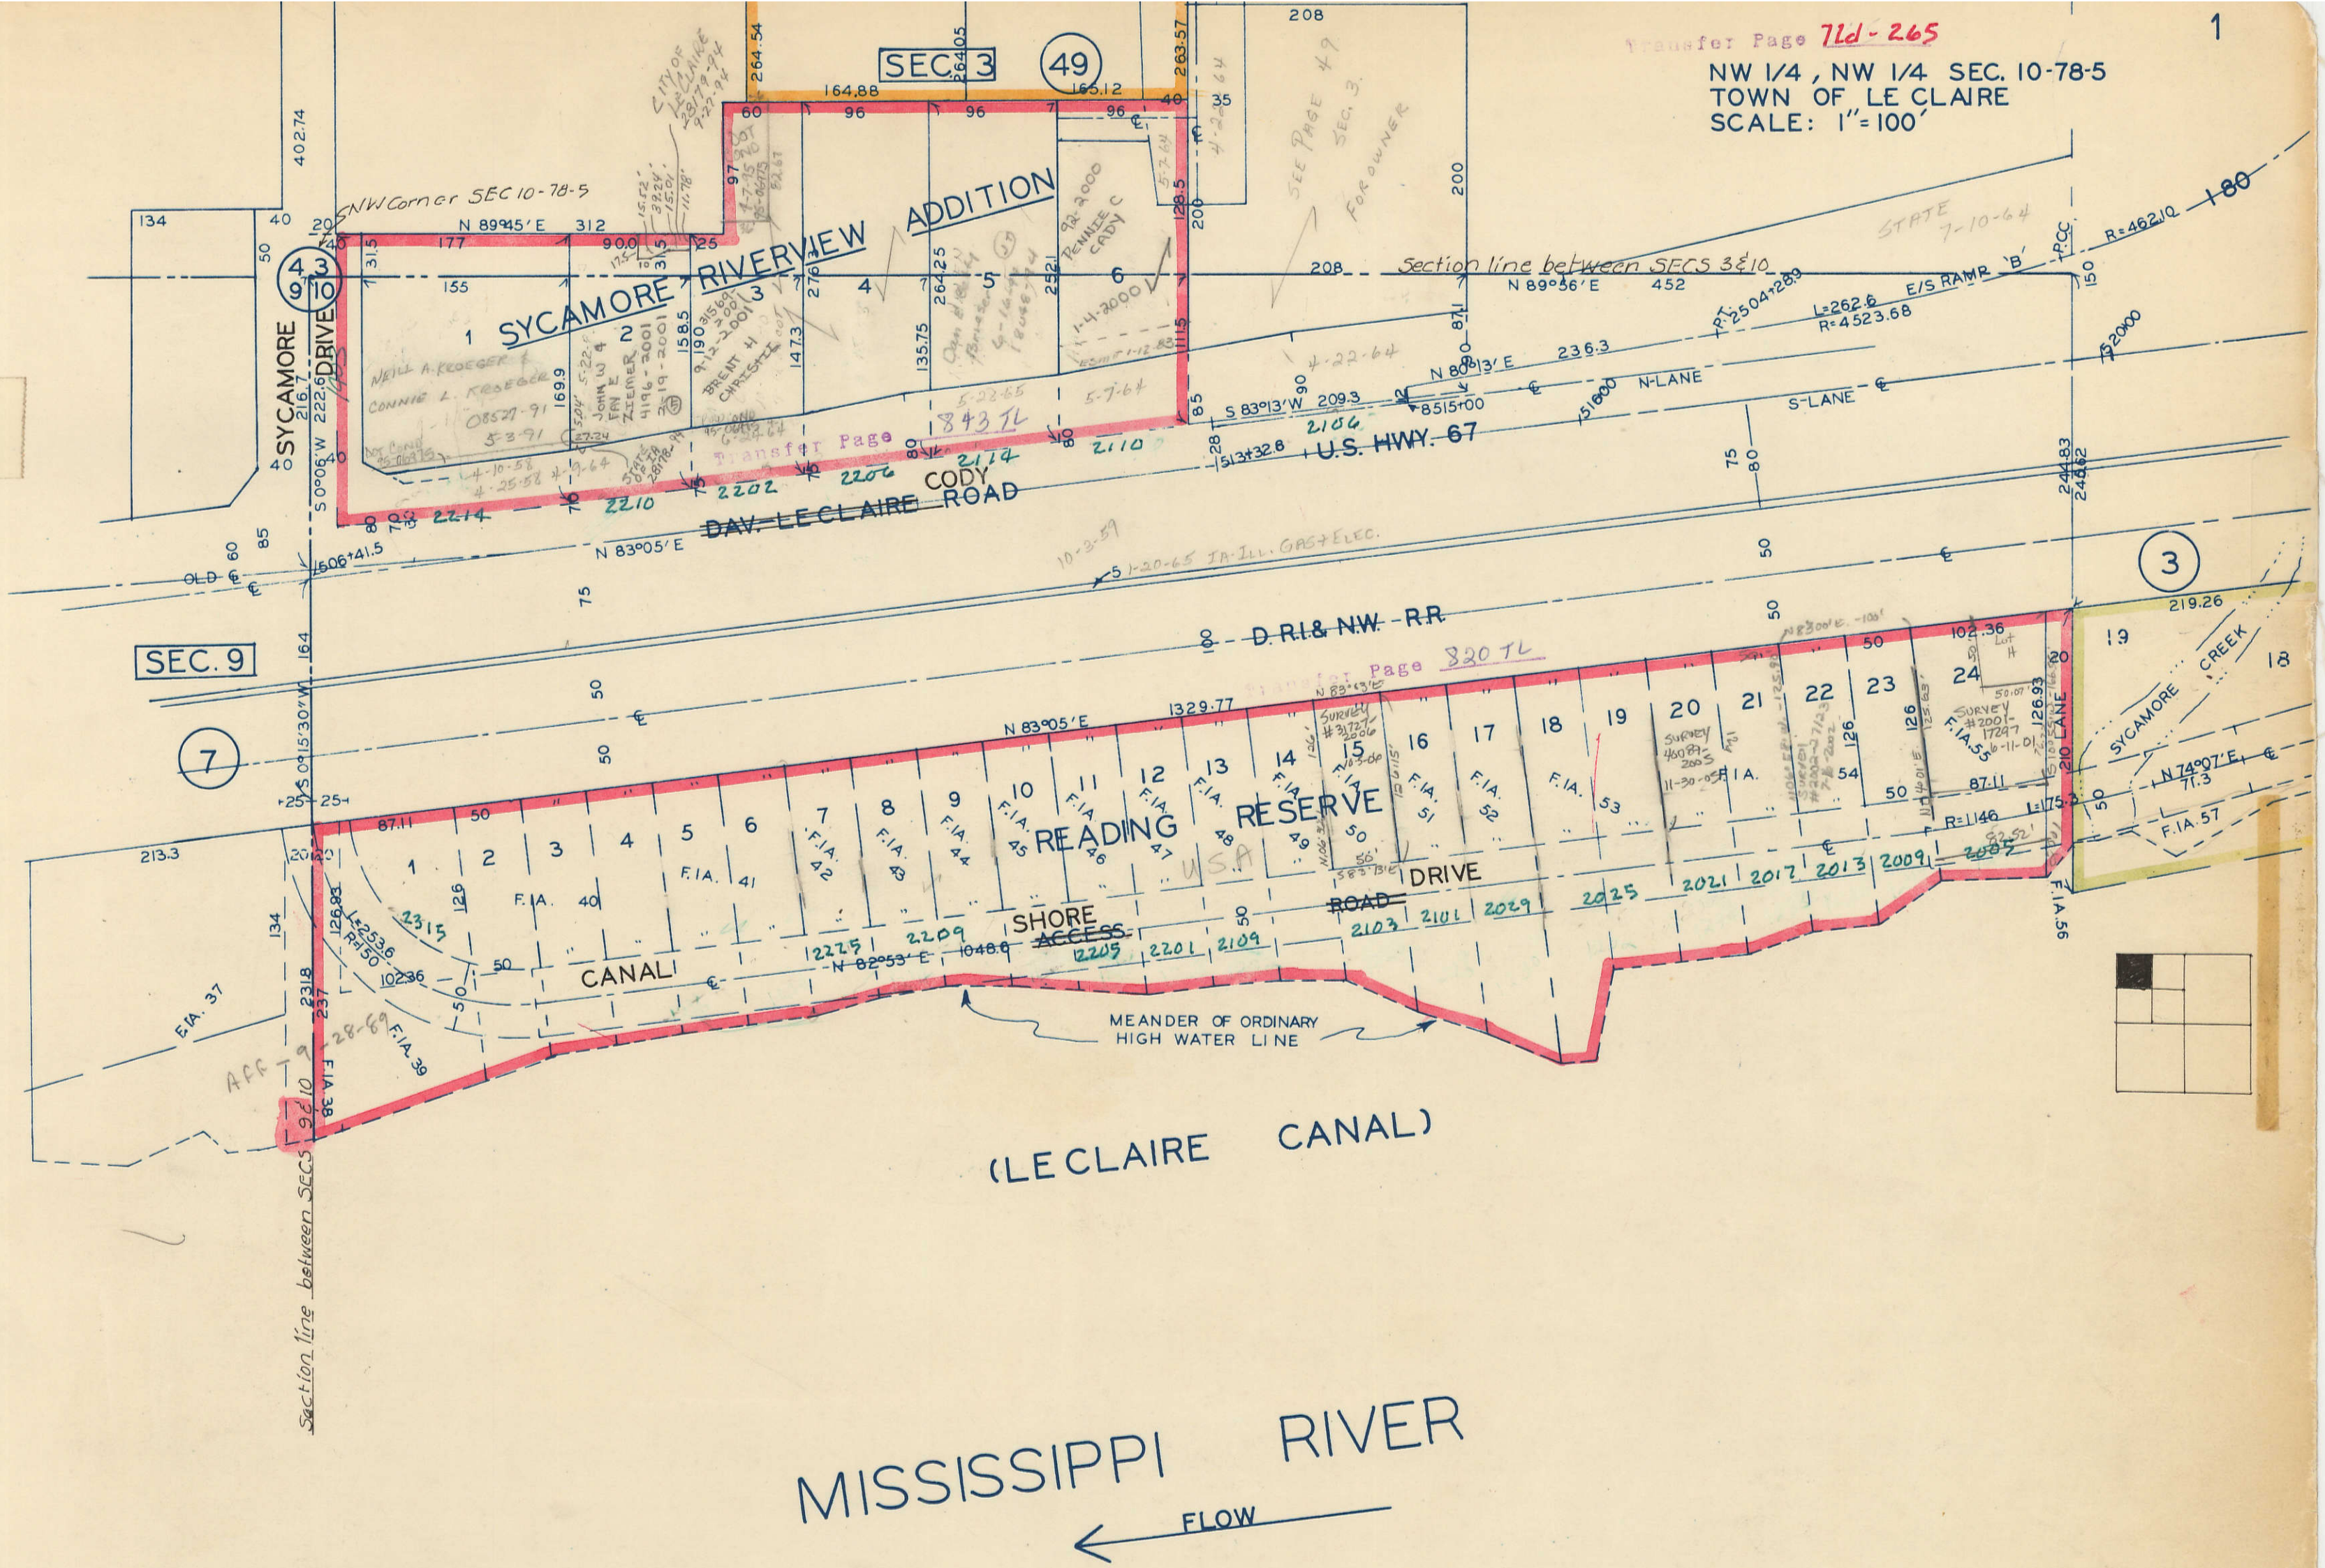


(LE CLAIRE CANAL)

MISSISSIPPI RIVER  
← FLOW

SEC. 3 (51)

NE 1/4, NW 1/4 SEC. 10-78-5  
TOWN OF LE CLAIRE  
SCALE: 1"=100'

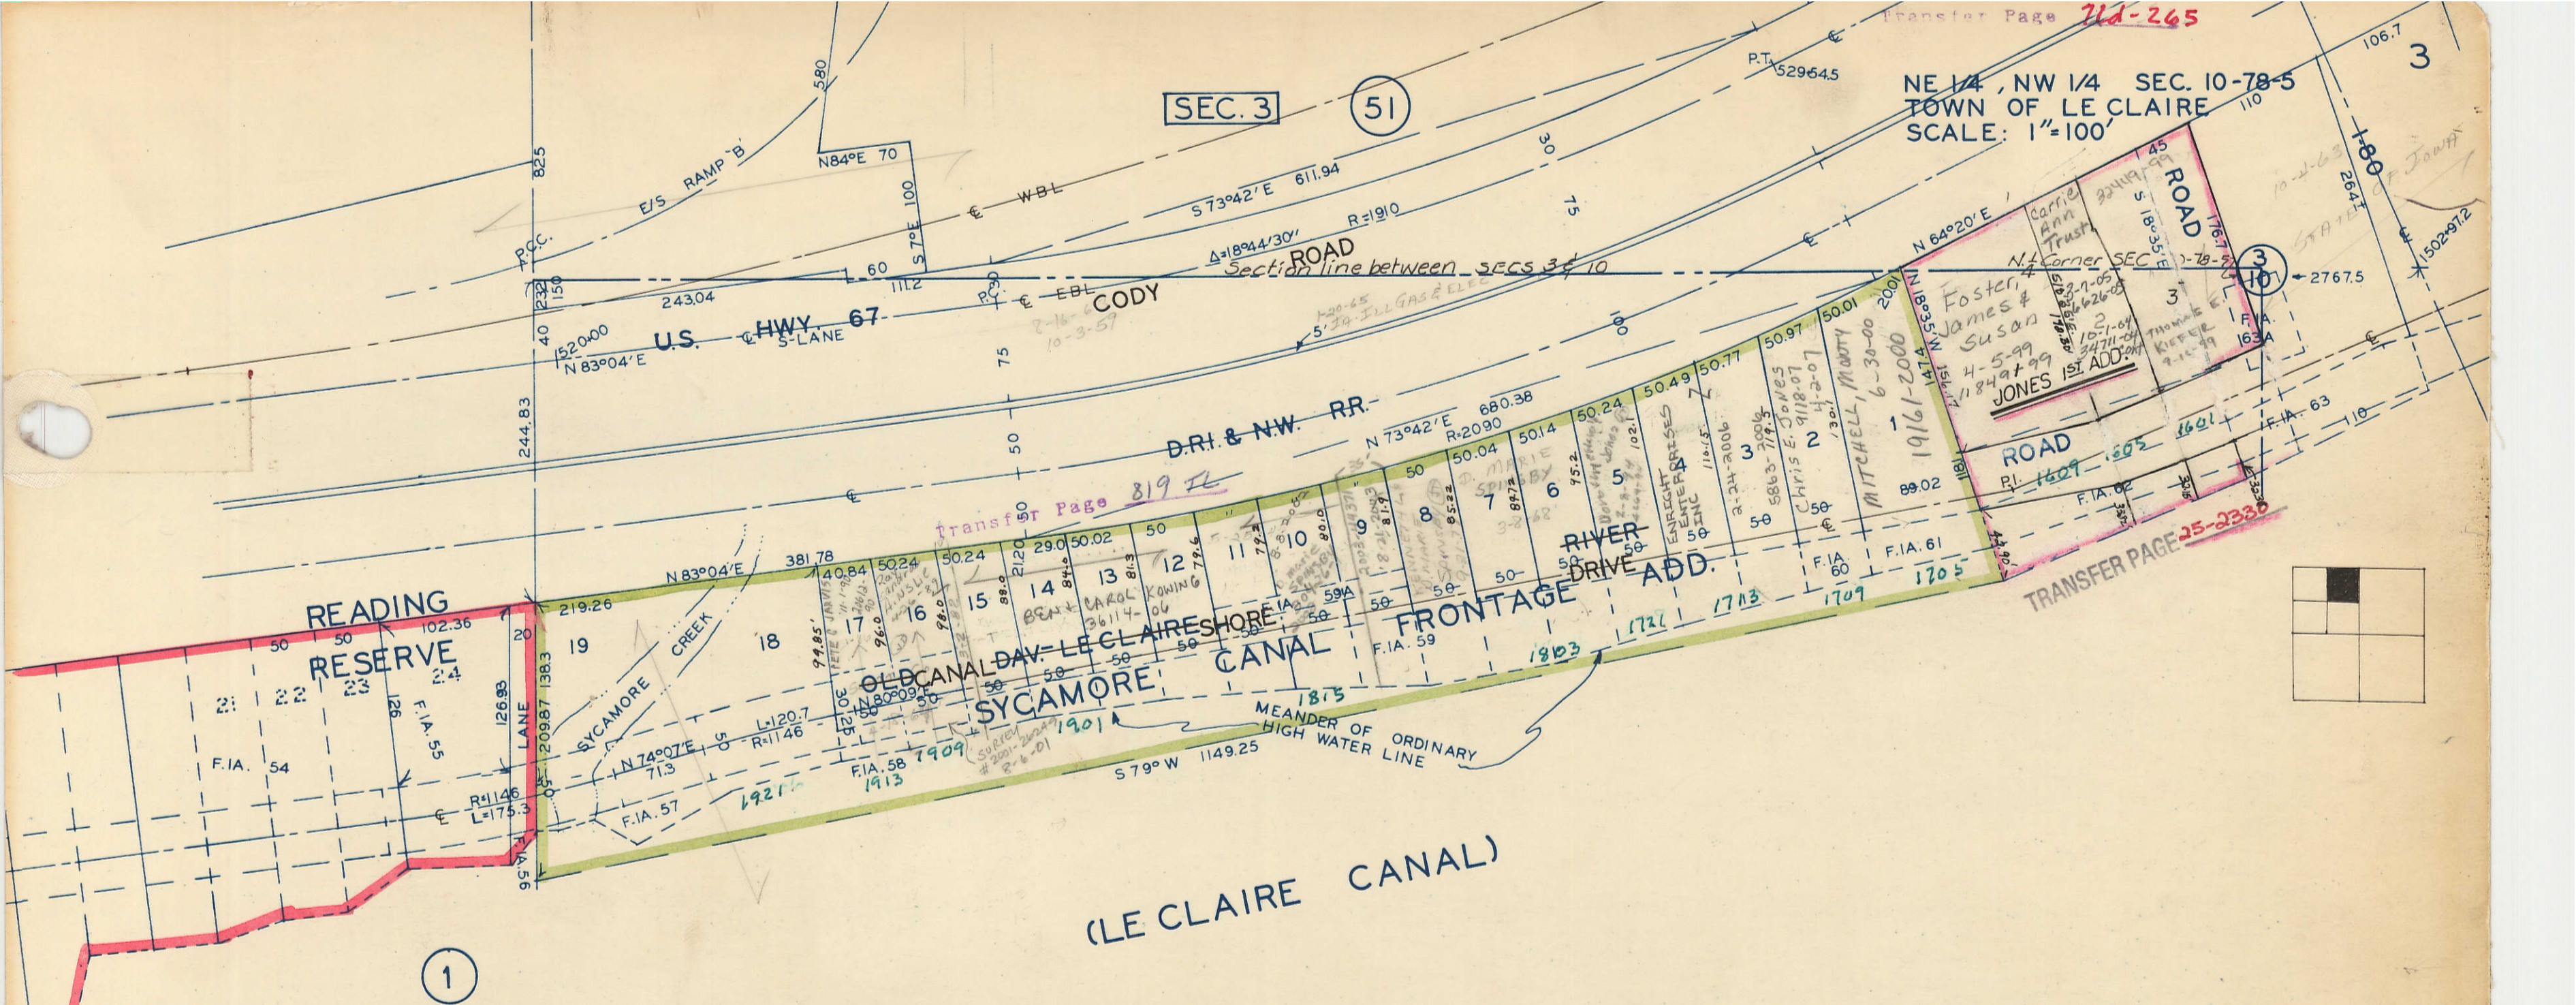

MISSISSIPPI RIVER  
← FLOW

Transfer Page 819 II

TRANSFER PAGE 25-2326

1

3

3

