

NW 1/4, NW 1/4 SEC. 9-78-5
TOWN OF LE CLAIRE
SCALE: 1" = 100'

S. SERGEANT'S
HILLTOP ADD.

SERGEANT'S
RIVER VIEW

SEC. 4

(49)


SERGEANT'S THIRD RIVERVIEW ADD.

LIMITS
CORPORATE

CODY ROAD
U.S. HWY. 67

GOVT. LOT 2

(3)

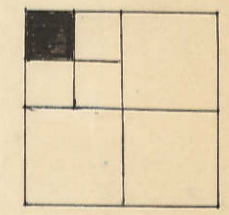

DAV. LE CLAIRE ROAD

BERTRAM SUEB.D.

D. R. & N.W. RR.


MEANDER OF ORDINARY
HIGH WATER LINE

(LE CLAIRE CANAL)

MISSISSIPPI RIVER
SMITH'S ISLAND

FLOW

8-14-40
10-6-36

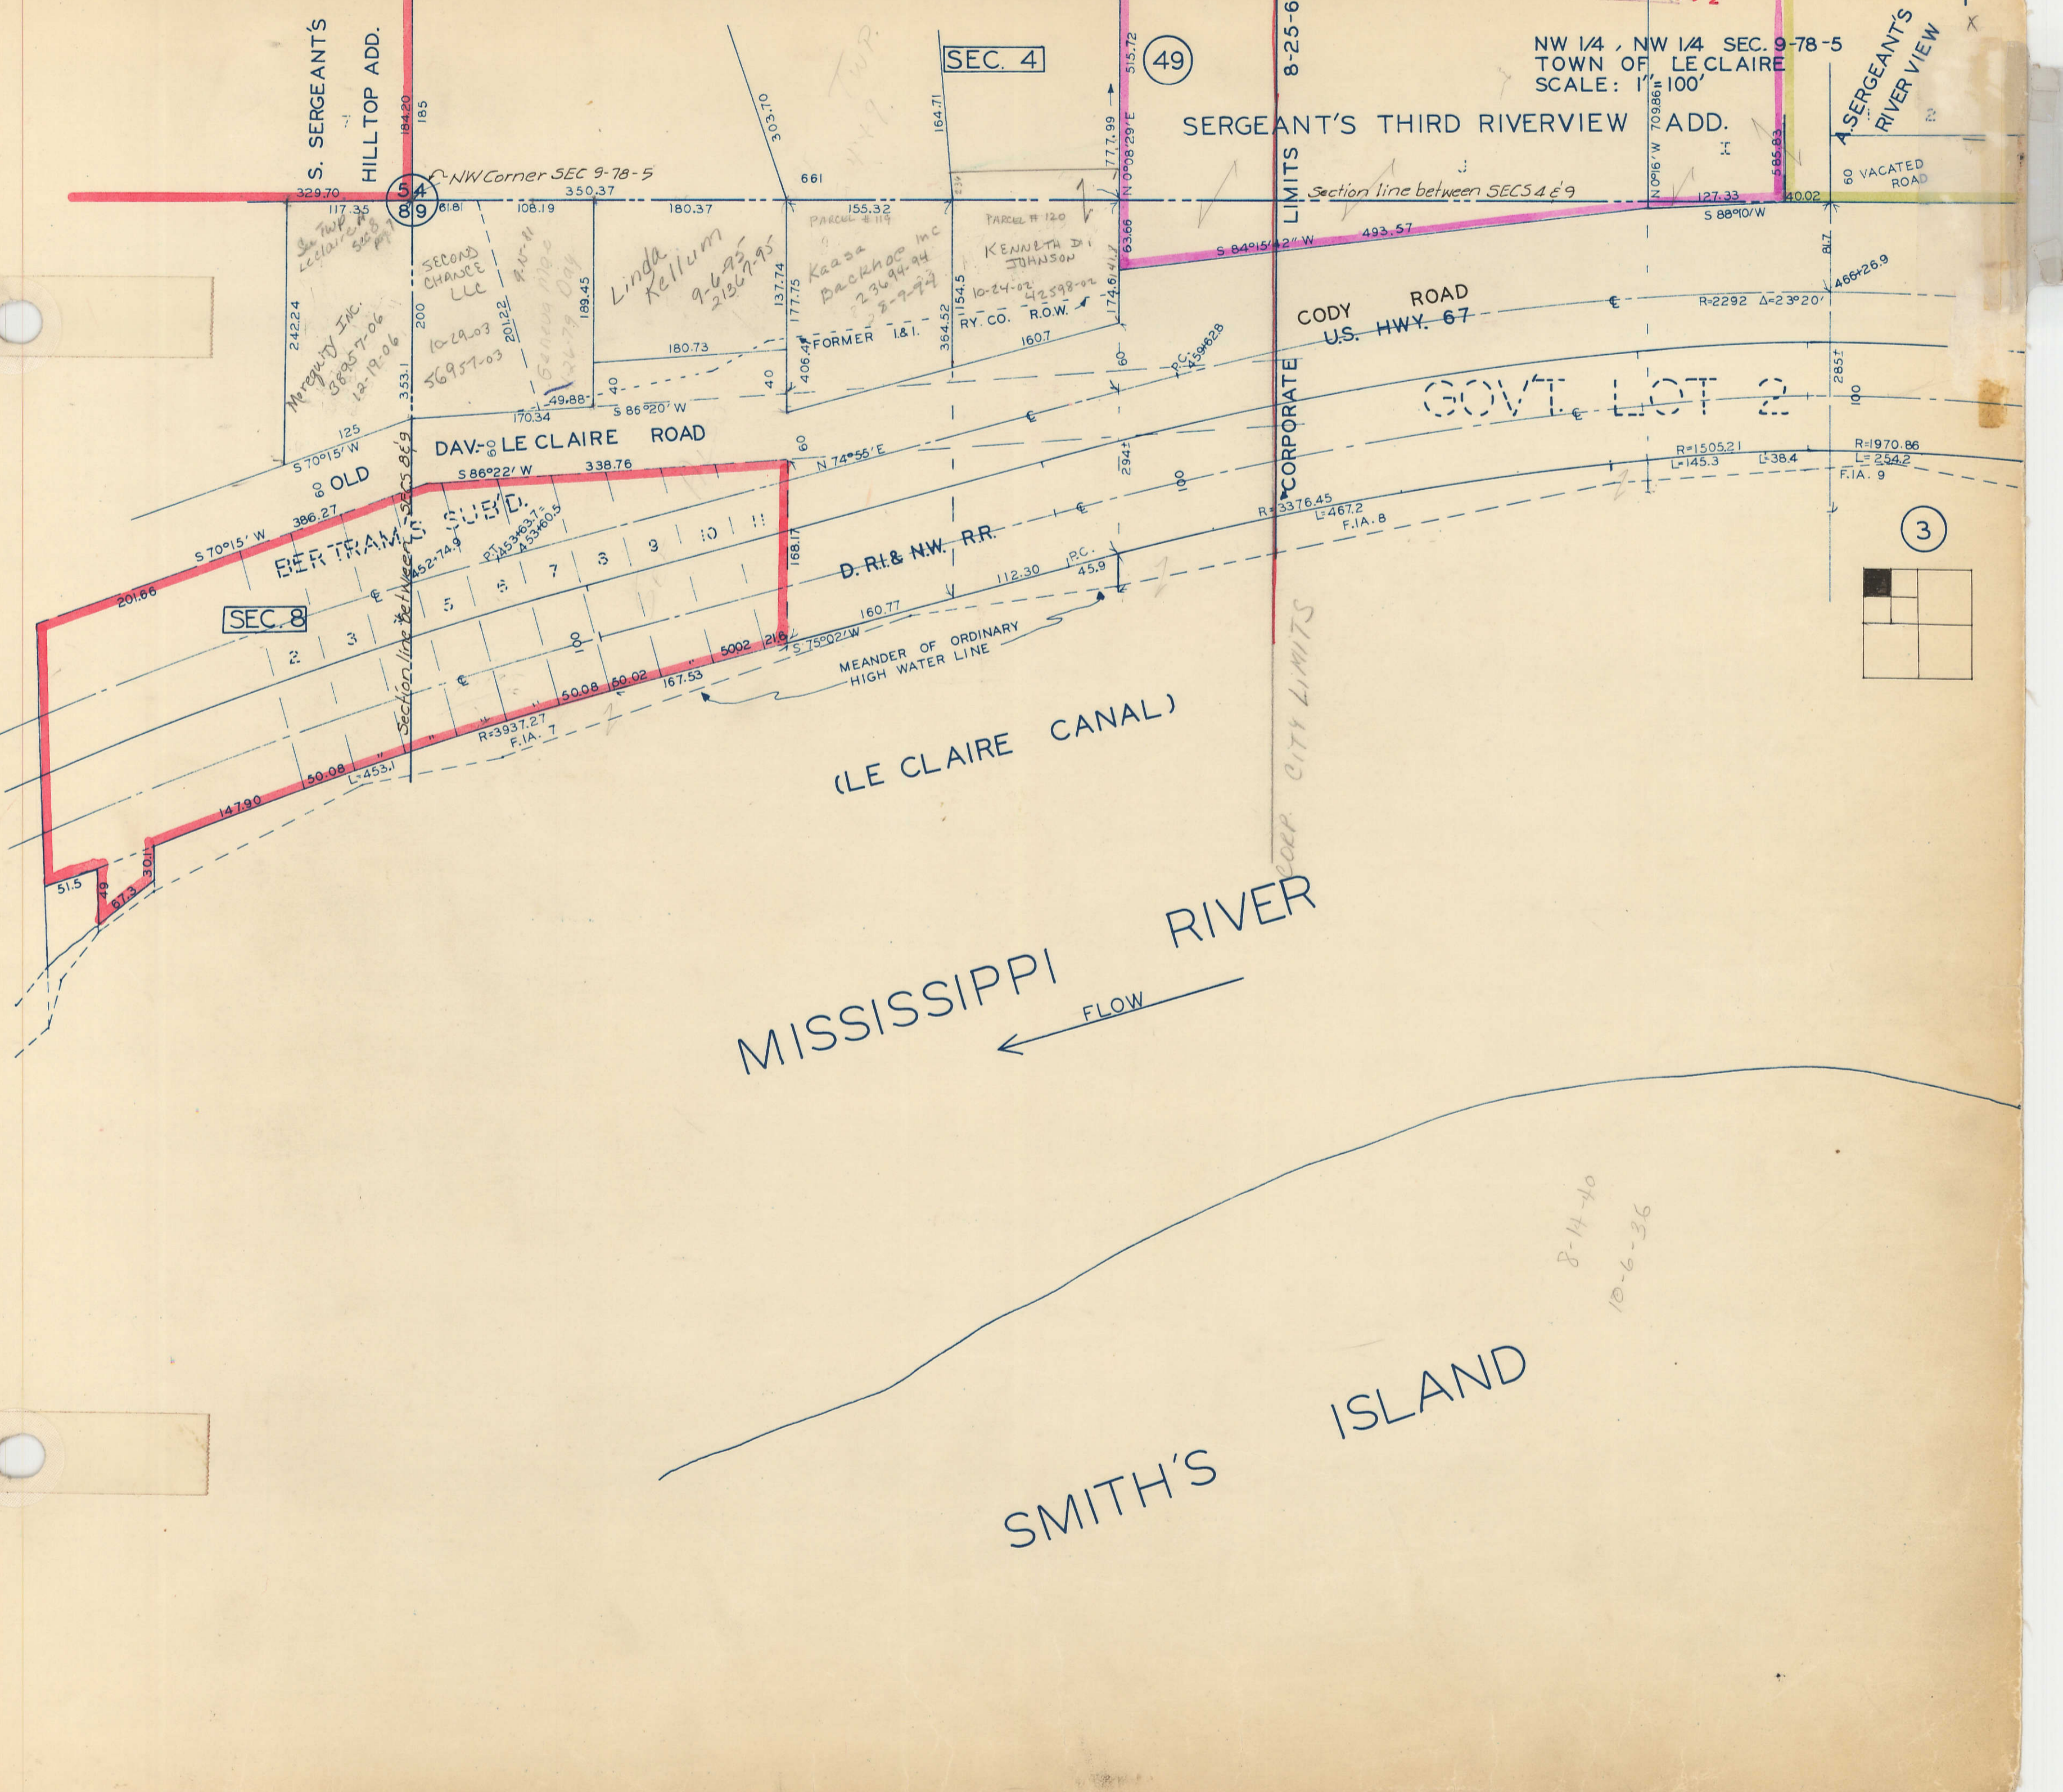

SEC. 4 (51)

NE 1/4, NW 1/4 SEC. 9-78-5
TOWN OF LE CLAIRE
SCALE: 1" = 100'

SERGEANT'S 3RD RIVER VIEW ADD.

A. SERGEANT'S RIVER VIEW ADD.

2ND PLAT, A. SERGEANT'S

RIVER VIEW

GOVT LOT 2

US. HWY. 67

CODY ROAD

US. HWY. 67

D. RI. & NW RR

(LE CLAIRE CANAL)

MISSISSIPPI RIVER
FLOW

SMITH'S ISLAND

R=1505.21
F.I.A. B L=145.3 L=38.4

R=1970.86
L=254.2

R=15954.04
L=164.3
F.I.A. 9 OWNER KK?

N 81°40' W 219.1

Schadler Joseph & Robin Ann

OLD WEST RIVER

GLEN BAKER'S SUBD.
TRANSFER PAGE 804 TL

Gould David & Phyllis


Margaret A. McNamara Trust

Kaminski Trust

SEE PAGE 5

SURVEY 4266-2005 2-18-2005

8-14-40
10-6-36

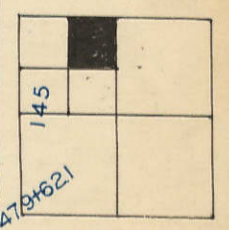

493.57
127.33
S 88°10' W

484.5

81.7

L=933.3
R=2292

81.7

81.7

Section line between SECS 4 & 9

UNDERPASS

MEANDER OF ORDINARY HIGH WATER LINE




























NW 1/4 NE 1/4 SEC. 9-78-5
CITY OF LECLAIRE

SCALE: 1 IN. = 100 FT.

5

SEC 4
TRANSFER PAGE 25-2256



53

TRANSFER PAGE 74-265 1/2

ESTATES
DONALD + CRICKETTE DENTON

WALBRIER ESTATES
SECOND ADDITION

TRANSFER PAGE 237L-1941

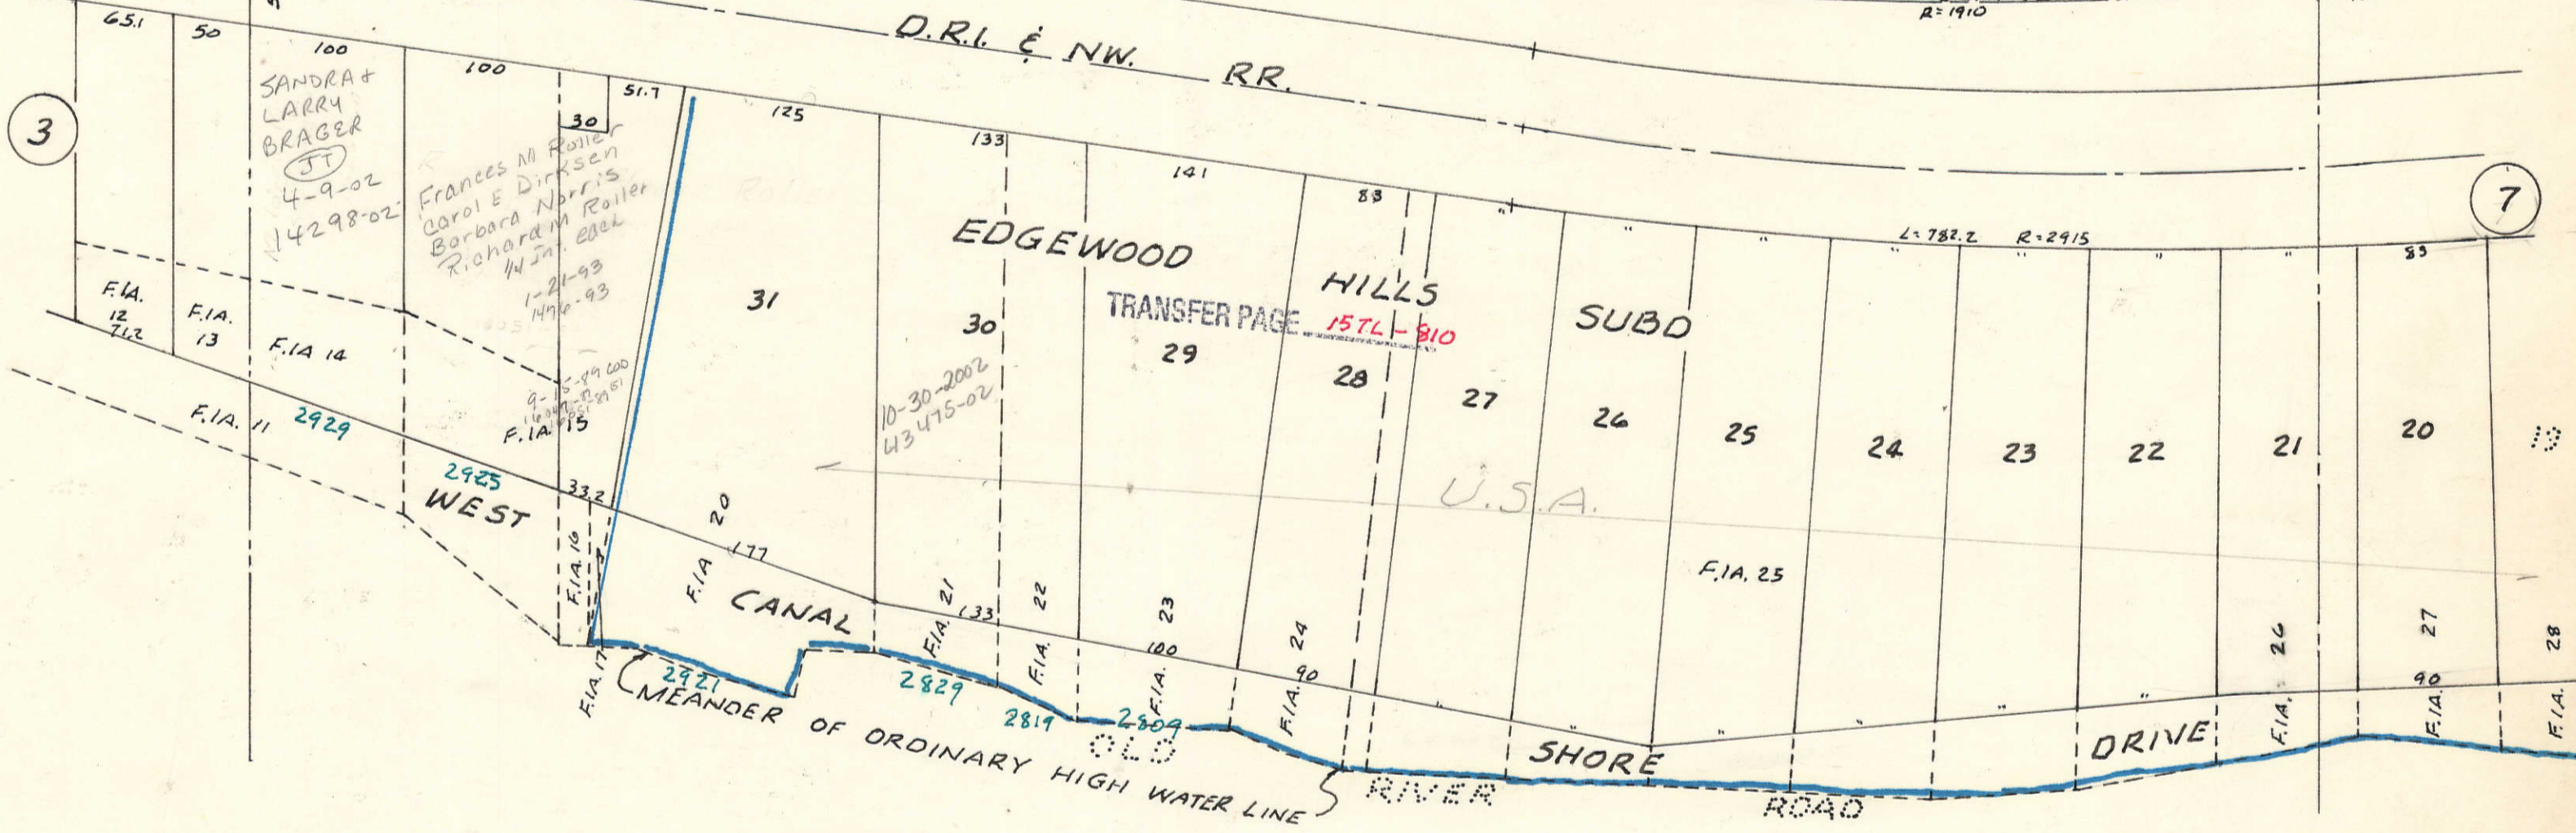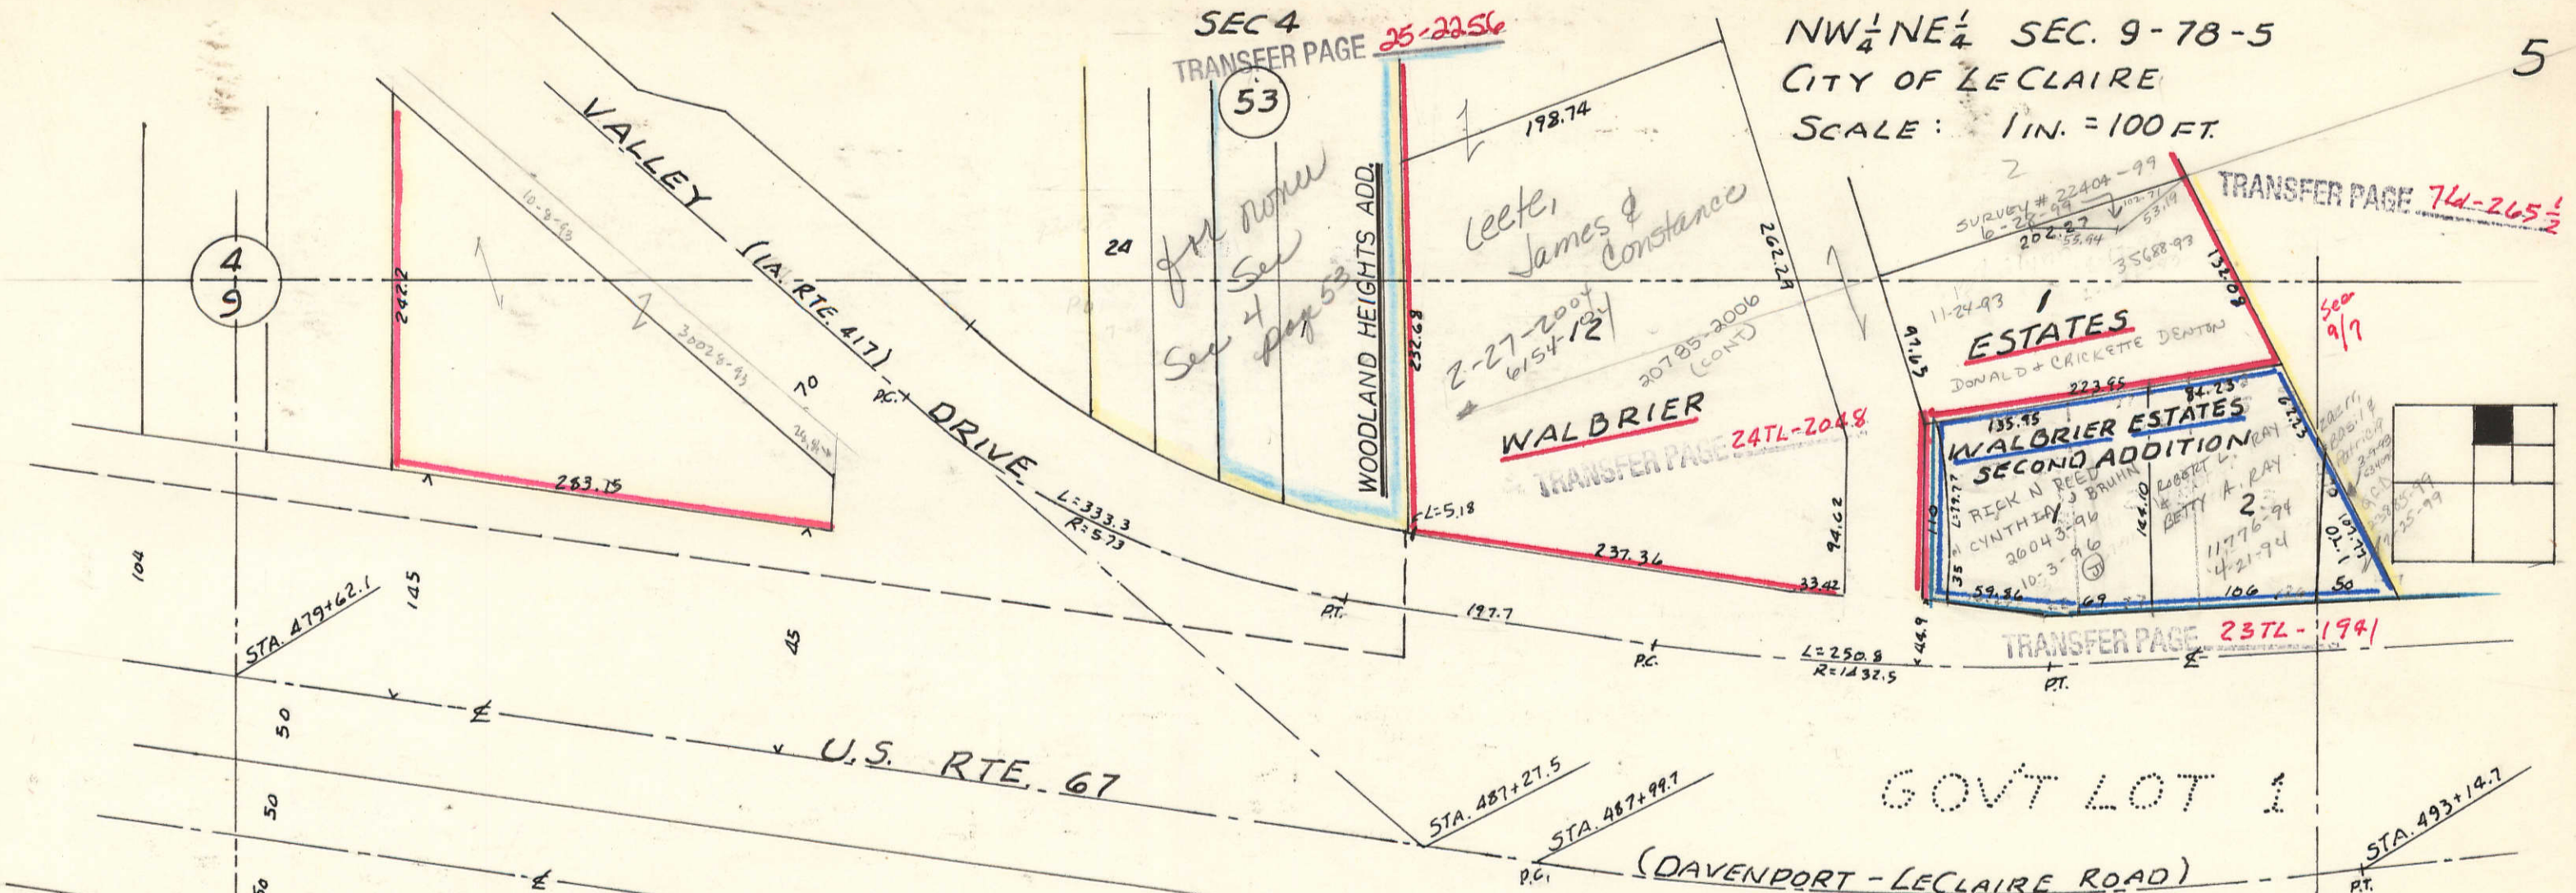



(LECLAIRE CANAL)
MISSISSIPPI RIVER

+

+

NE 1/4, NE 1/4 SEC. 9-78-5
TOWN OF LE CLAIRE
SCALE: 1" = 100'

SEC. 4 (55)

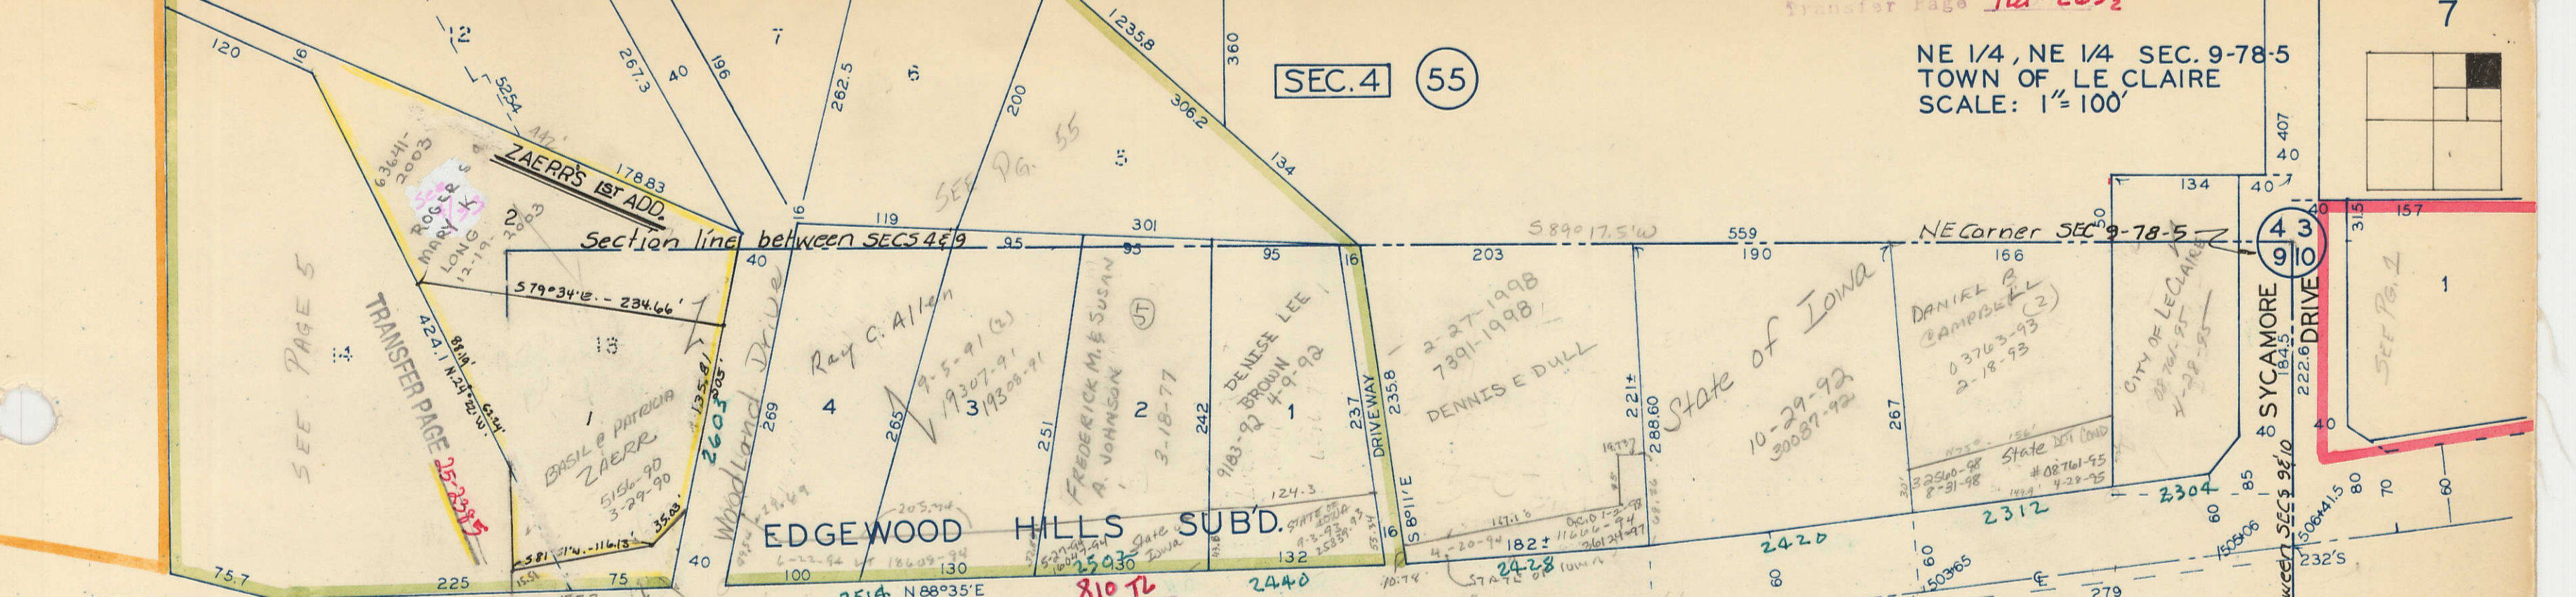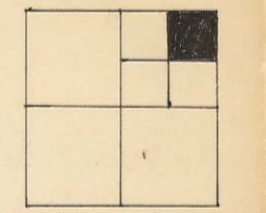

EDGEWOOD HILLS SUBD.

HWY. 417

DAY-LE CLAIRE ROAD

U.S. HWY. 67

SEC. 10

(5)

GOVT. LOT 1

D.R.I. & NW RR.

Transfer Page 810 TL

EDGEWOOD HILLS SUB'D.

RIVER

READING RESERVE

ACCESS ROAD
SHORE DR.

(LE CLAIRE CANAL)

MISSISSIPPI RIVER
← FLOW

