


SECTION 28

Township 79-North; Range 4
EAST OF THE FIFTH PRINCIPAL MERIDIAN
SCOTT COUNTY, IOWA
LINCOLN TOWNSHIP

SCALE IN CHAINS

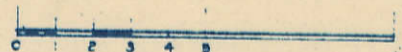


SCALE IN FEET



Transfer Page 7W-344

NORTH
SECTION 21

Nicholas W. Plonker
M&L 300 & A. Baer
4-13-2004
Survey # 2004-13442
4-20-2004
(1.2ac)

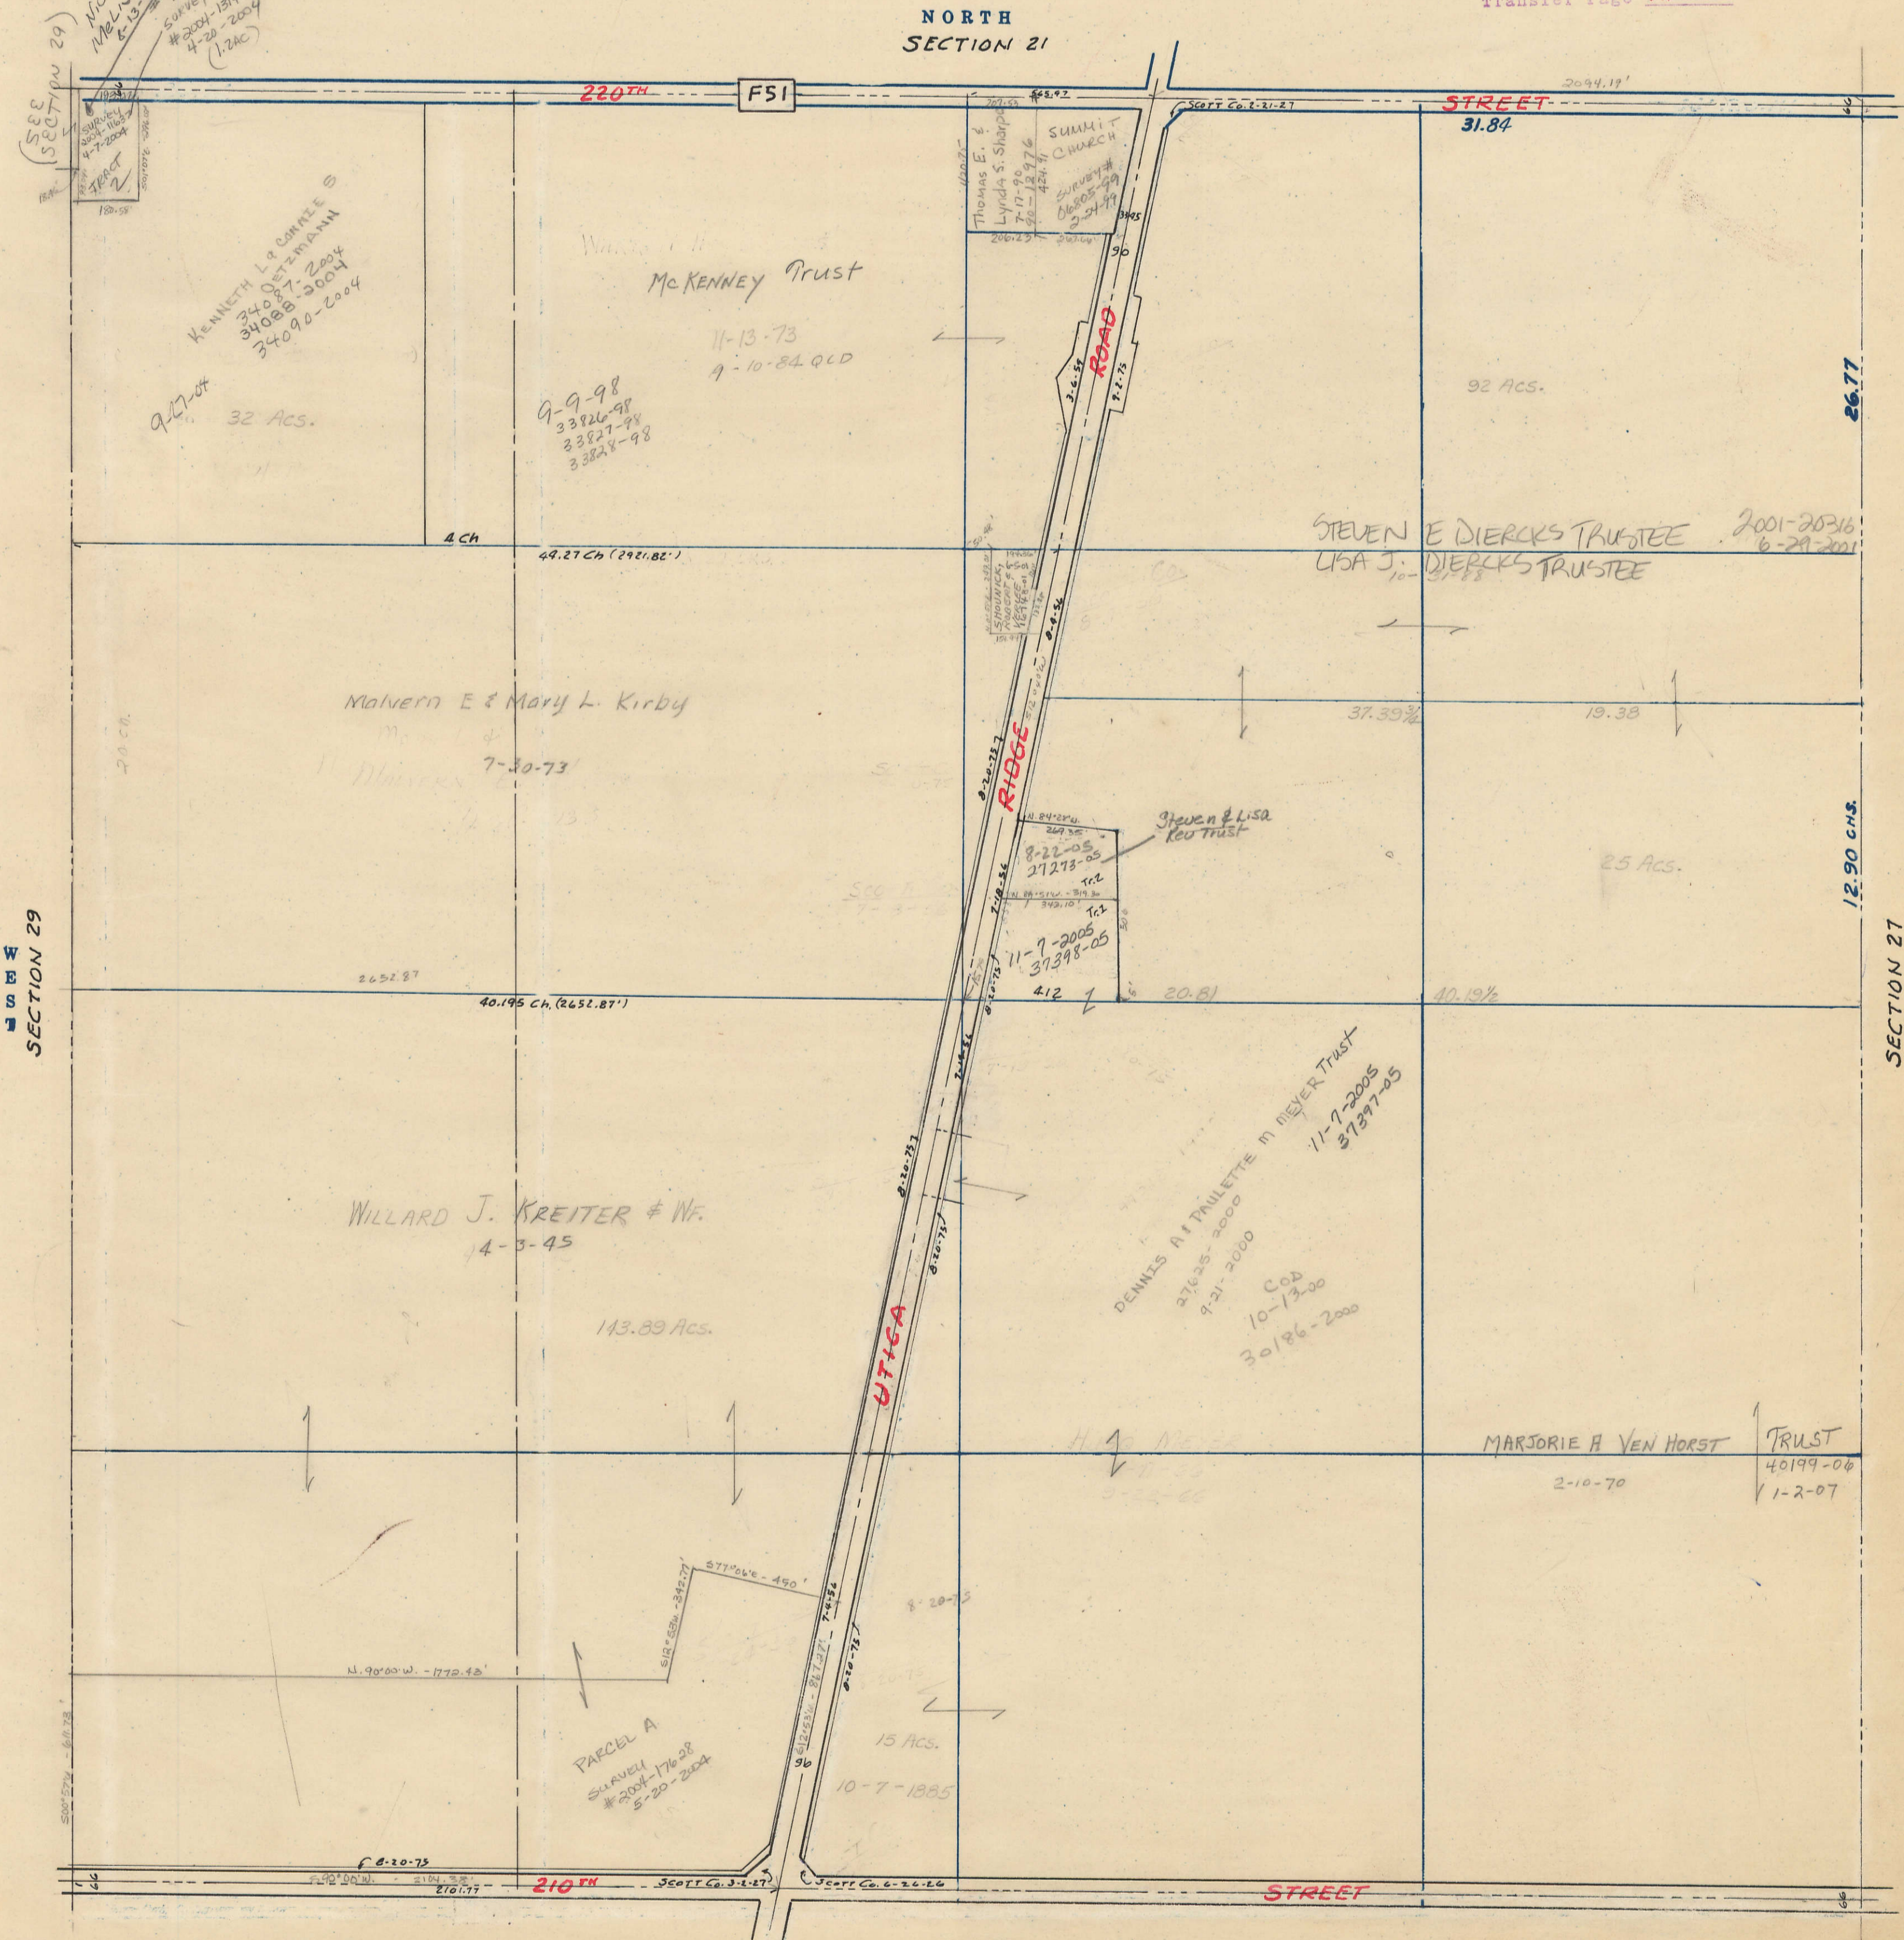

SECTION 29

SECTION 27

SOUTH
SECTION 33