


SECTION II
TOWNSHIP 79 NORTH, RANGE 5 EAST,
5TH PRINCIPAL MERIDIAN
PRINCETON TOWNSHIP
SCOTT COUNTY, IOWA

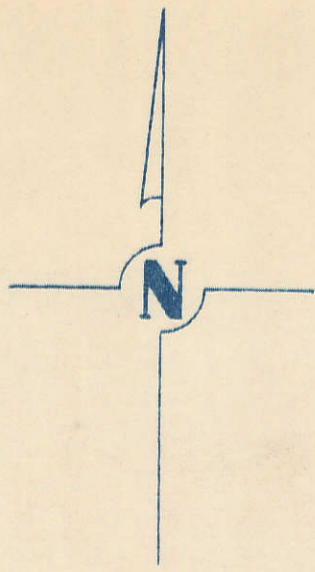


SCALE: 1 INCH = 330 FEET

SECTION 2

PAGE 2

TRANSFER PAGE 387

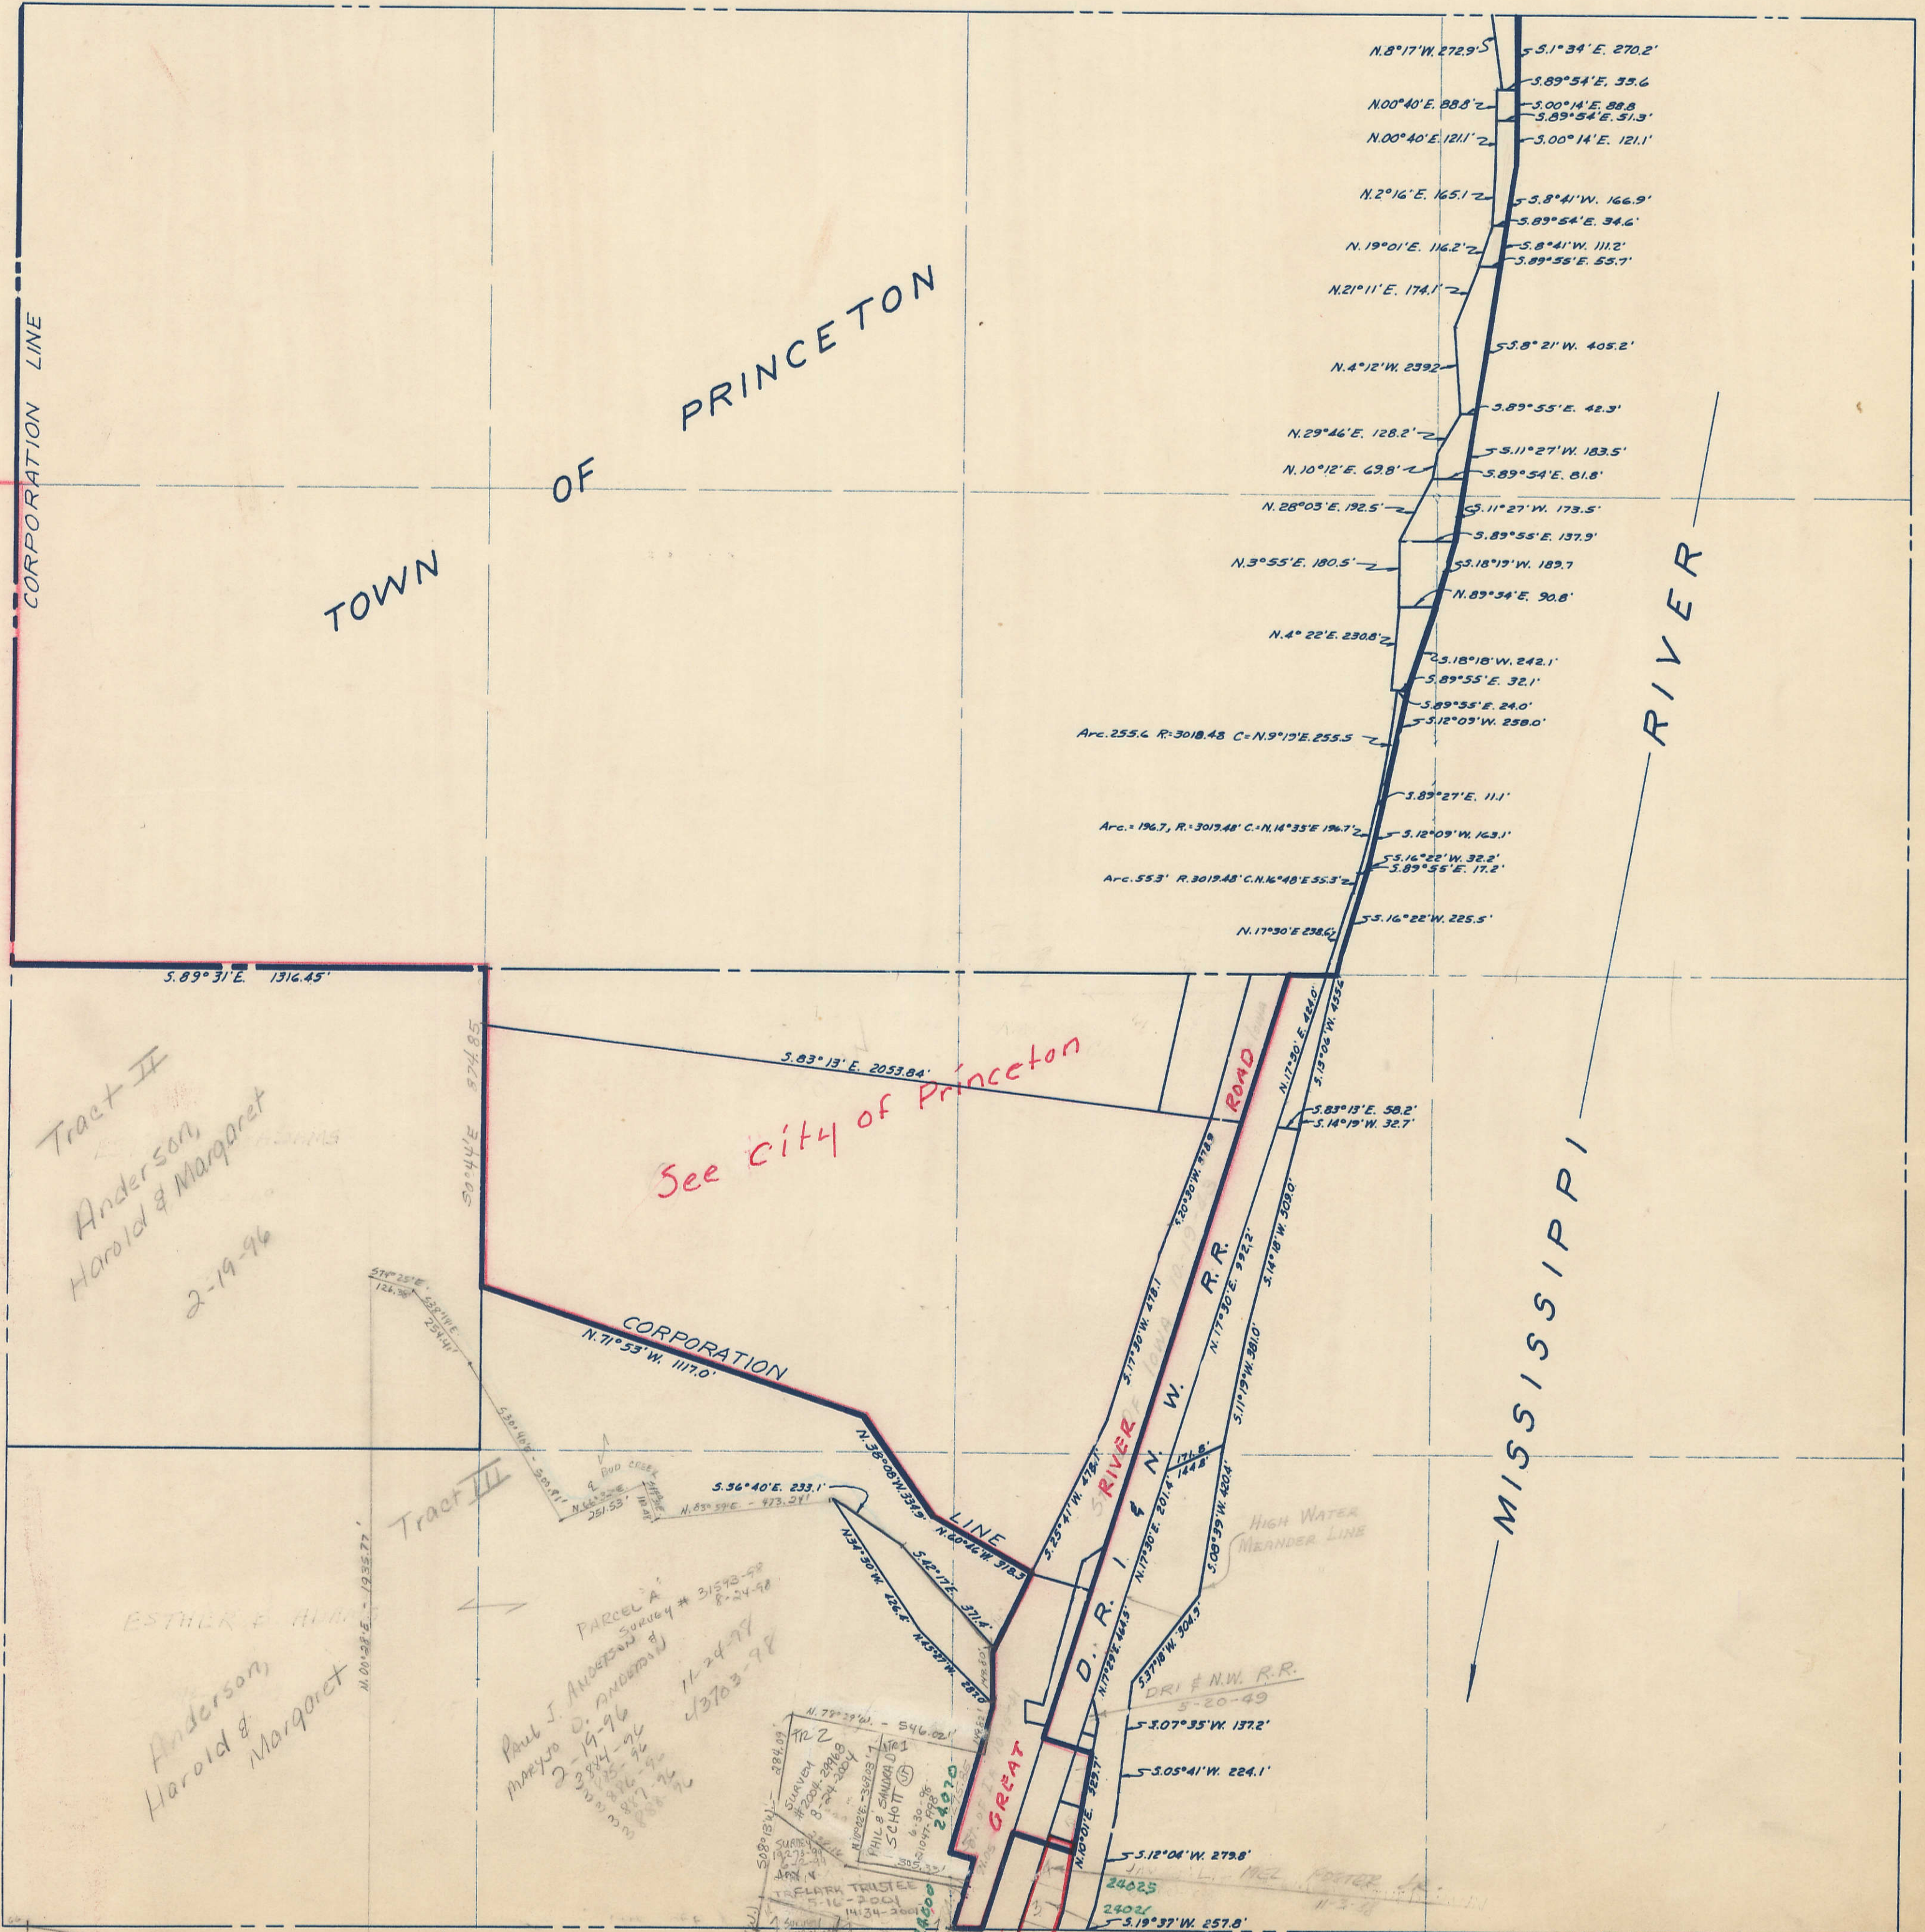

PAGE 10

SECTION 10

PAGE

SECTION

SECTION 14

PAGE LE CLAIRE TWP.