


SECTION 16  
TOWNSHIP 80 NORTH, RANGE 5 EAST,  
5<sup>TH</sup> PRINCIPAL MERIDIAN  
PRINCETON TOWNSHIP  
SCOTT COUNTY, IOWA

TRANSFER PAGE 392

SCALE: 1 INCH = 330 FEET

SECTION PAGE

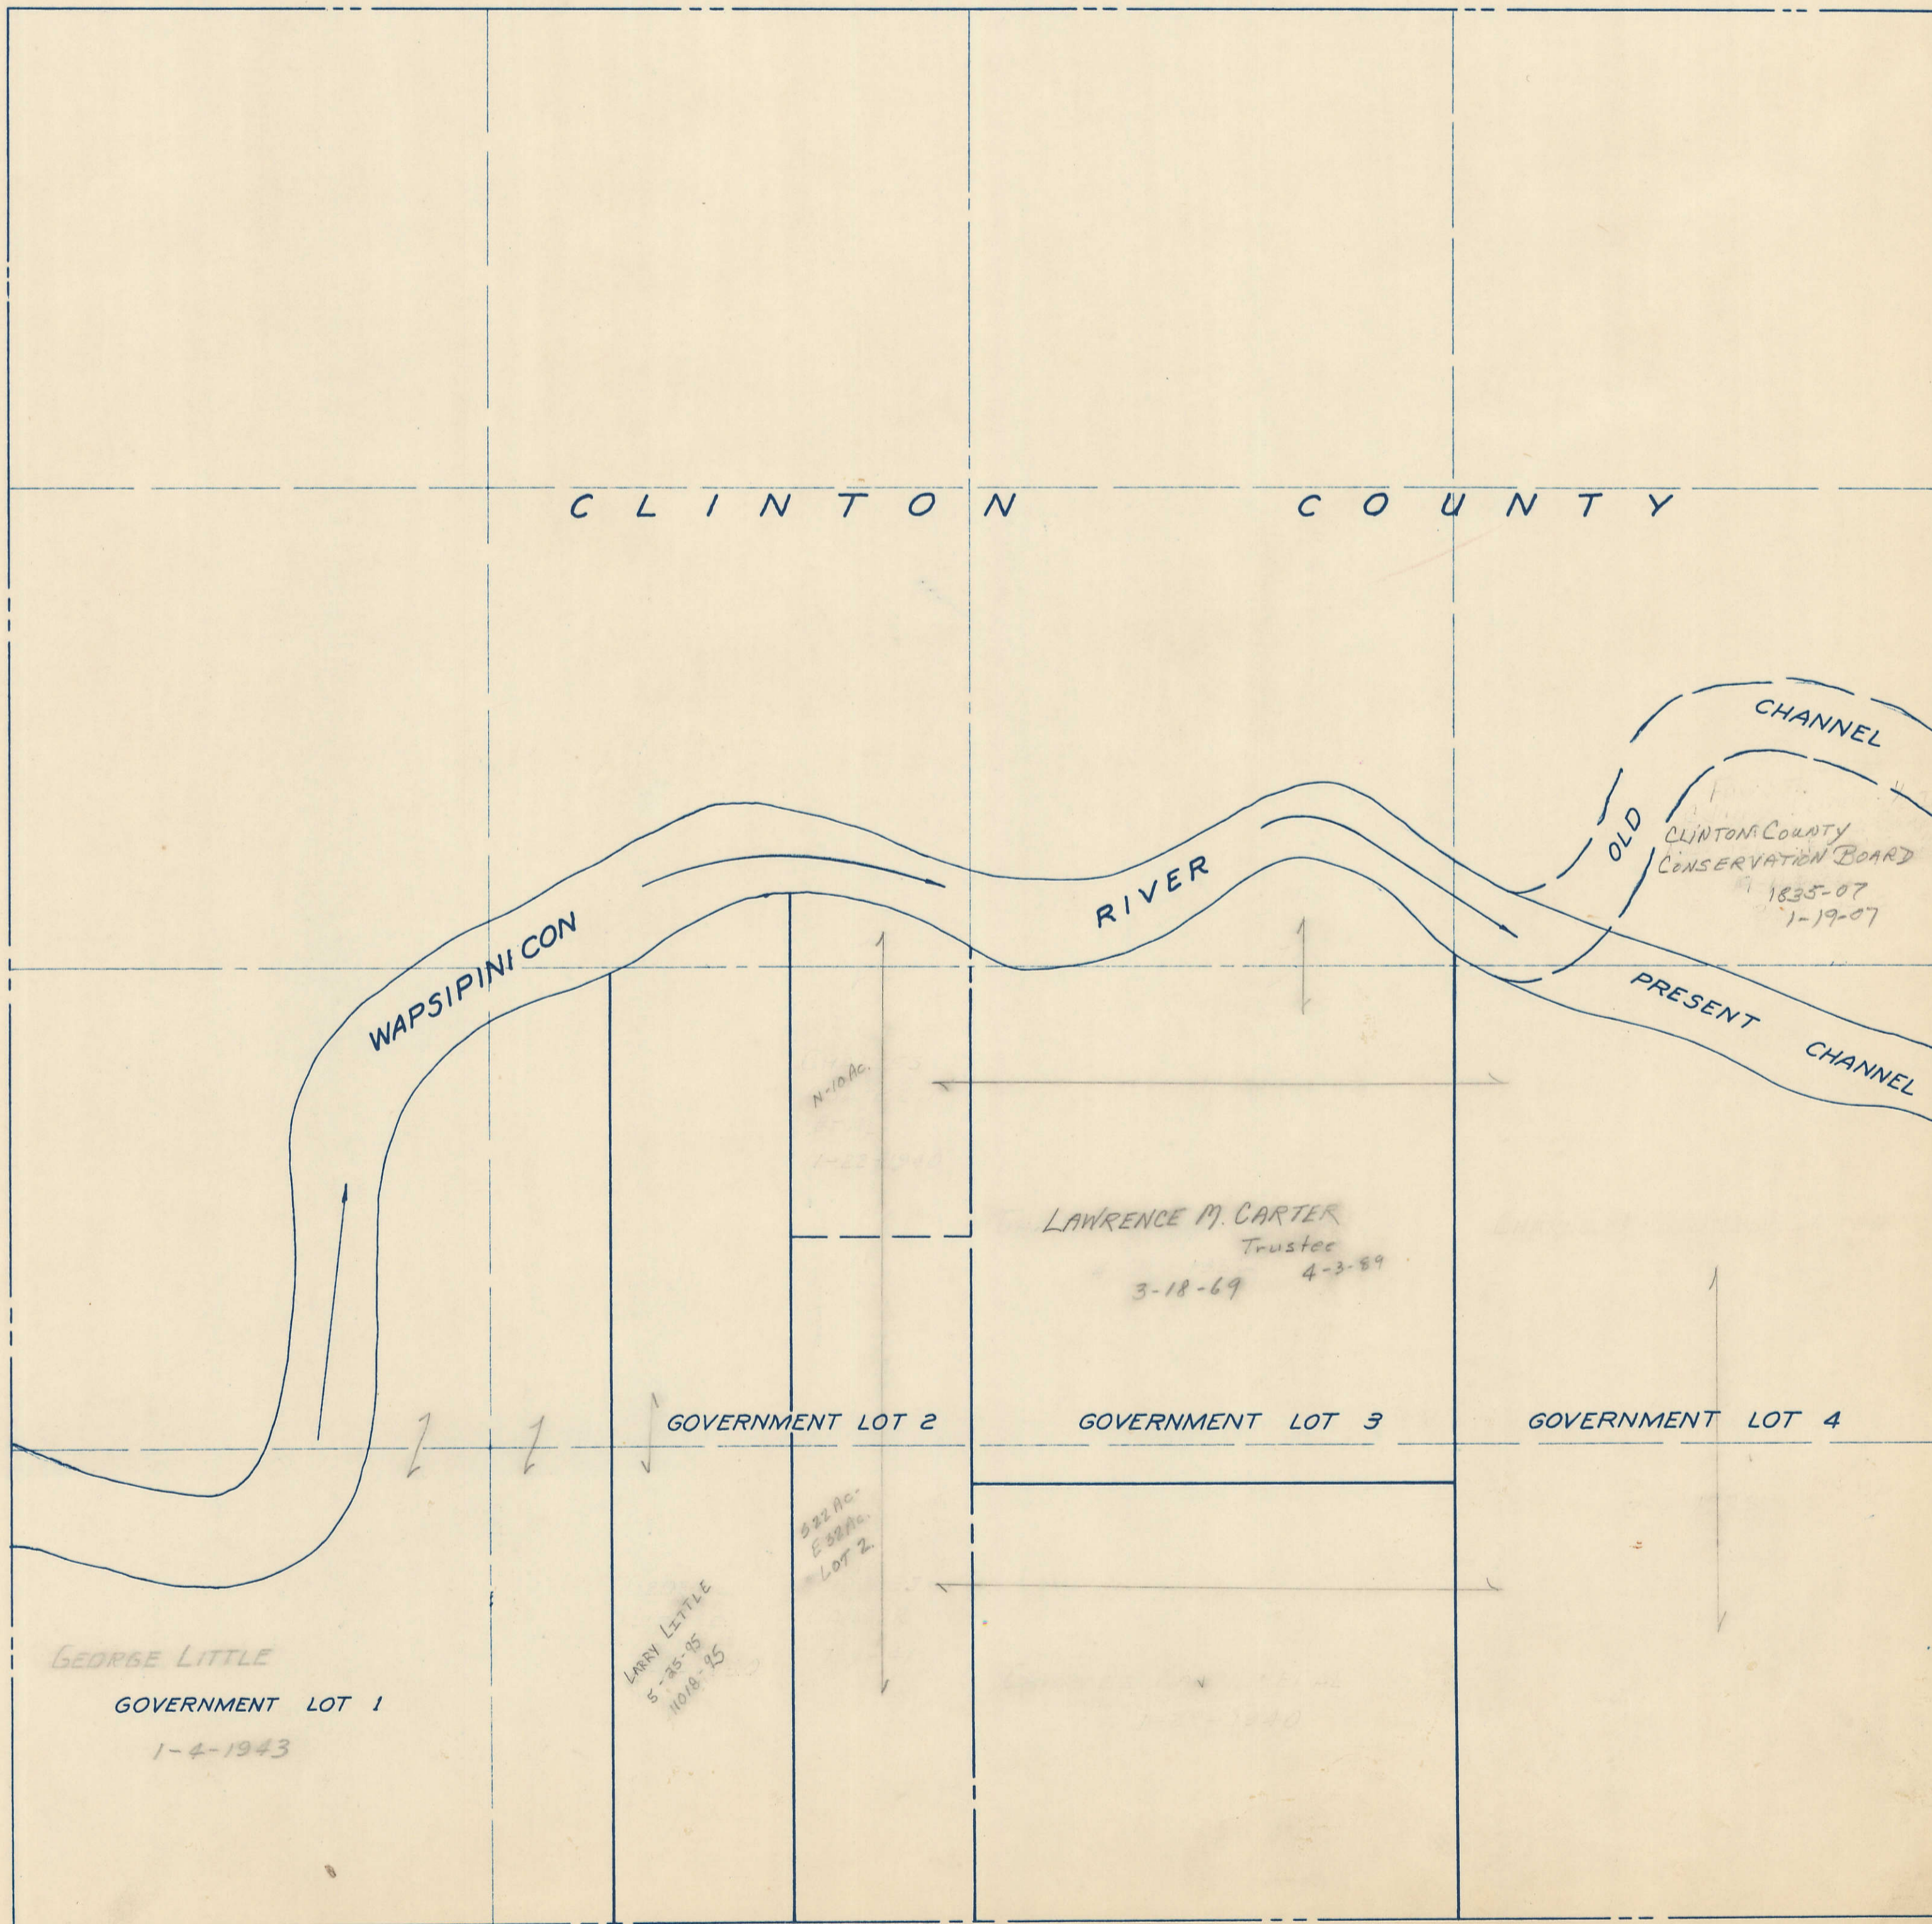

PAGE 17

SECTION 17

PAGE 15

SECTION 15