

SECTION 12

Township 79-North; Range 3

EAST OF THE FIFTH PRINCIPAL MERIDIAN

SCOTT COUNTY, IOWA

SHERIDAN TOWNSHIP

SCALE IN CHAINS




SCALE IN FEET



Transfer Page 8lds-436

NORTH SECTION 1

SECTION 13 SOUTH

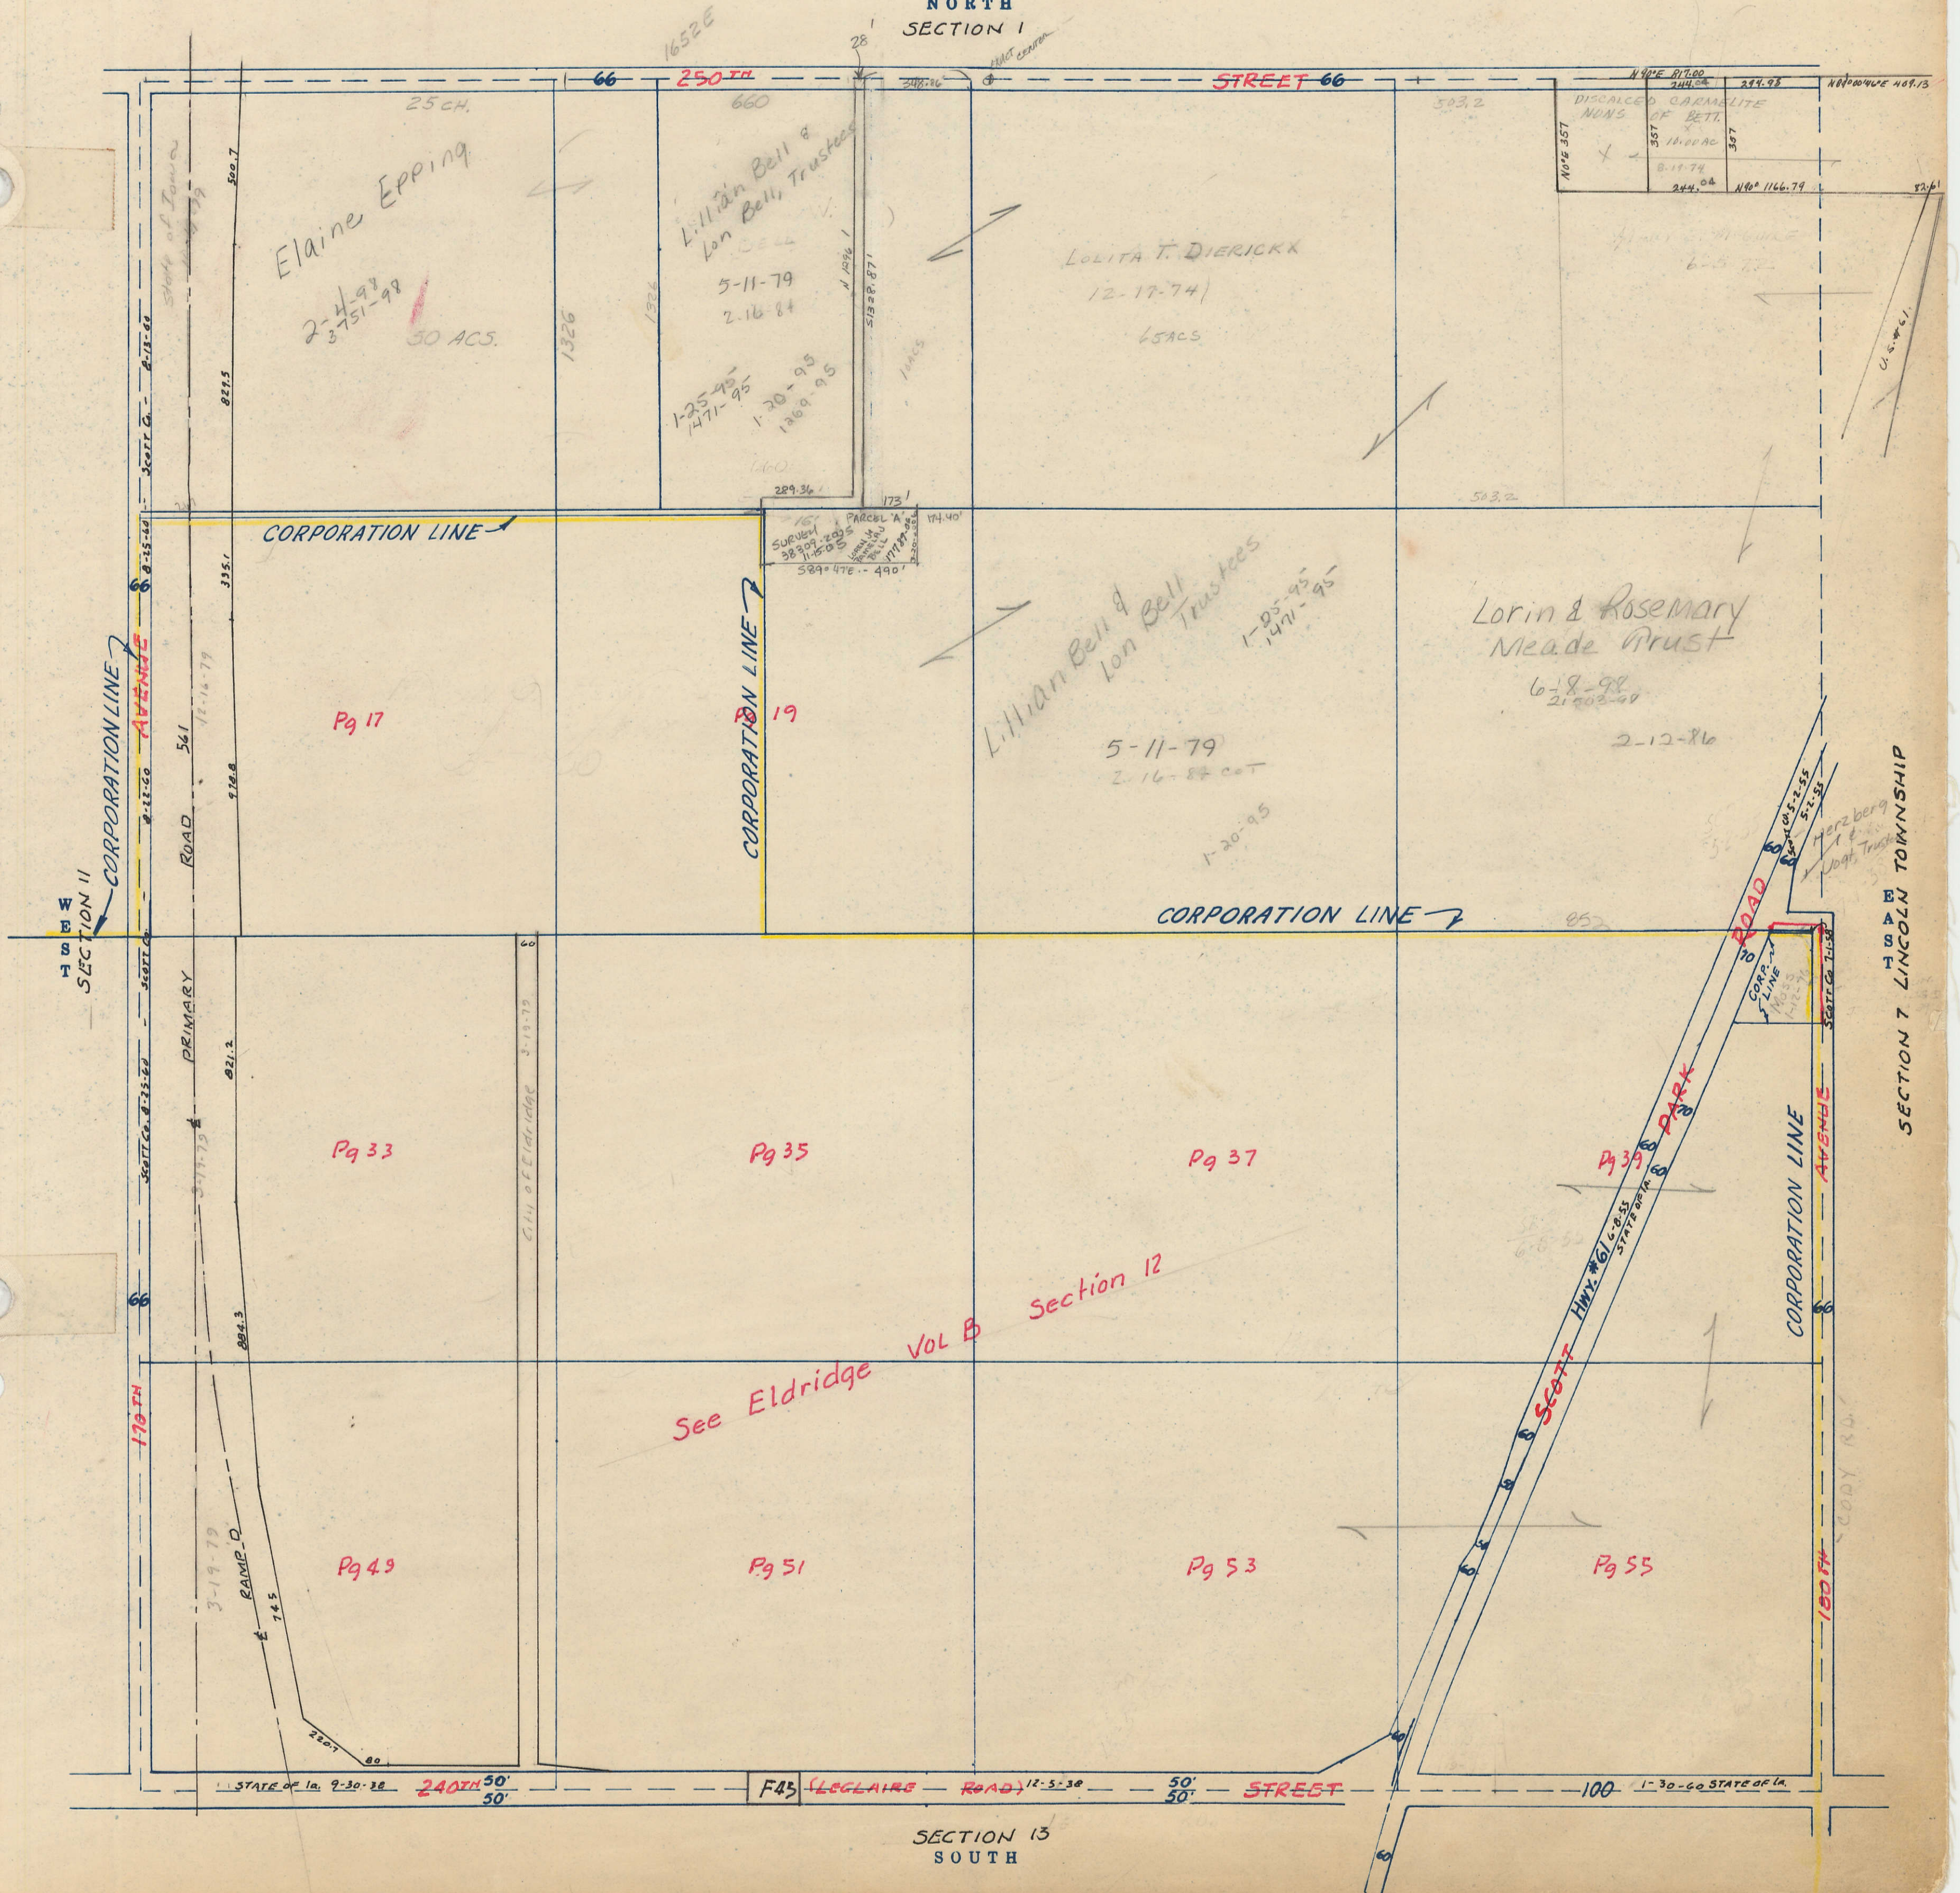

SECTION 7 LINCOLN TOWNSHIP

Elaine Epping
2-4-98
3-7-51-98
30 ACS.

Lillian Bell & Lon Bell, Trustees
5-11-79
2-16-84

Lolita T. Dierickx
12-17-74
65 ACS.

Lorin & Rosemary Meade Prust
6-8-98
2-12-86

See Eldridge Vol B Section 12

STATE OF Ia. 9-30-28 240 IN 50'

F45 (LECLAIRE ROAD) 12-5-30 50' 50'

STREET 100 1-30-60 STATE OF IA