
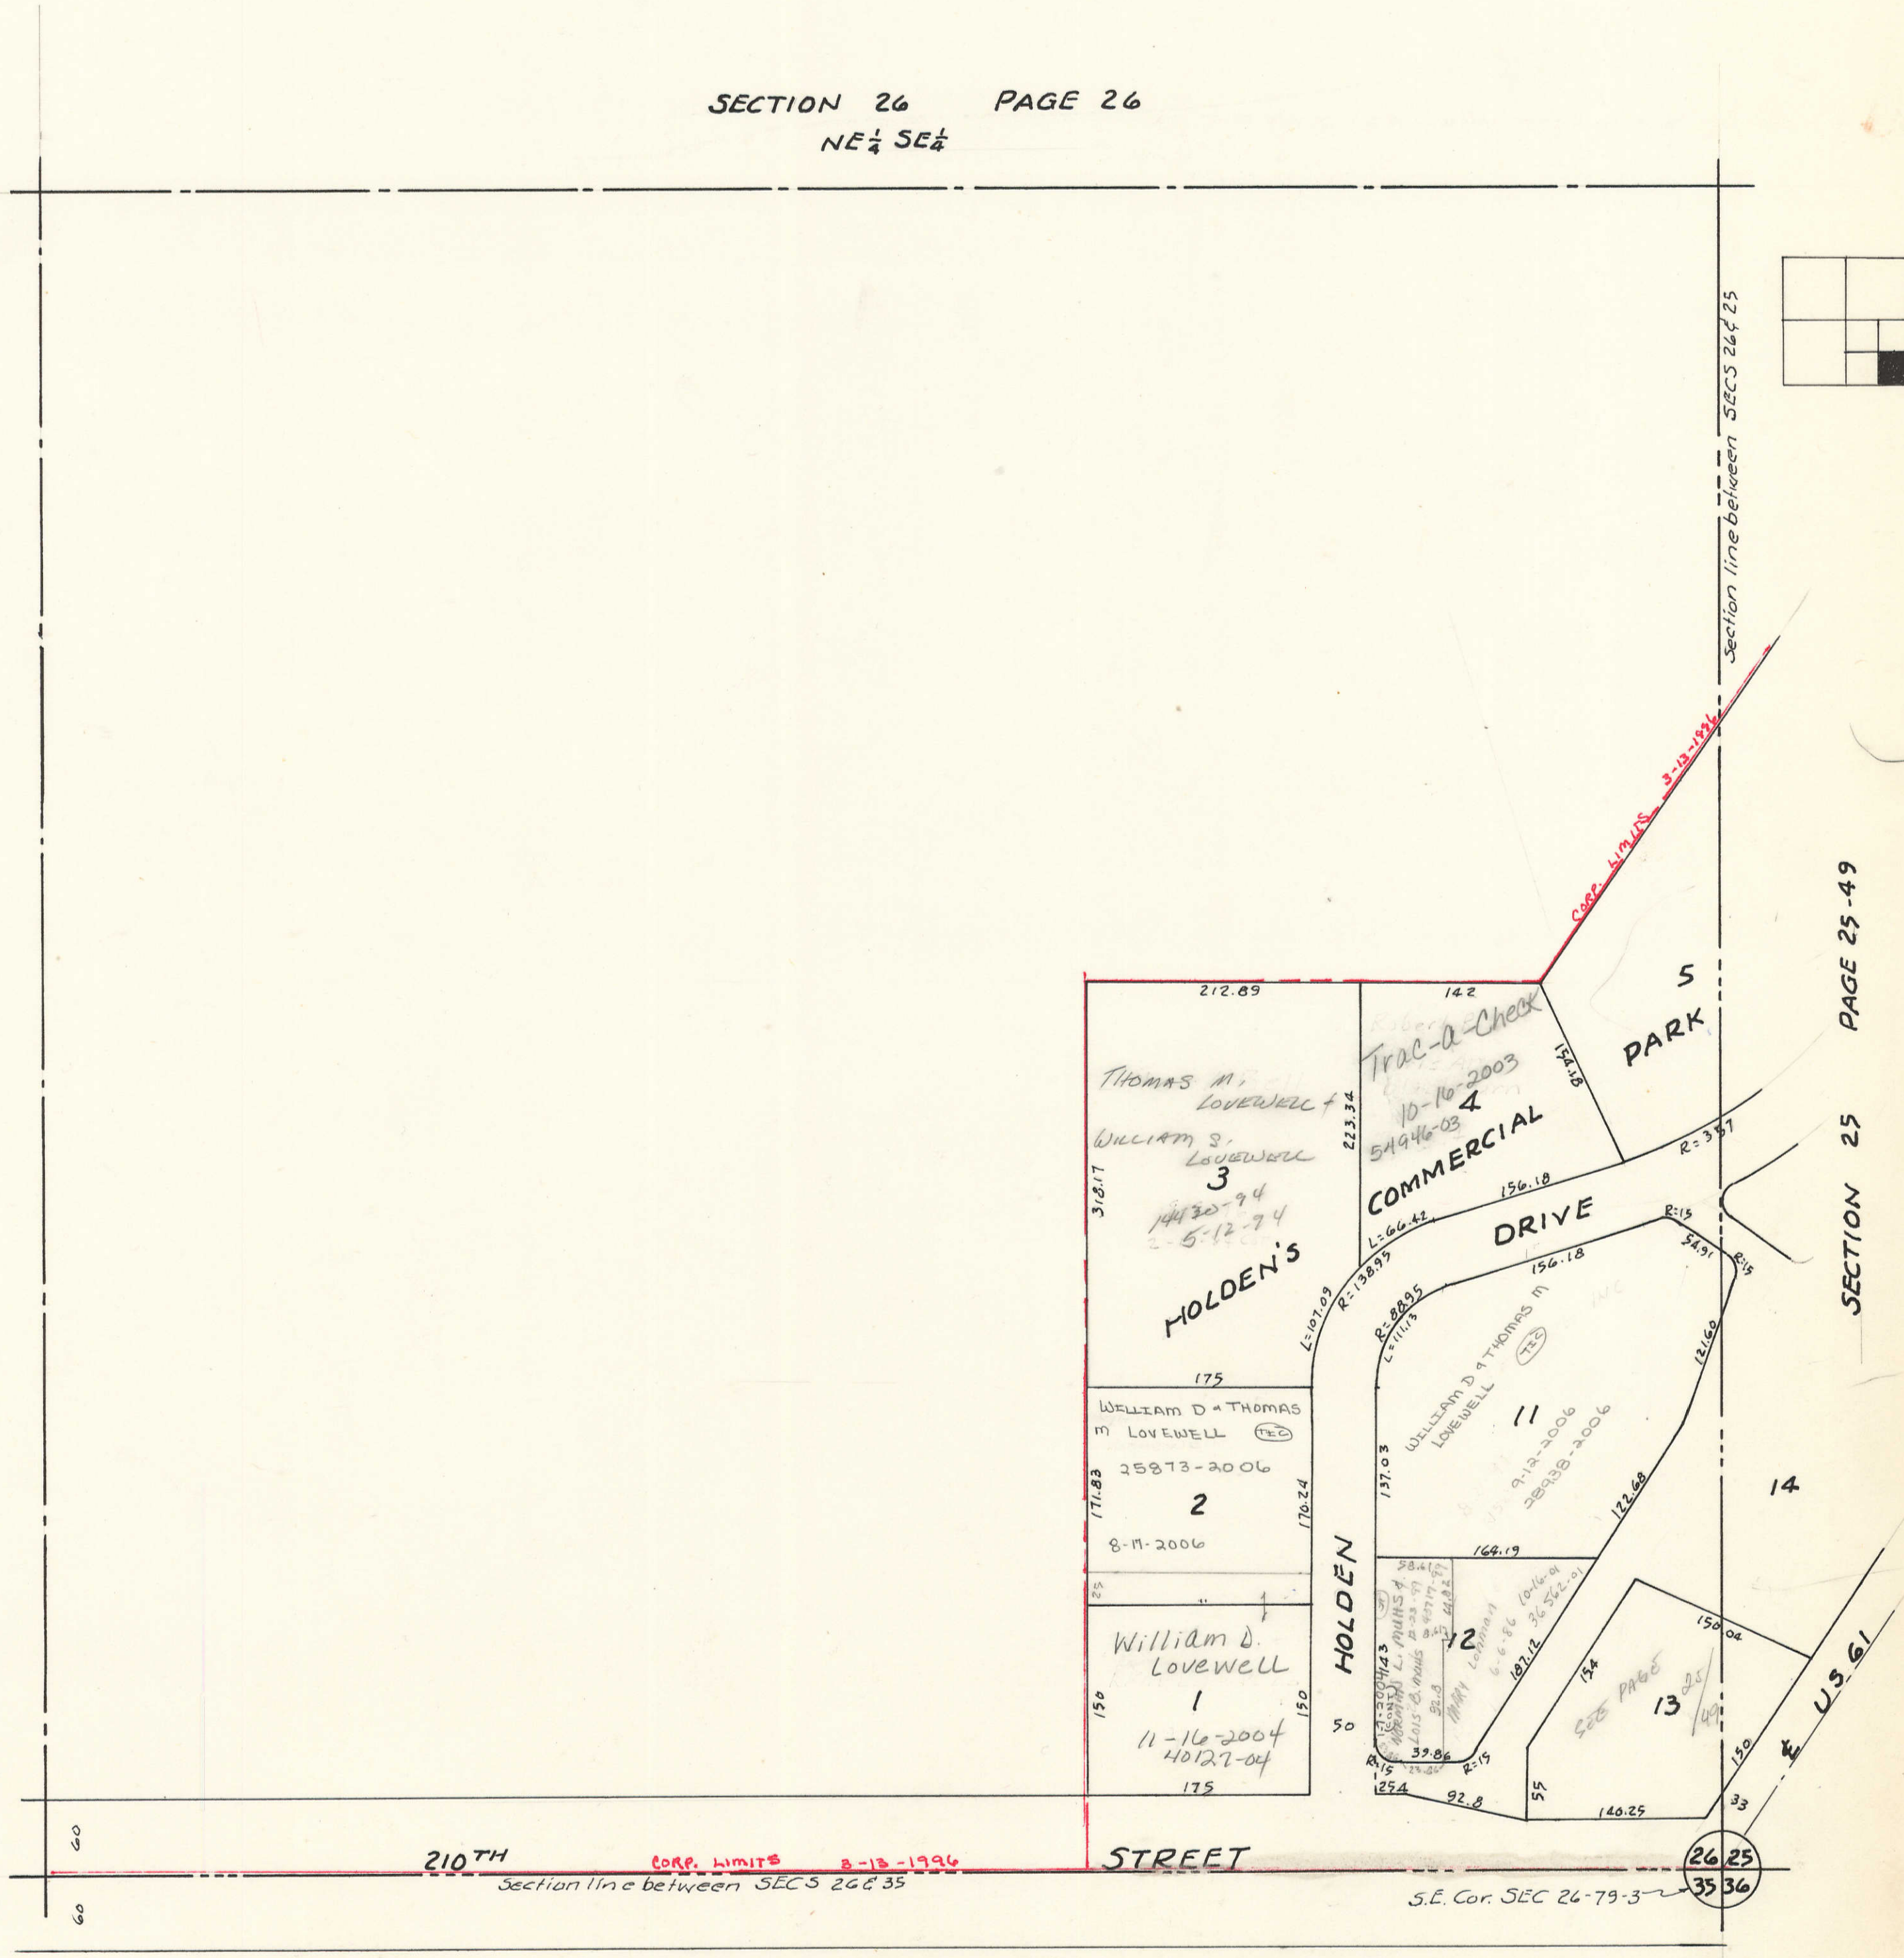


SE 1/4 SE 1/4 SEC 26-79-3
SHERIDAN TOWNSHIP
SCALE: 1 in. = 100 ft.

SECTION 26 PAGE 26
NE 1/4 SE 1/4

SECTION 26 PAGE 26
SW 1/4 SE 1/4

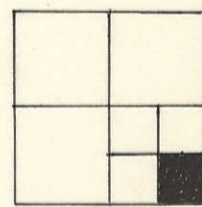

SECTION 25 PAGE 25-49

SECTION 35 PAGE 35-7