

SECTION  
32

SCALE IN CHAINS



Township 79-North; Range 3

EAST OF THE FIFTH PRINCIPAL MERIDIAN


SCOTT COUNTY, IOWA

SHERIDAN TOWNSHIP

SCALE IN FEET



Transfer Page 8lds-456

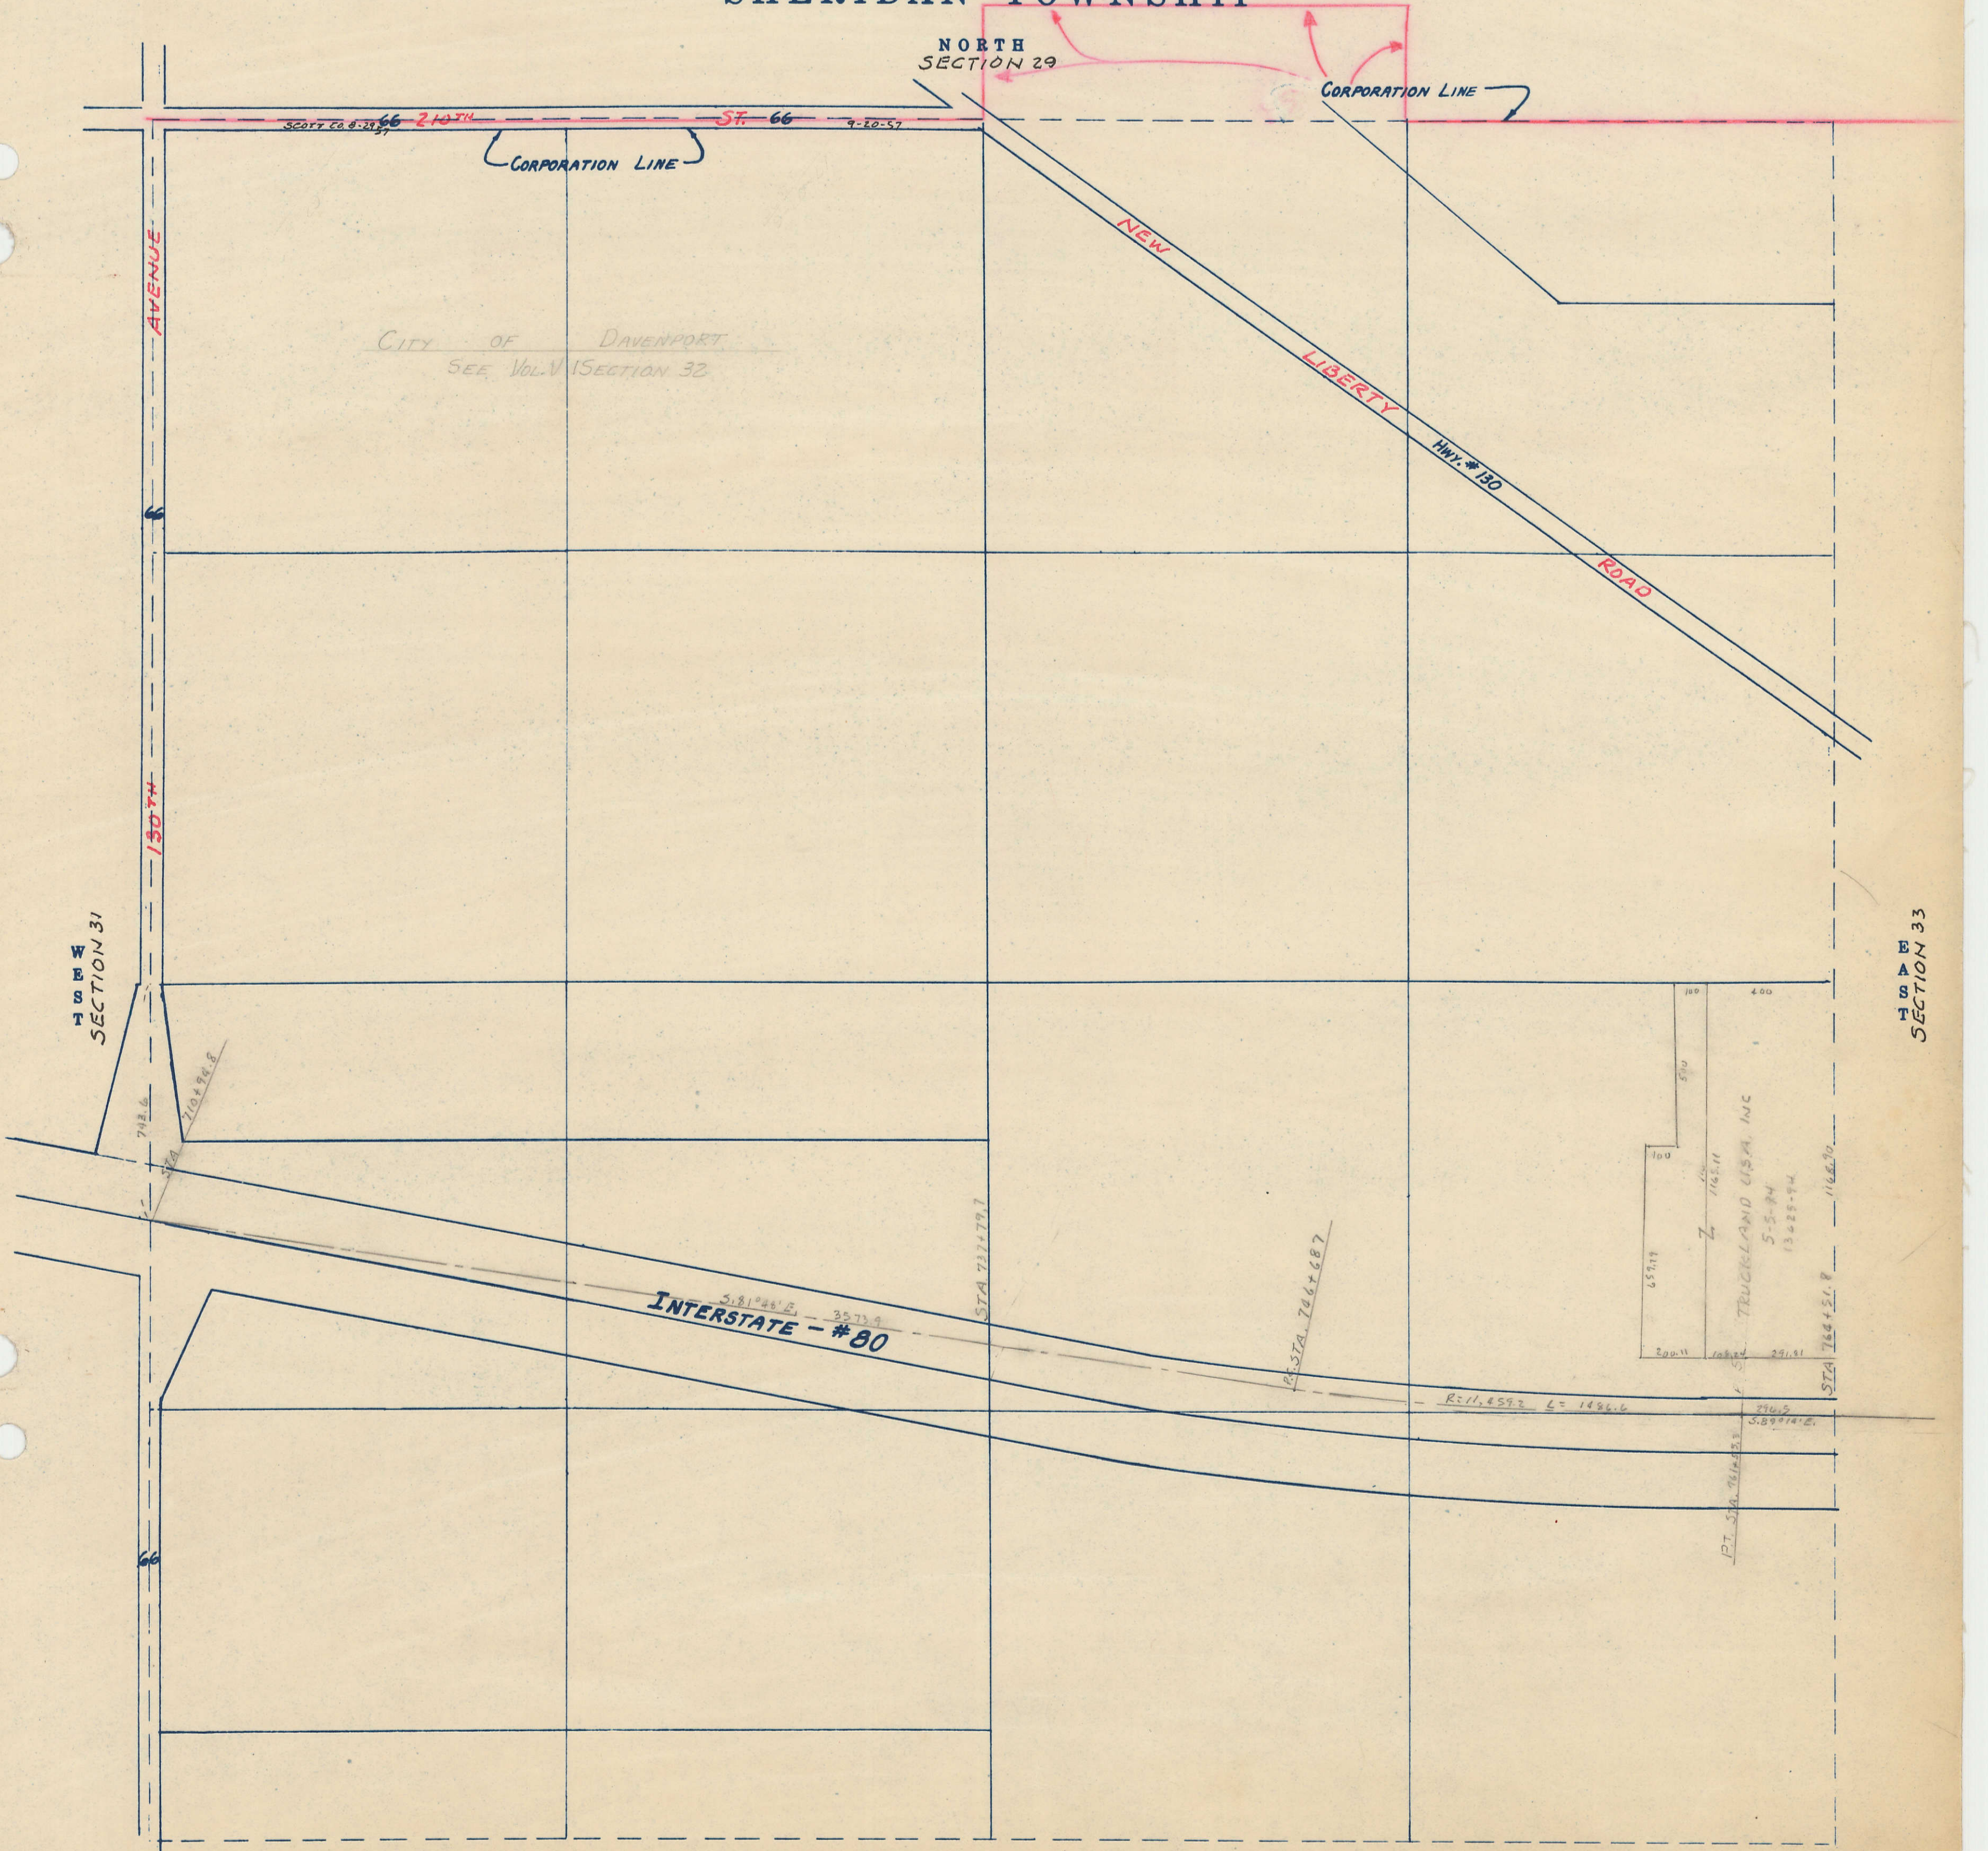

CITY OF DAVENPORT  
SEE VOL. V SECTION 32

NORTH  
SECTION 29

CORPORATION LINE

CORPORATION LINE

NEW

LIBERTY

HWY. #130

ROAD

150TH AVENUE

150TH

SECTION 31

SECTION 33

INTERSTATE - #80

