


Township No 80 N Range No 2 E 5th
 Pm Iowa in Scott Co-

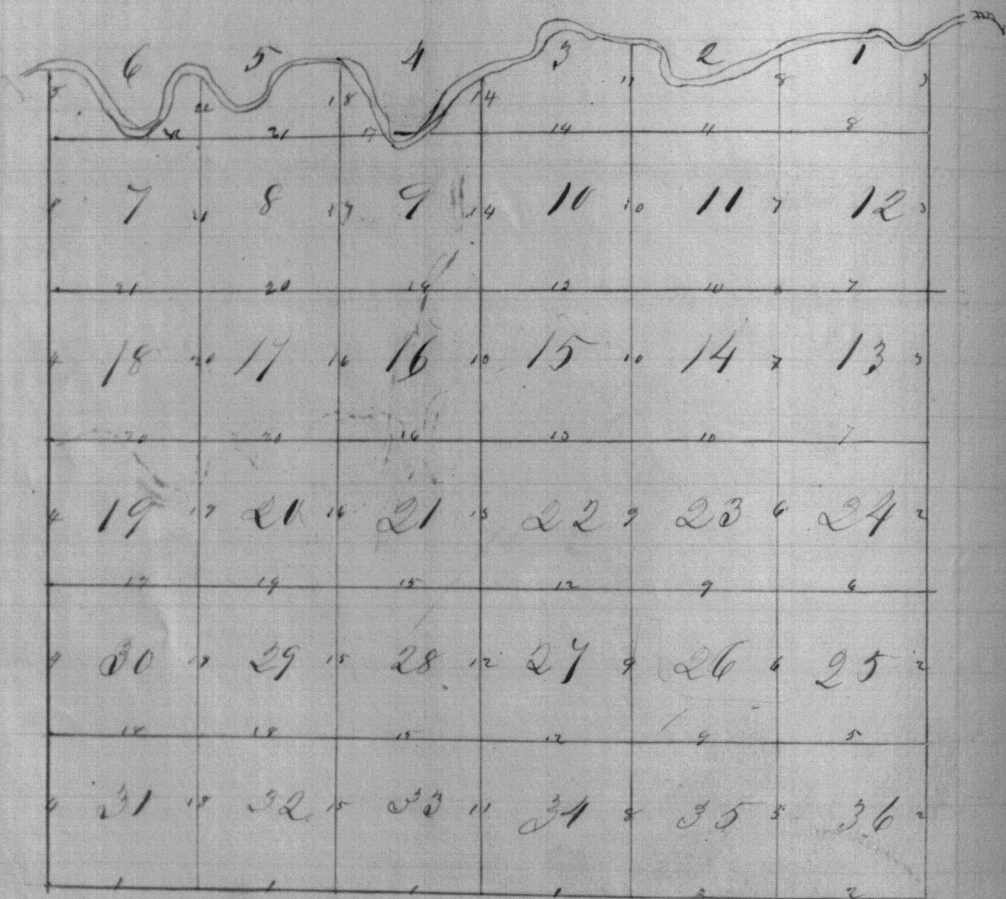

See Meandered See Pages 23, 24, 25, 26,

Demerit on 50 I Range to 30 4 1/2 in lower
Shells

North Boundary

East On the North Side of Dec 31.

Jan 5 20 6

41.24 Put a post at the 90 Dec cor made a mound of earth from a post 4th 6.

70.00 Put a mound of earth to 1st 11.

81.24 Put a post at the Cor to Dec 31 13 2 1/2
made a mound of earth post 4th 8.

East On the North Side of Dec 32.

Jan 8 17 6

1.00 Put a mound of earth to 1st 11.

40.00 Put a post at the 90 Dec cor made a mound of earth from a post 4th 11.

80.00 Put a post at the Cor to Dec 32 13 3 1/2
made a mound of earth post 4th 5.

East On the North Side of Dec 33.

Jan 8 13 6

40.00 Put a post at the 90 Dec cor made a mound of earth from a post 4th 6.

80.00 Put a post at the Cor to Dec 33 13 4 1/2
made a mound of earth post 4th 5.

Mark point of a Grove by 11 1/2 1/2.

East On the North Side of Dec 34.

Jan 8 11 6

40.00 Put a post at the 90 Dec cor made a mound of earth from a post 4th 6.

80.00 Put a post at the Cor to Dec 34 13 5 1/2
made a mound of earth post 4th 5.

the West point of Grove referred to in last line, to be at 10 1/2 1/2.

80.04
80.05
216 2 1/2
80.04

2

Ownership No 800 Range 36 S. P. De
 Truck

East On the North Side of Dec 35

Nov 8 108

40.00 Put a post at the grade corner made
 a mound of earth from a post 4th E.

80.00 Put a post at the corner Decs 35 136. made
 a mound of earth from a post 4th S.

East On the Limi. Decs 36.

Nov 8 108

12.50 To a Steam 5th mile to run No.

40.00 Put a post at the grade corner made a
 mound of earth from a post 4th E.

40.25 To a Steam 3th mile run No.

80.00 Intersect Range Lim 119 4th S of post,
 Put a post in Cor to Down 79 180 4th S
 Range 314 E made a mound of earth
 from a post 4th S.

East Boundary.

North On the East Side of Dec 36.

Nov 8 108

40.00 Put a post at the grade corner made
 a mound of earth from a post 4th E.

80.00 Put a post at the Cor to Decs 25 124
 in a mound of earth from a post 4th S

North On the East Side of Dec 25

Nov 8 108

40.00 Put a post at the grade corner made
 a mound of earth from a post 4th E.

80.00 Put a post at the Cor to Decs 24 125 S
 made a mound of earth from a post 4th S

North On the East Side of Dec 24

Nov 7 508

249


40.00 Put a post at the grade corner made
 a mound of earth from a pit 4 1/2 ft
 60.25 To a Cart 25 lbs. min. sum Mr.
 80.00 Put a post at the Cor to Dec 13 1870
 a mound of earth from a pit 4 1/2 ft.

Mark On the Vine Oct Dec 13.
 Par 7.50 C

40.00 Put a post at the grade corner made
 a mound of earth from a pit 4 1/2 ft
 59.00 To a Pond
 63.00 Over the Pond
 80.00 Put a post at the Cor to Dec 12 1870
 made a mound of earth from a pit 4 1/2 ft.

Mark On the East side of Dec 12
 Par -

30.00 Enter a mark in the AM
 40.00 Put a post for the corner to the mark
 43.00 To a mark in the AM
 60.00 To a mark in the PM
 19.75 To the River bottom
 80.00 Put a post for the Cor to Dec 12 1870
 To a Cart 16 lbs. in dia by 900 1/2 76.

Mark On the East side of Dec 1.
 Par 7.50 C

24.30 To a Mark 50 lbs. in dia by 4 1/2 ft
 36.72 To a Cart 11 lbs. in dia.
 40.00 Put a post at the grade corner.
 To a Cart 10 lbs. in dia by 900 1/2 130
 To a Cart 15 lbs. in dia by 900 1/2 60
 44.00 To a Payer 60 lbs. in dia by 900 1/2
 49.00 To a Payer 50 lbs. in dia by 900 1/2

Quadrangle No 80 of Range No 30 54th and
 55th N

34.17 To a W Oak 26 m in dia.

56.00 Entrance of Waubesa pine on River i S. S. S. S.
 a moose deer path on right bank.

A Maple 13 m in dia on N 85. W 20th

A Maple 14 m in dia by Oak 73 lb

West Boundary.

Stack On the East Side of Dec 24 7th 1872
 Jan 8th 1876

37.50 Cut a mark in the S. S. S.

40.00 Put a post at the gr. sec corner and
 a mound of earth from a post 4 lb S.

38.00 Clean the mark to an M.

30.00 Put a post at the Cor to Dec 25 1874
 made a mound of earth from a post 4 lb S.

Stack On the West Side Dec 25

Jan 8th 1876

40.00 Put a post at the gr. sec corner and
 a mound of earth from a post 4 lb S.

38.00 Put a post at the Cor to Dec 24 1874
 made a mound of earth from a post 4 lb S.

Stack On the East Side Dec 24.

Jan 8th 1876

40.00 Put a post at the gr. sec corner and
 a mound of earth from a post 4 lb S.

38.00 Put a post at the Cor to Dec 13 1874 in
 a mound of earth from a post 4 lb S.

Stack On the East Side of Dec 13;

Jan

40.00 Put a post at the gr. sec corner and
 a mound of earth from a post 4 lb S.

5


8000 Det a post at the Circle Dec 1st 1857
made a mound of earth 4 ft 6 in.

Next On the East side of Dec 12.
Jan

1.00 Enter a bottom in the
4000 Det a post with gr. sec. cor. made a
mound of earth from a pit 4 ft 6 in.

38.00 To a Slough in the W. side of the
73.25 To a Oak 14 mi in dia.

8000 Det a post at the Circle Dec 1st 1857
A Oak 16 mi in dia by a 60 ft 57 ft
An Elm 12 mi in dia by a 85 ft 57 ft

Next On the West side Dec 1.
Jan 8 1857

12.00 To a Oak 15 mi in dia.
24.75 To an Elm 14 mi in dia.
38.75 Intersect West side of the River
meander post on the right bank.
A Willow 6 mi in dia for Cor. post.

Sub division

Next On the West side Dec 3 1857
Jan

4000 Det a post at the gr. sec. cor. made
a mound of earth from a pit 4 ft 6 in.
8000 Det a post at the Circle Dec 25 2 1857
made a mound of earth, a post 4 ft 6 in.

989.50 A pond on the West side Dec 2 1857
Jan

29.50 To a stream 8 ft wide 3 ft deep N.
79.98 Intersect Park on the West side of the
gr. sec. cor.

Chattel

Wm. Comstock on the Vine Feb Dec 25/34
Nov

39.99 Put a post at the gr Dec cor made a mound of earth from a post 4th C.
79.98 Put a post at the Cor to Dec 25. 26. 35 136.

Wm. Comstock on the Vine Feb Dec 25/36
Jan

3.25 To a Steam & M^o made its runs C.
40.00 Put a post at the gr Dec cor made a mound of earth from a post 4th C.
78.60 To a Steam & M^o made its runs C.
90.50 Put a post at the Cor to Dec 23. 24. 25 126 1/2
made a mound of earth. post 4th C.

Wm. Comstock on the Vine Feb Dec 24/25
Jan

19.50 To a Steam & M^o made its runs M.
25.75 To a Steam 10th made its runs M.
79.94 Entered by Range Line 16th St of the Dec cor.

Wm. Comstock on the Vine Feb Dec 24/25
Jan

39.97 Put a post at the gr Dec cor made a mound of earth from a post 4th C.
79.94 To the post at the Cor to Dec 23. 24. 25 126

Wm. Comstock on the Vine Feb Dec 23/24
Jan

40.50 Put a post at the gr Dec cor made a mound of earth from a post 4th C.
90.50 Put a post at the cor to Dec 13. 14. 23 124
made a mound of earth. post 4th C.

7

489.456 Random on the line Feb Dec 13 24

79.88 Intersub Range Aug 27 1881 of sec 11
Jan

79.91 Connected on the line Feb Dec 13 24
Jan

79.94 Det a post at the gr sec cor made a
mound of earth from a post 4 th Co.

79.55 To the post at the Cor to Dec 13 14 25 24

North on the line Feb Dec 13 24
Jan

40.80 Det a post at the gr sec cor made a
mound of earth from a post 4 th Co.

80.70 Det a post at the cor to Dec 11 12 13 14
made a mound of earth Feb 11 12 13

489.456 Random on the line Feb Dec 12 13
Jan

79.96 Intersub Range line 10 th of sec 11
Jan

79.98 Connected on the line Feb Dec 12 13
Jan

79.98 Det a post at the gr sec cor made a
mound of earth from a post 4 th Co.

79.96 To the post at the Cor to Dec 11 12 13 14

North on the line Feb Dec 11 12
Jan

40.00 Det a post at the gr sec cor made
a mound of earth from a post 4 th Co.

40.00 Contn a bottom 13 th E 11 S.
40.00 Contn Division 13 th E 11 S.
40.00 To a blanch 13 th Co.

 Dec 11 1912

8000 Pot a spot at the Cor to Dec 1. 2. 11 1912
 N. W. Call 20 mi in dia. by 275.02 41 lb
 N. W. Call 20 mi in dia. by 271.6 39 lb

789.456 Pot and in with Vini Pot Dec 1912
 Jan

42.50 Tea Clough 23 lbs in dia. 3 sun M.
 43.00 Menta a man in M. M.
 79.59 Inture by Range Vini 5 lbs of Dec con.

789.456 Pot and in with Vini Pot Dec 1912
 Jan

39.192 Pot a spot at the 90 Dec con made
 a sign of South from a field to
 49.26 Tea Maple 15 mi in dia
 79.59 Pot a spot at the Cor to Dec 1. 2. 11 1912.

7000 Pot and in with Vini Pot Dec 1912
 Jan

24.81 Tea Clough 12 mi in dia.
 31.63 Inture by Range Vini in River & Sea
 are and in Pot in Right of Range.
 N. W. Call 12 mi in dia. by 251.0 27 lb
 N. W. Call 13 mi in dia. by 269.2 39 lb

7000 Pot and in with Vini Pot Dec 1912
 Jan

35.00 Cor to Vini in 1 lb 2 M.
 41.00 Pot a spot at the 90 Dec con made a
 N. W. Call 12 mi in dia. by 285.7 135
 N. W. Call 15 mi in dia. by 274.6 152
 39.47 Tea Clough 15 mi in dia.
 81.00 Pot a spot at the Cor to Dec 1. 2. 11 1912
 N. W. Call 16 mi in dia. by 277.9 41 lb
 N. W. Call 20 mi in dia. by 276.6 40 lb

9

Y99508 Random on the Vine Job Dec 26 1855

5.50 Vignette on the Vine Job Dec 26 1855
8075 Contracted with M. M. M. 12 1855

Went Contracted on the Vine Job Dec 26 1855
Jan

40.00 Detached at the gr. Dec 26 1855 made a mound of earth from a pit 4th Co.
8075 Detached at the Corde Dec 26 27 34 1855

Next Contracted Vine Job Dec 26 1855
Jan 79.41

2.50 Contracted on the Vine Job Dec 26 1855
40.00 Detached at the gr. Dec 26 1855 made a mound of earth from a pit 4th Co.
8075 Detached at the Corde Dec 26 27 34 1855 made a mound of earth from a pit 4th Co.

100
59
79.41
80
79.59
+ 41

Y99408 Random on the Vine Job Dec 23 1854
Jan

80.14 Contracted with M. M. M. 24 1854

Went Contracted on the Vine Job Dec 23 1854
Jan

40.07 Detached at the gr. Dec 23 1854 made a mound of earth from a pit 4th Co.
80.14 Detached at the Corde Dec 22 23 26 1854

Next Contracted Vine Job Dec 22 1853
Jan

40.00 Detached at the gr. Dec 22 1853 made a mound of earth from a pit 4th Co.
30.00 Detached at the Corde Dec 14 15 22 1853 made a mound of earth from a pit 4th Co.

Ch. 225

489506 Random on the Vm Feb Dec 14 183
Jan

5007 Entered by the Vm at Cor to Dec.

West Comitia on the Vm Feb Dec 14 183
Jan

40032 Det a part at the gr Dec cor made a
mannd of Eack from a part 4th E.

5007 Det a part with Cor to Dec 14 15, 22 183

Jack on the Vm Feb Dec 14 15.
Jan

4000 Det a part at the gr Dec cor made a
mannd of Eack from a part 4th E.

5000 Det a part with Cor to Dec 14 15 18
made a mannd of Eack Feb 4th S.

489536 Random on the Vm Feb Dec 11 14
Jan

5010 Entered by the Vm 15th N of Dec cor.

West Comitia on the Vm Feb Dec 11 14
Jan

4000 Det a part at the gr Dec cor made
a mannd of Eack from a part 4th E.

5010 Det a part with Cor to Dec 14 15.

Jack on the Vm Feb Dec 10 11.
Jan

4000 Det a part at the gr Dec cor made
a mannd of Eack Feb 4th E.

6000 Entered at Mem 13 to E. H.

5010 Det a part with Cor to Dec 23 10 11 13
made a mannd of Eack Feb 4th S.


East Random on the Lim Feb Dec 2111

16.50 To a Cough 151 Lk. ...
80.17 Antares ...

West Concord on the Lim Feb Dec 2111

11.88 To a ...
28.73 To a ...
40.80 Det a ...
60.00 To a ...
80.17 To the ...

North on the Lim Feb Dec 213

23.50 To a ...
28.00 On the ...
30.27 To a ...
40.00 Det a ...
45.74 Antares ...

North on the Lim Feb Dec 33/34

40.50 Det a ...
...
40.50 ...


55.11 To ad 2 Oak 16 mi in dea.
 80.00 Det a prob as the Corde Recs 27 28 33 34
 Ad Oak 20 mi in dea by 116 29 16
 Ad Oak 12 mi in dea by 146 112 16

189455 Random on the Uni Feb Dec 29 134
 Jan

80.01 Interest on \$1000 26 lbs of Dec Cor.

144 Feb Comd on the Uni Feb Dec 27 134
 Jan

14.22 To ad Hickory 16 mi in dea.

27.88 To ad Oak 15 mi in dea.

40.00 Det a prob with the Dec Cor made a dea
 made a mound of earth from a prob 4 lbs
 Ad Oak 11 mi in dea by 150 29
 Ad Oak 11 mi in dea by 118 21 26.

90.01 To the prob as the Corde Recs 27 28 33 34.

Part on the Uni Feb Dec 27 128
 Jan

30.25 To ad Red Oak 16 mi in dea.

41.00 Det a prob as the Dec Cor
 Ad Oak 20 mi in dea by 156 45 15
 Ad Oak 10 mi in dea by 119 16 97 16
 made a mound of earth 10 lbs

13.25 To a Steer 8 lbs made of sum Mr.

80.00 Det a prob as the Corde Recs 27 28 33 34
 made a mound of earth Feb 4 lbs 5.

189456 Random on the Uni Feb Dec 22 127

79.94 Interest on \$1000 12 lbs of Dec Cor

12

1895

Yacht Cometa on the Sim. Dec 21/22 (27/22)

39.91 Det a prob at the op. Dec cor made a
mandate of health from a Feb 4th E.
79.94 At the prob at the Cor to Dec 21. 22 27/22.

Yacht On the Sim. Dec 21/22.

40.00 Det a prob at the op. Dec cor made
a mandate of health from a Feb 4th E.
80.00 Det a prob at the Cor Dec 13. 16. 21/22.
made a mandate of health Feb 4th S.

189.506 Pand on on the Sim. Dec 15/22

79.91 Intussus. M. Sim 7th. 14 Dec cor.

Yacht Cometa on the Sim. Dec 15/22

39.95 Det a prob at the op. Dec cor made a
mandate of health from a Feb 4th E.
79.91 At the prob at the Cor Dec 13. 16. 21/22.

Yacht On the Sim. Dec 15/16.

40.00 Det a prob at the op. Dec cor made a
mandate of health from a Feb 4th E.
80.00 Det a prob at the Cor Dec 9. 10. 15/16
made a mandate of health from a Feb 4th S.

189.506 Pand on on the Sim. Dec 10/16

81.00 Intussus. M. Sim at the Dec cor.

18th

West Conceded on the Xmi (18) Dec 10 115.
Jan

4011 Det a part with the go Dec 10 made a
manud of land from a part 4th E.

4152 Det a part with the cor to Dec 9. 10. 15. 16.

North Conceded on the Xmi (18) Dec 9 110

4150 Det a part with the go Dec 10 made a
manud of land from a part 4th E.

4450 Enter a bottom 3th & 4th.

4500 Det a part with the cor to Dec 3. 4. 9 110
made a manud of land part 4th E.

East Pandora on the Xmi (18) Dec 3 110

4250 Goat Pond.

5125 Over the Road.

8016 Antaresch Medicine at Cor.

West Conceded on the Xmi (18) Dec 3 110

4003 Det a part with the go Dec 10 made
a manud of land from a part 2th E.

4106 Det a part with the cor to Dec 3. 4. 9 110.

North Conceded on the Xmi (18) Dec 3 111

3425 Enter Pandora 10th E 11th.

3450 Antaresch, Right Part of Pandora
River Sub a manud part.

At Milton 9 mi in dist by 22 1/2 E 31 1/2 N
At Milton 11 mi in dist by 26 1/2 West.

Parish No 80 of Range No 5 of the
County

189451a Con the Vm Feb Dec 30 1893

Jan

40.00 Put a post at the grade corner made
a mound of Earth from a post 4th E.

80.00 Put a post at the corner Dec 28 29 30 1893
Made a mound of Earth Feb 4th S.

189452a Randon on the Vm Feb Dec 28 1893

Jan

61.50 Split Ditch 1/2 W. S.

79.92 Intersect NW Vm 8th N of Sec cor.

West Corner on the Vm Feb Dec 28 1893

Jan

39.96 Put a post at the grade corner made a
mound of Earth from a post 4th E.

79.92 Put a post at the corner Dec 28 29 30 1893.

189453a Con the Vm Feb Dec 28 1893

Jan

40.00 Put a post at the grade corner made a
mound of Earth from a post 4th E.

80.00 Put a post at the corner Dec 20 21 28 1893.
Made a mound of Earth Feb 4th S.

189454a Randon on the Vm Feb Dec 21 1893

Jan

75.00 Split stream 1/2 W. S.

80.01 Intersect NW Vm at corner Sec -

West Corner on the Vm Feb Dec 21 1893

Jan

40.00 Put a post at the grade corner made
a mound of Earth from a post 4th E.

Quintipeto San Range No. 2. E. of D. H. Co.
the 1st

5001 1/2 the part at the Cor to Decs 20. 21. 22. 23.

North On the Line Feb Decs 20 1911
Jan

4000 Put a post at the 90 sec cor made
a mound of earth from a post 4th 6.

5010 Put a post at the Cor to Decs 16. 17. 20. 21
made a mound of earth Feb 4th 5.

189.357 Pandon on the Line Feb Decs 16 1911
Jan

28.25 To a stake 15th mile S. run N.

5010 Put a post at the Line 23 1/2 S of sec cor.

West Connected on the Line Feb Decs 16 1911
Jan

4005 Put a post at the 90 sec cor made a
mound of earth from a post 4th 6.

5010 Put a post at the Cor to Decs 16. 17. 20. 21

North On the Line Feb Decs 16 1911
Jan

4000 Put a post at the 90 sec cor made
a mound of earth from a post 4th 6.

5010 Put a post at the Cor to Decs 8. 9. 16 17.
made a mound of earth Feb 4th 5.

189.358 Pandon on the Line Feb Decs 9 1911
Jan

21.70 To a stake 15th mile run N.

79.70 Put a post at the Line 12th S of sec cor.

West Connected on the Line Feb Decs 9 1911
Jan


39.96 Put a post at the ...
79.93 ...

Part ...

35.00 ...
40.00 ...
57.00 ...
71.50 ...
74.10 ...
81.77 ...

... on the ...

10.95 ...
29.58 ...
51.00 ...
80.00 ...

... on the ...

29.00 ...
50.42 ...
58.83 ...
80.00 ...

Dominion of the Range 36 5 PM
at 14

North Concho Sim. Co Dec 4 13
Jan


North Concho Sim. Co Dec 31 132
Jan

- 4.00 Put a post at the grade corner of made a
Mound of Cauch from April 4th to
- 8.00 Put a post at the Cor to Dec 29. 30. 31 132
made a mound of Cauch. Put 4th 5.

1894 16 Random on the Vini Dec 29 132
Jan

- 8.00 Interest on the Vini 31 the 1st Dec 132

West Concho on the Vini Dec 29 132
Jan

- 11.01 Put a post at the grade corner made a
mound of Cauch from April 4th to
- 5.00 Put a post at the Cor to Dec 29. 30. 31 132.

1895 17 Random on the Vini Dec 30 131
Jan

- 8.01 Interest Range Vini 44 the 1st Dec 132

East Concho on the Vini Dec 31 131
Jan

- 11.01 Put a post at the grade corner made a
Mound of Cauch from April 4th to
- 8.01 Put a post at the Cor to Dec 29. 30. 31 132

19

North On the Vinteb Dec 29 1880

4000 Det a post at the 90 Dec 1880 made a mound of earth from a pit 4th E

8000 Det a post at the Cor to Dec 19. 20. 29 1880
Made a mound of E with pit 4th E.

189356 Tandon on the Vinteb Dec 20 1889

8008 Intusech of S Vinteb 9th Dec 1880

West Comcha on the Vinteb Dec 20 1889

4004 Det a post at the 90 Dec 1880 made a mound of earth from a pit 4th E

8018 Det a post at the Cor to Dec 19. 20. 29 1880

189257 Tandon on the Vinteb Dec 20 1889

8009 Intusech of Paradise 17th Dec 1880

East Comcha on the Vinteb Dec 19 1880

4009 Det a post at the 90 Dec 1880 made a mound of earth from a pit 4th E.

8009 Det a post at the Cor to Dec 19. 20. 29 1880

North On the Vinteb Dec 19 1880

4000 Det a post at the 90 Dec 1880 made a mound of earth from a pit 4th E.

8000 Det a post at the Cor to Dec 17. 18. 19 1880
Made a mound of earth pit 4th E.

21

Friendship to St of Range No 3 to 5th Ph 6th
 the 14

1893⁵ Randon on the Vine to Dec 17 20
 Jan

79.91 Intersect of Vine at the Cor

Wish Comcha on the Vine to Dec 17 20
 Jan

39.99 Det a post at the gr dec cor I made a
 mound of earth from a pit 4th E.

79.78 To the post at the Cor to Dec 17. 18. 19 20

189.11 Randon on the Vine to Dec 18 19
 Jan

79.43 Intersect of Range Vine 34th S of Dec cor.

Wish Comcha on the Vine to Dec 18 19
 Jan

39.43 Det a post at the gr dec cor I made
 a mound of earth from a pit 4th E.

79.43 To the post at the Cor to Dec 17. 18. 19 20

Wish Comcha on the Vine to Dec 17 18
 Jan

40.00 Det a post at the gr dec cor I made
 a mound of earth from a pit 4th E.

50.00 Det a post at the Cor to 7. 8. 17 18
 I made a mound of earth pit 4th S.

189.25 Randon on the Vine to Dec 8 17
 Jan

79.94 Intersect of Vine at the Cor

Wish Comcha on the Vine to Dec 8 17
 Jan

39.77 Det a post at the gr dec cor I made a
 mound of earth from a pit 4th E.

79.94 Township No 80 N Range No 3 West The Iowa
Chas 13

79.94 Set a point at the Cor to Sec 7. S. 17. 115.
Jan

88.55 1/2 A land on the line bet Sec 7 115
Jan

79.42 Section of Range line 21 the N of sec cor.
Jan

Can Connected on the line bet Sec 7 115
Jan

39.42 Set a point at the gr sec cor make a
mound of earth from a post 4 th Co.

79.42 Set the post at the cor to Sec 7. S. 17. 115.
Jan

Stack On the line bet Sec 7 115
Jan

20.00 To a survey mark in the E.M.
Jan

32.00 Over the mark.
Jan

10.00 Set a post at the gr sec cor. make
a mound of earth from a post 4 th Co.

74.75 Under a post in the E.M.
80.03

80.00 Set a post at the Cor to Sec 5. S. 6. 115.
make a mound of earth from post 4 th Co.

189.35 1/2 Pand on the line bet Sec 5 115
Jan

31.00 To a survey mark in the E.M.
Duck 4.00 ch
Post E 9.00 ch
Stack 4.00 ch to line.

10.00 Over mark
76.75 Under line in the E.M.
80.03 Section of MS line 11 the E of sec cor.

Post Connected on the line bet Sec 5 115
Jan

Peninsula No 801 Range 30 500m

Upper Comcha on the Line at Sec 575
Van

40.00 Set a post at the top sec cor made a mound of earth from a post 4th E.
In Elm 14 m in dia by 111 to 140 lb
1st Oak 18 m in dia by 150 lb 226 lb
8003 To the post at the Cor to Sec 5.6.7.8.

Lower Comcha on the Line at Sec 617
Van

2015 Right bank of Mataponi River run 26
3100 In on Right bank of River
5400 High 20 lb run 16 m in dia 26.
7972 enclosed 1/2 Boundary 42 lb 10/10 Sec cor.

East Comcha on the Line Sec 617
Van

In Elm 12 m in dia by 189 to 172 lb
1st Oak 15 m in dia by 138 to 65 lb
908 To a post at 15 m in dia.
39.72 Set a post at the top sec cor made a mound of earth post 4 lb E.
79.72 To the Cor to Sec 5.6.7.8.

North Comcha on the Line Sec 516.
Van

2900 Enter Dumber is 10 E 115.
10.11 Set a post at the top sec cor made a mound of earth from a post 4 lb E
1st Oak - 1 m in dia by 189 to 111.
1st Oak 18 m in dia by 170 to 158.
49.51 At 13th Mataponi River a mound of earth.
at Dumber 10 m in dia by 130 to 111 lb.
at Dumber 9 m in dia by 115 to 9 lb.


Miandes of Habespinica River.
Beginning at a mean da just on the
Curb Sunday on right bank. Thence up
- Huam

Time	Sub	In Vic. 1.
175 W	4.00	
185 W	9.00	
192 E	10.50	
156 W	4.00	
187 W	11.50	
138 W	117.50	
140 W	4.00	
141 W	5.50	
173 W	11.00	
187 W	7.50	
197 W	9.00	
104 W	6.00	
181 W	10.50	

139 W 9.29 To the spot in time of the 1st 2.

Time	Sub	In Vic. 2
167 W	7.00	
169 W	8.50	
191 W	10.00	
145 W	12.10	
150 W	11.00	
165 W	9.00	
165 W	3.50	
126 W	5.50	
119 E	4.50	
160 E	8.50	
132 E	3.50	
141 W	5.00	
167 W	12.00	


Case	Sept	
134:11	15.11	
480:11	5.95	to the great in line with Dec 213.

In Dec 3.

284:11	6.51
--------	------

100:11	5.50
--------	------

181:11	4.50
--------	------

172:11	7.00
--------	------

140:11	9.00
--------	------

184:11	11.00
--------	-------

234:11	6.00
--------	------

1130:11	21.00
---------	-------

2374:11	16.50
---------	-------

450:11	7.50
--------	------

182:11	16.45	to the great in line with Dec 314.
--------	-------	------------------------------------

In Dec 11.

193:11	6.00
--------	------

493:11	9.00
--------	------

250:11	4.00
--------	------

67:11	25.00
-------	-------

244:11	6.00
--------	------

259:11	4.17	to the great at the Cor to 419.
--------	------	---------------------------------

In Dec 9.

258:11	6.15
--------	------

100:11	7.50
--------	------

180:11	6.00
--------	------

131:11	3.50	to the great in line with Dec 419.
--------	------	------------------------------------

In Dec 1.

182:11	4.48
--------	------

113:11	5.00	At 420 ch, Cash for the Rest.
--------	------	-------------------------------

142:11	14.50
--------	-------


Case	Seab
1166	5.00
1447	4.00
1711	14.00
1707	5.00
1687	5.00
1187	13.00

Do the first in Dec 4-5.

In Dec 5.

1777	20.00
1877	10.00
1717	7.00
1757	7.50
1874	10.00
1747	5.00
1657	6.50
1847	5.50
1897	20.00
1746	7.00
1227	5.00
1647	8.50
1757	3.19

Do the first in Dec 5-6.

In Dec 6.

1847	11.50
1657	4.50
1327	4.50
1757	9.00
1897	11.50
1207	6.50
1137	7.50
1297	12.00
1577	5.00
1867	7.50


137.11	6.00	
134.11	20.00	
132.11	14.00	
130.11	12.00	
134.11	9.11	
138.11	5.50	
161.11	8.50	
138.11	7.24	To Kana in on next Sunday.

A Copy that the foregoing is a correct
 copy of the Records of the said notes
 Dubuque Iowa 1856

Gen. Secy.

Law

U

)

276

5

History of the ...

...

...

