


Indy Liagam Jan 30 1826 to Scott to Sam

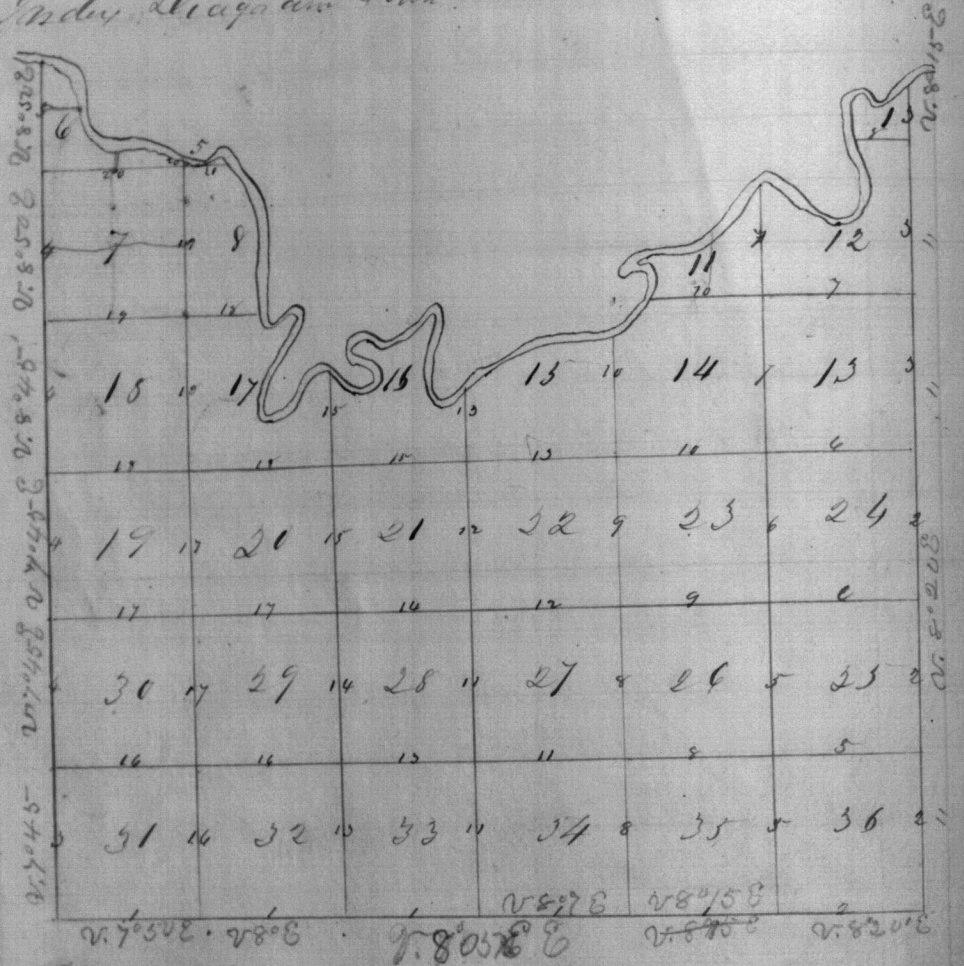

For Meander Dec 1826, 21, 22, 23, 24, 25, 1826.



1  
I was high at 81.5 D. Longitude 2 6 5 1/2 N. Lat. 1000  
April 15

Each Boundary.

East On the South Side of Dec 31.  
Jan 7. 57

41.35 Det a post at the grade cor made a mound  
of earth from a pit 4th C.

45.35 To a post 55 To make in same place

70.00 To a post 20 To make in same place

81.35 Det a post at the cor to Dec 31 13 2 1/2  
made a mound of earth from pit 4th C.

East On the South Side of Dec 32.  
Jan 8. 57

40.35 Det a post at the grade cor made a  
mound of earth from a pit 4th C.

38.35 To a post in N. 1/2 S.

80.50 Det a post at the cor to Dec 32 13 3. 1/2  
made a mound from a pit 4th C.

East On the South Side of Dec 33.  
Jan 9. 57

40.00 Det a post at the grade cor made a  
mound of earth from a pit 4th C.

42.55 To a post in N. 1/2 S.

80.00 Det a post at the cor to Dec 33 13 4. 1/2  
made a mound of earth from pit 4th C.

East On the South Side of Dec 34.  
Jan 10. 57

40.00 Det a post at the grade cor made a  
mound of earth from a pit 4th C.

90.00 Det a post at the cor to Dec 34 13 5.  
made a mound of earth from pit 4th C.

East On the South Side of Dec 35.  
Jan 11. 57



Thursday Nov 80 D.R. Camp No 2 E. & S. M. Co.  
Chas.

4000 Set a post at the grade cor made  
a mound of earth from a pit 4th C.  
5000 Set a post at the Cor to Sec 35 56 1  
made a mound of earth pit 4th S.

East On the South Side of Sec 34  
Van 8.206

4000 Set a post at the grade cor made  
a mound of earth from a pit 4th C.  
5000 Entered Camp Van 22 M. Set cor  
Set a post at the Cor to Sec 35 56 1  
19 & set Camp 213 E made a  
mound of earth from a pit 4th S.

East Boundary.

South On the East Side of Sec 36  
Van 8.208

37.50 Enter a marsh is as W.  
4000 Set a post at the grade cor made  
a mound from a pit 4th C.  
5000 Near the marsh is as W.  
5000 Set a post at the Cor to Sec 25 56 1  
made a mound of earth pit 4th E.

South On the South Side Sec 25  
Van 8.209

4000 Set a post at the grade cor made  
a mound from a pit 4th C.  
5000 Set a post at the Cor to Sec 24 56 1  
a mound of earth from a pit 4th S.

South On the East Side of Sec 24  
Van 8.207

4000 Set a post at the grade cor made



3  
Dumontup de roltamp ch 2650m June  
Cru.

Mound of Earth from a pit 4th C.  
800 Det a pit at the grade Dec 13 1847  
made a mound of Earth pit 4th C.

South On the East Side of Dec 13.

4000 Det a pit at the grade Dec 13 1847  
made a mound of Earth from a pit 4th C.  
8000 Det a pit at the grade Dec 13 1847 made  
a mound of Earth from a pit 4th C.

South On the East Side of Dec 12

100 Enter at bottom ch m. 16  
400 Det a pit at the grade Dec 12 1847 made a  
mound of Earth from a pit 4th C.  
5800 Enter at bottom ch m. 16  
7325 Det a pit at the grade Dec 12 1847  
8000 Det a pit at the grade Dec 12 1847  
at W. C. 16 m in dia by 40 ft 57 lb  
At W. C. 12 m in dia by 38 ft 75 lb

South On the East Side of Dec 1.

12.30 To ash C. 15 m in dia  
24.75 To ash C. 24 m in dia  
38.75 Entered Habesponicon River and set  
a Willow Gen in a full made pit 4th C.

West Boundary.

South On the East Side Dec 31 1800 R. 6.  
Cart 456

4000 Det a pit at the grade Dec 31 1800 made a  
mound of Earth from a pit 4th C.







5

Friendship No 8000 Ranch on the ...

North Ancho East side of ...

- 4000 Det a part at the ... made a mound of earth from a pit 4 ft ...
- 5700 ... the ...
- 5900 ...
- 6307 ...
- 6400 ...
- 6401 ...

Subdivision

No 1006 Ancho Vin ...

- 4400 Det a part with ... made a mound of earth from a pit 4 ft ...
- 6500 ...
- 7878 ...
- 8100 Det a part with ... made a mound of earth from ...

East Pand on the Vin ...

- 8002 ...

West ... on the Vin ...

- 8101 ...
- 8102 ...

No 1006 Ancho Vin ...

- 4000 Det a part at the ... made a







7

Dumfries to 80 W. Penn. to 16 5 P. M. Penn.  
Chas

10100 On the Penn. to Dec 13 114

Jan

- 31.50 On the prairie bottom at 11 6.
- 41.00 Det a prob at the 90 Dec cor 100 ad
- 50.00 a mound of Cauch from a pit 4 6 6.
- 80.00 Det a prob at the cor 11, 12, 13, 14
- top made a mound of Cauch pit 4 6 5.

189.500 On a Random bit Dec 12 113

Jan

- 32.00 On a Pond
- 41.50 On a Pond
- 78.00 On the bottom of a pond
- 80.17 Entused Range on the Dec cor.

Miss Concha on the Penn. to Dec 12 113

Jan

- 40.00 Det a prob at the 90 Dec cor in Pond.
- 80.17 On the prob at the cor 11, 12, 13, 14.

North On the Penn. to Dec 11 112

Jan

- 17.38 On a mound 20 mi in dia.
- 17.50 On Allen Creek 60 mi in dia.
- 22.00 On a mound 20 mi in dia.
- 33.50 On a mound 50 mi in dia.
- 40.00 Det a prob at the 90 Dec cor.
- at 3 Oak 10 mi in dia by 162 to 10
- at 1 Elm 15 mi in dia by 162 to 42
- 47.50 On a mound 18 mi in dia.
- 64.50 On a mound 18 mi in dia
- 70.00 On a mound 18 mi in dia
- at 1 Elm 10 mi in dia by 161 to 75 1/2
- at 1 Elm 8 mi in dia by 161 to 11 1/2



Quantities of Soil & Sand on the Vin. (5<sup>th</sup> Dec 12)

189455 Quantities of Soil & Sand on the Vin. (5<sup>th</sup> Dec 12)

- 17.00 Near the Call 15 mi in dia.
- 28.29 Near Hickory 12 mi in dia.
- 34.39 Right bank of the Amberjini confluence  
 Has a meander point.  
 Hickory 9 mi in dia. 1826 22 1/2  
 Call 14 mi in dia. 1826 31 1/2

189456 Quantities of Soil & Sand on the Vin. (5<sup>th</sup> Dec 12)

- 15.00 Enter the Sunn. Julia in 10 ch.
- 40.00 Put a post at the 90 Dec cor & made  
 a mound of earth from a post 4th cor.
- 68.00 Enter a meander in the S. 100.
- 81.00 Near the meander post for 26. 27. 34 1/2.  
 Call 20 mi in dia. 1826 43  
 Call 15 mi in dia. 1826 47 1/2

189456 Quantities of Soil & Sand on the Vin. (5<sup>th</sup> Dec 12)

- 2525. Near the meander in the S. 100.
- 51.00 Enter a meander in the S. 100.
- 75.57 Near the meander
- 80.01 Enter the meander in the S. 100.

189456 Quantities of Soil & Sand on the Vin. (5<sup>th</sup> Dec 12)

- 40.00 Put a post at the 90 Dec cor & made a  
 mound of earth from a post 4th cor.
- 81.00 To the post at the Cor. Dec 26. 27. 34 1/2.

189456 Quantities of Soil & Sand on the Vin. (5<sup>th</sup> Dec 12)

189456



Membership of 8000 11 months 2 Oct 1927

- 5.00 Enter Allen Store
- 14.76 Boat 2 Call 15 min in dia.
- 18.00 Linnis 2 Fuller Lane 11 West 2 chs.
- 35.21 Boat 2 Call 12 min in dia.
- 40.00 Boat 2 Call 15 min in dia by 146 97 109









Demerits of the South American I C 57  
Ch 21

- 4446 Lead & Call 28 ins in dia.
- 4800 Center a grain bottom to to 11 1/2.
- 51.00 Set a post at the cor to Dec 14 10 22 125  
off h call 13 ins in dia by 142 6 165  
off h call 18 ins in dia by 154 7 160

189456 Land on with Vine lot Dec 14 125  
Pan

- 2400 Center Vine, 10 to 11 1/2.
- 25.20 Allens back to the main room No.
- 35.25 Allens back to the main room No.
- 38.00 Lead the bottom to the No.
- 51.18 Entrance of the Vine 27 No. of Dec cor.

189457 Land on with Vine lot Dec 14 125  
Pan

- 2413 Lead & Call 15 ins in dia.
- 40.59 Set a post at the cor Dec cor  
off h call 26 ins in dia by 115 7 48  
off h call 15 ins in dia by 14 7 33
- 51.18 Set a post at the cor to Dec 14 15 22 125

189458 Land on with Vine lot Dec 14 115  
Pan

- 4.78 Allens back to the main room No.
- 40.00 Set a post at the cor Dec cor  
off h call 18 ins in dia by 139 6 72  
off h call 18 ins in dia by 10 10.
- 61.50 Entrance Right Bank of the subterranean  
Room No 5 in the dia  
off h call 18 ins in dia by 111 6 52  
off h call 28 ins in dia by 123 7 110.

189459 Land on with Vine lot Dec 14 114  
Pan













































Membership 10000 A Kansas Co. (S.P.)  
Chubb

West Connected on the Vine at Dec 28 1833  
Van

3998 Set a post at the gr. sec cor & made  
a mound of earth a post 4 1/2 ft E  
1996 Set the post at the cor to Decs 28, 29, 32, 33

1056 On the Vine at Dec 28 1829  
Van -

1000 Set a post at the gr. sec cor & made a  
mound of earth from a post 4 1/2 ft E  
2350 Center of the Green St on the  
6700 Center at bottom of the St  
6750 To a Crank 65 lbs in dia runs E  
7000 do do do do W.  
7725 do do do do E  
9200 Set a post at the cor to 20, 21, 28, 29  
1177 Ash 16 in in dia by 124 1/2 x 104  
1178 Ash 12 in in dia by 146 1/2 x 206.

Can Random on the Vine at Dec 21 1828  
Van

1000 To a Crank 65 lbs in dia runs N  
2300 Near the bottom of the St S. W.  
1400 To a Crank 65 lbs in dia  
5000 Center of the St line 11 lbs of sec cor

West Connected on the Vine at Dec 21 1828  
Van

1486 To a Crank 18 in in dia  
4094 Set a post at the gr sec cor  
1177 Ash 18 in in dia by 130 1/2 x 97  
1178 Ash 15 in in dia by 167 1/2 x 67  
5000 Set a post at the cor to Decs 20, 21, 28, 29







D. P. Camp at 180 D. P. Camp at 200 D. P. Camp at 200  
Ch. 24

10.56 Ancha Vini at Dec 31 1832  
(Pan)

4.00 Det. app. at the go Rec. cor.  
A Bunch of Willows (W. H. 13 + 80) 9.32.

42.30 To Allen's Creek 60 lbs. made is sum. 6.16.

75.00 Asuncion a Bank 10 to 16.

80.00 Det. app. at the Cer. Dec 29, 30, 31 1832  
made a mound of Earth just 4 lbs.

East Pandom on the Vini at Dec 29 1832  
(Pan)

15.50 To Allen's Creek 60 lbs. made is sum. 6.16.

25.00 To Allen's Creek 15 lbs. made is sum. 6.16.

45.00 Ancha a marsh.

54.50 V. on the Marsh.

80.02 Det. app. at the Cer. Dec 29, 30, 31 1832

West Com. de. on the Vini at Dec 29 1832  
(Pan)

4.00 Det. app. at the go Rec. cor.

At the Cer. 16 lbs. made is sum. 6.16.

At the Cer. 11 lbs. made is sum. 6.16.

80.02 Det. app. at the Cer. Dec 29, 30, 31 1832

West Pandom on the Vini at Dec 30 1832  
(Pan)

81.07 Det. app. at the Cer. Dec 29, 30, 31 1832

East Com. de. on the Vini at Dec 30 1832  
(Pan)

41.07 Det. app. at the go Rec. cor. made a

mound of Earth just 4 lbs.

81.07 Det. app. at the Cer. Dec 29, 30, 31 1832



West Pandom in the Vini Feb Dec 29 130

4000 Pot a part at the go Dec 29 made a mound of Cash from a job 4 lb 6.  
 8000 Pot a part at the Cor & Dec 19 20 29 130.  
 11000 Made a mound of Cash Feb 4 lb 6.

West Pandom in the Vini Feb Dec 20 129

4000 Pot a part at the go Dec 20 made a mound of Cash from a job 4 lb 6.  
 8000 Pot a part at the Cor & Dec 19 20 29 130.











Drum shop to 5000 Kanganis 2 & 5000  
No 115

East Karam on the Vini bet Dec 17 120  
Law

25.00 Enter a bottom of 100 lbs.

45.50 First Pond of 100 lbs.

80.00 Enter of 300, 1st cont 16 17 20 21

West Comedia on the Vini bet Dec 17 120  
Law

41.00 Detaport at the good cor 1 made a  
mound of Earth put 4 lb E

51.00 2nd part at the Cor to Dec 17 18 19 20

489 45 W Karam on the Vini bet Dec 18 19  
Law

81.85 Enter of 300 Vini 47 lb of cor.

East Comedia on the Vini bet Dec 18 19  
Law

40.55 Detaport at the good cor 1 made a  
mound of Earth from a pit 4 lb E.

81.85 2nd part at the Cor to Dec 17 18 19 20

10.50 Enter the Vini bet Dec 17 18  
Law

9.00 Enter a bottom of 100 lbs.

46.00 Detaport at the good cor 1 made a  
mound of Earth put 4 lb E.

34.00 First Pond of 100 lbs.

61.20 2nd part 15 lb. Under is 2000 lbs.

71.50 View the bottom of 100 lbs.

80.00 Detaport at the Cor to Dec 7 8 17 18  
Made a mound of Earth put 4 lb E.

489 356 Karam on the Vini bet Dec 18 17  
Law




3.00 Enter a bottom of the 1st.

29.00 St. Haubespencea 11 in.

West Corner on the line bet Dec 50 11  
Pan

51.50 Right bank of Haubespencea River made  
a mound of earth July 4th 6.

80.19 To the post at the Cor to Dec 7. 5. 17 11 15.

98.38 Pan on the line bet Dec 7 11 15  
Pan

48.50 To a creek 15 in in dia in run S 6.

78.00 Enter Timber

81.68 To the post at the Cor. Am.

East Corner on the line bet Dec 7 11 15  
Pan

A Hook 12 in in dia by 52 4 33

A Link 14 in in dia by 60 2 6 12 4

32.58 To a post at the Cor. 22 in in dia.

41.68 To a post at the Cor. 22 in in dia made a  
mound of earth July 4th 6.

A Link 20 in in dia by 57 9 11 21 6.

80.68 To the post at the Cor to Dec 7. 5. 17 11 15

8.00  
61.20  
18.80  
4  
75.20  
2.00  
18.80  
1.20

West Corner on the line bet Dec 7 11 15  
Pan

9.00 Enter at 11 in

40.00 To a post at the Cor. 22 in in dia made a  
mound of earth July 4th 6.

45.50 To a creek 10 in in dia in run N 6.

78.00 Enter Timber 16 in. E 11 15.

80.00 To a post at the Cor to Dec 5. 6. 7 11 15.

A Link 10 in in dia by 43 7 10 6

A Link 15 in in dia by 58 2 22 11 5.



21

 Ches 16

189456 Pandem on the Vm Feb Dec 505  
 Jan

2748 Intusob Hauberspinner River

8022 Intusob of Vm 18 lbs. of Dec cor

West Connected on the Vm Feb Dec 519  
 Jan

3274 Right bank of Hauberspinner River  
 and Det u Meanda port

6112 To all Call 15 mi in dea

6832 To all Call 7 mi in dea on right bank of River

8122 To the prob with Cor & Dec 5. 6. 7 185.

189457 Pandem on the Vm Feb Dec 607  
 Jan

1071 Center a Prasen B. G. M.D.

8014 Intusob Pandem 57 lbs of Dec cor

East Connected on the Vm Feb Dec 617  
 Jan

4014 Det a prob with go Dec cor made  
 a mound of Earth from a pit 4th E.

8014 To the prob with Cor to Dec 5. 6. 7 185

189458 On the Vm Feb Dec 506

Jan

5115 Intusob Right bank of Hauberspinner  
 River det a Meanda port

11th Call 12 mi in dea of Dec 28

11th Call 15 mi in dea of Dec 22 N 14.



Measurements of Subst. ...

Meander of Right Bank of the ...

Beginning at Meander corner of ...

Course	Dist	In Dec
G36:47	8.00	
G1:6	20.50	
G33:47	7.00	
N88:47	11.50	
N66:47	5.50	
N38:47	13.00	
N54:47	11.00	
G34:47	4.50	
G14:47	7.00	
G7:6	7.00	
G31:26	14.76	

... in line with Dec 1-12.

In Dec 12.

G46:6	10.00
G21:6	11.50
G1:47	7.50
G25:47	3.00
G46:47	3.00
G45:47	11.50
N58:47	4.50
N25:47	11.00
N34:47	14.00
N66:47	7.00
G86:47	12.00

220.96.  
 244.48  
 23.32  
 80.22  
 68.32  
 11.90  
 4  
 47.60

... Dec 11 & 12

In Dec 11.

G85:47	8.00
G33:47	3.50



Munshipale sub Range to E. W. P. de An  
 Am Dist

81:6	1.50
835:6	5.50
849:6	6.00
811:11	7.00
822:11	6.50
850:11	6.50
1047:11	12.00
846:11	4.50
837:11	9.00
882:11	4.00
161:11	12.50
179:11	9.00
833:11	6.00
817:11	5.50
857:6	13.00
874:6	2.50
173:6	3.00
142:6	4.00
161:6	6.50
848:6	6.00
827:6	4.00
88:11	4.50
865:11	15.00

At 225. Mono Creek 65 Ch. mile from S.C.

Wet in ground in Am. W/ Dec 11-14

In Dec 14 -

839:11	34.35
870:11	3.50

Wet in ground in the Am. W/ Dec 14-15.

In Dec 15 -

887:11	8.00
166:11	13.00
187:11	5.00
856:11	6.00
826:11	2.00



23  
Comm Dec 5

1807	6.00
1847	9.00
1917	13.00
1847	5.50
1407	5.00
1197	11.50

Postage paid in Van Wert Dec 15/16

In Dec 16

1327	5.25
1467	10.50
1677	7.00
1847	11.00
112747	8.00
1287	6.50
1786	8.50
1386	15.50
1556	20.50
1366	8.00
1577	15.50
1487	7.50
1697	4.50
1347	17.00
1627	12.00
1747	11.00
1327	9.00
1277	7.50
1667	6.50
1827	8.50
1577	5.00
1316	6.50
1686	13.50
1336	6.00
1566	5.00
1207	6.00




1104/11	5.00	
1185/11	6.00	
1137/11	10.50	
1168/11	5.00	
1187/11	4.50	Washed in Vine (W Dec 16/17)

In Dec 17

1143/11	6.00	
1161/11	5.50	
1129/11	5.00	
1147/11	7.00	
1158/11	13.00	At 800 feet of Island.
1180/11	5.00	
1146/11	4.50	
1179/11	6.00	
1117/11	9.00	At 1000 feet of Island.
1142/11	6.00	
1161/11	7.50	Crust 25 lbs made from Dec 17.
1163/11	6.00	
1151/11	15.00	
1127/11	8.50	
1111/11	5.17	Washed in Vine (W Dec 8/17)

In Dec 8.

1132/11	5.50	
1172/11	3.50	
1181/11	6.50	
1123/11	3.10	Washed in Vine (W Dec 8/17)

In Dec 17

1153/11	16.00	
1176/11	7.50	
1134/11	5.50	
1137/11	5.12	Washed in Vine (W Dec 8/17)



Monday 20th Dec 1885  
Cash

120:11	8.11	In Dec 8
112:6	6.00	
145:6	15.50	
148:6	5.00	
111:6	3.50	
117:11	7.00	
114:11	19.00	
120:11	15.00	
111:11	6.50	

Total part in Vini Dec 5 1885

In Dec 5.

110:11	16.50	
167:11	1.50	
135:11	2.50	
112:11	6.50	
145:11	12.00	Vini Dec 5 1885
155:11	10.16	Total part in Vini Dec 5 1885

In Dec 6.

115:11	4.00
113:11	10.50
141:11	4.50
125:11	5.00
187:11	6.50
161:11	10.00
140:11	9.50
117:6	5.00
169:11	8.00
137:11	5.00
119:11	7.00
130:6	5.00
164:6	12.50
130:6	5.80



Membership in 8th RR Range No 2 East P.M.  
Cm. Sec 6

132.11 8.00

165.01 3.00

173.11 92.50

175.11 12.50

165.11 8.00 8th Range Vm on West Side.

I Certify that the foregoing is a true  
copy of the field notes of Membership in  
8th RR Range No 2 E. South of the River,  
as recorded in this office  
Dwight S. Simons  
Subreg. Genl. 1894

Dwight S. Simons




































*[Faint, illegible handwriting]*

 

*[Faint, illegible handwriting]*