BLUE GRASS TOWNSHIP

1 Stone N.W. Cor. of S.W. 1/4 Sec. 6 : it is at fence corner it is 28' North & 28' east of fences

2 Gas pipe : Ctr. of Sec. 6

3 Stone S.W. Cor. of Sec. 6 : it is 77.1 SE of spike in ash tree : it is 67.2 South of spike in ash : it is on line of fence west

4 Stone S.W. Cor. of Sec. 3 : it is 89.9 NE of Cor. of School it is 56.8 NE of spike in elm ; it is in the between road fences 2 + 1/2 it is 10" deep.

5 Gas pipe S.W. Cor. of Sec. 5 : it is 40.1 SW of spiesh power pole : it is 40.8 NE of spike in maple : it is 42 or 43 ft N.W. of spike in Tel. pole

6 Stone S.W. Cor. N.W. 1/4 Sec. 8 : it is 30' east of hedge north and south : it is 20' West of fence : it is on fence line east and west

7 Gas pipe S.W. Cor. Sec. 8 : it is in & between fences and it is on fence line east and West

8 Stone S.W. Cor. N.W. 1/4 Sec. 10 : it is on line of fence West : it is 30' east of spike in ash

9 Gas pipe S.W. Cor. Sec. 10 : it is 30' east of stone in West fence line : it is on fence line east

10 Stone S.W. Cor. S.E. 1/4 Sec. 17 : it is at fence corner

11 Cone Monument S.E. Corp. Sec. 17 : it is 28 N north of a gas pipe : it is 38 SE of gas pipe : it is 41.8 SW of tel. pole : it is 28.2 N.W. of spike at tel. pole : it is 24.5 E. of spike at tel. pole :

12 Concrete Monument S.W. Cor. S.E. 1/4 Sec. 16 : it is 38.5 SE of SW Cor. of barn : it is 36.8 SW of S.E. Cor. of barn : it is 84.2 SW. of face of silo

13 Concrete Monument S.E. Cor. Sec. 16 : it is 40.4 SE of spike in Tel. pole : it is 65.6 S.W. of spike in maple : it is 42.8 N.W. of spike in fence post

14 Gas pipe S.W. Cor. N.W. 1/4 Sec. 22 : it is on fence line West and east : it is in the & between road fences south

15 Stone S.W. Cor. N.W. 1/4 Sec. 20 : it is 85 1/2 North of fences : it is 32' south of fences : it is 31' West of fences : it is 28 1/2 ft east of fences

16 Stone S.W. Cor. Sec. 20 : it is in & between Road fences and it is on line of fences east and west

17 Stone S.W. Cor. S.E. 1/4 Sec. 20 : it is at the fence corner : it is on line of fence west

18 Stone S.W. Cor. S.E. 1/4 of S.E. 1/4 Sec. 20 : it is 17' east of fence & 15 1/2 ft. north of fence

19 Cone Monument 2.6 ft NE of iron fence post : it is 28.8 N.W. of spike in Tel. pole : it is S.W. Cor. of Sec. 21.

20 Stone S.W. Cor. Sec. 22 : it is 1.2 ft deep : it is 32.6 SE of spike in Cor. post : it is 28.6 N.W. of spike in Cedar post : it is 27.1 S.W. of spike in evergreen : it is 38.4 NW. of spike in Cor. post : it is 34' N.W. of spike in maple

21 Stone S.W. Cor. S.E. 1/4 Sec. 22 : it is 34.2 ft. S.W. of gas pipe it is 40.3 S.E. of gas pipe : it is 36.4 N.W. of gas pipe : it is 34.2 N.E. of gas pipe

22 Cone Monument S.E. Cor. of Sec. 22 : it is 50.2 S.E. of Fence on W. Hedge of Cedar : it is 44.8 NE of Fence on N.W. of Cedar : it is 39.3 N.W. of spike in Cor. post

23 Gas pipe S.W. Cor. S.E. 1/4 Sec. 23 : it is 33 North & 32' South of post & pipes

24 Gas pipe S.E. Cor. Sec. 23 : it is 37.7 S.E. of spike in Cor. post : it is 34.2 NW of spike in Cor. post : it is 27.1 S.W. of spike in Tel. pole : it is 20 out of fence other : it is 18' west of fence north

25 Gas pipe N.W. Cor. N.E. 1/4 Sec. 28 : it is 30' South of stone on North fence line : it is on the east and West line but is not in the line on East N & S. line

26 Cone Monument 10" deep S.E. Cor. Sec. 24 : it is about on line of post Road fence runing north : it is 40.3 NE of 2 spike in Cor. post : it is 41.4 N.W. of spike in Cor. post : it is 17.2 SW of spike in Cor. post

27 Stone N.E. Cor. of S.E. 1/4 Sec. 24 : it is 4.2 North of fence and 6' west of fence : it is 66' West of a gas pipe

28 Stone N.E. Cor. Sec. 34 : it is 42.3 S.E. of spike in willow tree : it is 33.3 S.W. of Rail in Tel. pole : it is 66' West of gas pipe which is 8' east of east road fence : stone is about 2' South of fence east

29 Stone N.E. Cor. Sec. 36 : it is 24' east and 80.6 ft west of fences north : it is 18' South of fence West + 18' South of fence north : it is 33' N. of S. road fence

30 Stone it is 4' east of fence : it is 63' west of 2 spikes in 23" Cottonwood : it is 63.3 N.W. from spike in 8" apple : it is 40' northeasterly from spike in 12" Cottonwood

31 Stone N.W. Cor. N.E. 1/4 Sec. 36 no ties

32 Stone N.W. Cor. N.E. 1/4 N.W. 1/4 Sec. 36 : it is 4' South of fence

33 Stone N.W. Cor. Sec. 36 : it is on fence line east + west : it is in & between fences

34 Stone S.W. Cor. Sec. 36 : it is 2' South and 1' West of Cor. post it is 16' West of West side of maple tree

35 Stone S.W. Cor. S.E. 1/4 Sec. 27 : it is 9' north of fence and it is on line of hedge

36 Stone S.W. Cor. Sec. 28 : it is 10.4 east of maple : it is 36.3 S.E. of walnut : it is 33' West of Gas pipe : it is 21.5 ft. of fence N. 18.5 ft. of fence S. : Cor. is 18" in the fence : it is 50' E of gas pipe at fence line W.

37 Stone S.W. Cor. N.W. 1/4 Sec. 28 : it is on line of fence east : it is 12' west of east fence

38 Stone N.W. Cor. S.W. 1/4 Sec. 29 : it is 60.5 NE. of spike in ash it is 60.2 SE. of spike in maple root

39 Stone S.W. Cor. N.W. 1/4 Sec. 32 : it is 46' NE. of Cor. post : it is 46' N.W. of Cor. post : it is 40.9 S.W. of Corner post

40 X on paving : S.W. Cor. of Sec. 32

41 Cross on paving : S.W. Cor. Sec. 33

42 S.W. Cor. S.E. 1/4 Sec. 33 was point under paving : High Way Commission has give 40.2 SE of iron pin : 31.38 S.W. of iron pin : 40.14 N.W. of iron pin : 37.2 NE of iron pin

43 S.W. Cor. Sec. 34 : Was point under paving : Orig. has 67.12 SE of iron pin : 56.55 NE. of iron pin

44 S.W. Cor. S.E. 1/4 Sec. 34 Was point under paving : it is 45.5 S.E. of iron pin : 46.18 S.W. of iron pin : 41.66 N.W. of iron pin : 43.88 NE. of iron pin by maple stump.

45 Stone S.W. Cor. N.W. 1/4 Sec. 35 : it is 27' north and 30' south of fence

46 Stone S.W. Cor. N.W. 1/4 Sec. 36 : it is 48.8 S.E. of spike in Buss Oak : it is 38.3 NE of spike in Tel. pole : it is 30.2 N.W. of spike in wild cherry tree : it is 31.5 ft north and 29' South of fence west in line & of fences east : it is 21' east + 18 1/2' West of fences South it is 33 1/2' and 18 1/2 ft West of fences north

47 Stone S.W. Cor. S.E. 1/4 N.W. 1/4 Sec. 36 : it is 3.2' east of fence north it is 38' South and 82' north of road fences

48 Stone Ctr. of Sec. 36 : it is on line of West road fence : it is 4' north of Cor. post of fence west : it is about 1.5 ft north of general line of fence west : it is 6" deep : it is 13.4 north of spike in wild cherry and about 1/2 ft south of said last mentioned spike

49 Stone S.E. Cor. N.E. 1/4 Sec. 36 : it is on West side of post : stone is 2.2 ft deep

50 Stone S.E. Cor. N.E. 1/4 of N.E. 1/4 of Sec. 36 : it is 1.2' North and 4" west of Cor. post : it is 6" deep

51 Cone Monument Ctr. of Sec. 20 : it is 33' South of fence and 21' ft north of fence

52 Stone S.W. Cor. of S.E. 1/4 of Sec. 27 : it is 0.2 east and 0.2 north of fence

53 Gas pipe S.E. Cor. of N.E. 1/4 Sec. 19 : it is in & between north and South Road fences : it is on line of south road fence runing West

54 Stone Ctr. of Sec. 17 : it is on line of South road fence and is 2 1/2 ft. east of Cor. post

55 Stone N.E. Cor. of Sec. 17 : it is on line (D-53) produced north to (58) : it is on line of east + west fence

56 Stone N.E. Cor. of N.W. 1/4 of N.W. 1/4 Sec. 16 : it is 6" deep : it is on line of fences east west and South

57 Stone S.E. Cor. N.E. 1/4 Sec. 20 : it is about 2 1/2' West of fence

58 Stone Ctr. of Sec. 27 : it is on line of N & S. fence and 5.05" South of Cor. post

59 Stone S.W. Cor. N.W. 1/4 Sec. 19 : it is 6.6 SE. of spike in Cor. post : it is 41.2 SW. of spike in Cor. post : it is 36' N.W. of spike in maple

60 Gas pipe Ctr. of Sec. 19 : it is 33 1/2 ft. South of north fence it is 31.7 north of South fence

61 Cross on & paving S.W. Cor. Sec. 36 : it is 20' east of fence north and 21.0 west of fence north

62 S.W. Cor. S.E. 1/4 Sec. 36 no point here

63 Cross on paving S.E. Cor. Sec. 36 : it is in & between road fences South

64 Stone S.W. Corner of Section 10 : it is 16 1/2 ft east of fence it is 33' west of fence north and south : it is 16 1/2 ft. east of fence South : it is 27.2 South of fence east : it is 13.7 north of fence east : it is 10 ft north of fence West : it is 16 ft. north of fence west : it is 16.8 N.W. of spike in Cor. post : it is 18.3 S.W. of spike in root of maple

65 Stone N.W. Cor. of S.W. 1/4 Sec. 10 : it is 3.2 ft South of fence east : it is 19.7 West of Spike in Cor. post it is 20.8 ~~[illegible]~~ Spike in Tel. pole it is 0.8 ft deep

66 Stone N.W. Cor. N.E. 1/4 Sec. 10 : it is on fence line north : it is 0.5' west of fence South : it is 16 1/2 ft South of N. fence : it is 13 1/2 ft. North of South fence : stone is 10" deep

67 Gas pipe N.W. Cor. N.E. 1/4 of N.E. 1/4 Sec. 10 : it is 17 1/2 ft north of fence : it is 19' South of fence : it is 24 1/2 ft. east of fence line South

68 Stone N.E. Cor. Sec. 10 : it is 34.9 SE of spike in 21" Cottonwood it is 45.10 S.E. of spike in willow : it is 30.8 NE of spike in Tel. pole : it is 21.5' east of fence north : it is 19 ft. west of fence north : it is 11.2' east of fence South : it is 27.2' west of fence South : it is 18' South of fence east and west : it is 19' north of fence east and west

69 Gas pipe S.E. Cor. S.W. 1/4 Sec. 6 : it is 2 1/2 ft west of fence north it is 29.8 SE of spike in Tel. pole : it is 19.1' S.W. of spike in Tel. pole : it is 64.8 N.W. of spike in Tel. pole

70 Stone S.W. Cor. N.W. 1/4 Sec. 11 : it is on fence line west : it is 50' east of gas pipe : it is 19' east + 19' west of Road fences

71 Gas pipe N.E. Cor. N.W. 1/4 Sec. 11 : it is 19' north and 19' South of fences : it is 21' South + 17' north of fence lines west

72 Stone S.W. Cor. Sec. 11 : it is 12" deep : it is 19 east and 19' west of fences north : it is 21 east + 16 West of fences South : it is 24' north and 16 ft South of fences west : it is 16 1/2 ft North + 16' South of fences east

73 Stone S.W. Cor. S.E. 1/4 Sec. 11 : it is 1.2' east of fence South : it is 17.7 ft North + 16 South of Road fence : it is 1.7 South of a straight line from (70) to (80) : it is 82.3 S.W. is spike in 18" double locust 6 in 20 on S.W. 1/4 side : it is 50' north of a gas pipe on fence line South : it is 12" deep

74 Stone S.E. Cor. of Sec. 11 : it is 17' east and 17' west of North and South fences : it is on fence line east : it is 1.0 ft. deep : it is 20' north of South road fence : it is 16 1/2 ft. South of North road fence : it is 50' west of gas pipe on fence line east

75 Stone N.E. Cor. N.W. 1/4 Sec. 13 : it is 0.8 S.E. of Cor. post and it is on hedge line east

76 Stone N.W. Cor. of S.W. 1/4 of N.E. 1/4 Sec. 13 it is 0.8 ft. N.E. of hedge tree at fence corner

77 Stone S.W. Cor. N.W. 1/4 Sec. 13 : it is on fence line west : it is 21' east of west Rd fence : it is 50' east of a gas pipe on fence line west : it is 33.2 ft South of South side of Rd. fence

78 Stone S.W. Cor. N.W. 1/4 Sec. 14 : it is 1.0 deep : it is 21' east + 21' west of gas pipe : it is 21' east + 21' west of road fences

79 Stone S.W. Cor. Sec. 14 : it is 2' north of fence east : it is 18' east and 21' West of fences north : it is 17 east + 17' West of fences South : it is 16 1/2 north + 16 1/2 South of fences west

80 Stone S.E. Cor. Sec. 14 : it is 21 1/2 ft east and 21 1/2 ft West of road fences : it is 13.8 north of fence west : it is 40.6 NE of 2 spikes in Bur elder : it is 31.2 north of north side of School

81 Stone S.W. Cor. N.W. 1/4 Sec. 24 : it is on fence line east it is 2.0 north of fence West : it is 28.2 east of spike in Cor. post : it is 27.1 West of spike in Cable pole : it is 21' east and 21' west of road fences

82 Stone S.W. Cor. of S.E. 1/4 of N.W. 1/4 Sec. 22 : it is on line of fence north and South : it is between post and hedge

83 Stone Ctr. of Sec. 32 : it is 33' South and 32' north of fence : it is 43' S.W. from spike in maple

84 Stone S.W. Cor. N.W. 1/4 Sec. 33 : it is 22' north and 22' South of fences east : it is 18.2 West of fence north : it is 20' east + 19' west of fence South : it is 27' north of fence west : it is 34.2 N.W. of spike in maple root : it is 30.6 SW of spike in power pole : it is 16.8 NE of spike in power line guy pole

85 Stone Ctr. of Sec. 33 : 79.9 S.E. of + in Cor. post : 54.9 S.W. of + in fruit tree : 47.6 N.E. of + in Cor. post : 47.8 N.W. of + in brace post : 16° W. of E fence line South : 33° E of W fence line South : 33° E of E face of House measuring on E-W E.

86 S.E. Cor. N.E. 1/4 Sec. 33 : it is in & of fences north and it is 27.2 north of double road fence : it is 41.7 NE. from spike in root of oak : it is 62.7 S.W. of spike in ash

87 Stone

88 Stone S.W. Cor. S.E. 1/4 Sec. 36 : it is 21.0 east of fence north it is 18' east of fence South : it is 28 1/2 north of fence west it is 26 1/2 north of fence east : it is 33' 1/2 ft. of face of Cor. post : it is 56' SE of face of Cor. post

89 Stone Ctr. of Sec. 31 : it is 40' east of east face of house it is 87' South of Main gate at house : it is 36 1/2 SE of spike in maple : it is 44 1/2 NE of spike in maple

90 Gas pipe S.W. Cor. S.E. 1/4 of N.E. 1/4 Sec. 31 : it is about 2' west of fence north and is about 2' between fences

91 Stone S.E. Cor. Sec. 30 : it is 61.4 NE of spike in maple it is 45.7 N.W. of spike in Cor. post : it 61 1/2 SW of spike in east gate post

92 Stone S.W. Cor. S.E. 1/4 of S.E. 1/4 Sec. 30 : it is on S.E. side of Cor. post

93 Stone S.W. Cor. S.E. 1/4 Sec. 30 it is in & between Rd. fences. it is 16 1/2 East and 16 1/2 ft west of gas pipes

94 Stone S.W. Cor. N.W. 1/4 of S.E. 1/4 Sec. 30 it is 91' West of S.W. Cor. of house it is 88.3 S. of S. Face of house : it is 157 east of fence : it is 16' West of fence

95 Gas pipe Ctr. of Sec. 30 it is 17' South and 16' North of Road fences west : it is 16 1/2 east and 15 1/2 West of Rd. fences South : it is 11.5 West of fence north : it is 16" deep

96 Gas pipe S.W. Cor. S.E. 1/4 of N.E. 1/4 Sec. 30 : it is 2' east of present fence Corner

97 Gas pipe S.E. Cor. N.E. 1/4 of N.E. 1/4 Sec. 30 : it is 9' South of hedge east it is 7' north of fence West : it is 38 1/2 West and 31' east of Road fences

98 Gas pipe S.W. Cor. N.E. 1/4 of N.E. 1/4 of Sec. 30 : it is 1.5 east of fence N+S. it comes 8' north of fence west : it is 8.2 ft north of fence east

99 Gas pipe N.W. Cor. N.E. 1/4 of N.E. 1/4 Sec. 30 : it is 3 1/2 feet North of east and west fence : it is 6' West of fence South

100 Gas pipe S.W. Cor. N.W. 1/4 of N.E. 1/4 Sec. 30 : it is on fence line North & South and is 3.3 north of present corner post

101 Gas pipe N.W. Cor. N.E. 1/4 Sec. 30 : it is about 12" east of Cor. post : it is 2.10 ft north of a straight line from (16) to (102)

102 Gas pipe N.W. Cor. Sec. 30 : it is about on fence line east and is about in & between fences

103 Harrow pin N.E. Cor. Sec. (3) : it is on fence line west and in & of Road fences
Sec. E Book 202-p1

104 S.W. Cor. S.E. 1/4 of N.W. 1/4 Sec. 21 Dest that this is stone

105 Stone N.W. Cor. N.E. 1/4 Sec 1 : it is level with surface 28.5' East of Orchard fence.

106 Stone on line of Fence E+W 22 E of West Fence South, 7 E of West Fence North, 19 West of E Road Fence South, 33 West of East Road Fence North

107 Gas Pipe : NE Cor. Sec 11 : it is 1.0 deep : it is 22.5 N of fence W : 21.5 ft of fence E : it is 22.1 W of fence S : it is 21.0 E of fence S : it is 18.5 S of fence E + W : it is 38.4 SE of 2 spikes in blazed root of maple :

108 Cross on & of Paving

109 Iron pin set in conc. IT IS 34.55 S.E. Tel. pole IT IS 41.5 W. Cor. post IT IS 46.7 N.W. Tel. pole

110 DEST SIGNAMENT : CENTER OF SEC 6 Bk 302

T. 78 N. R. 2 E. OF 5 TH P. M.
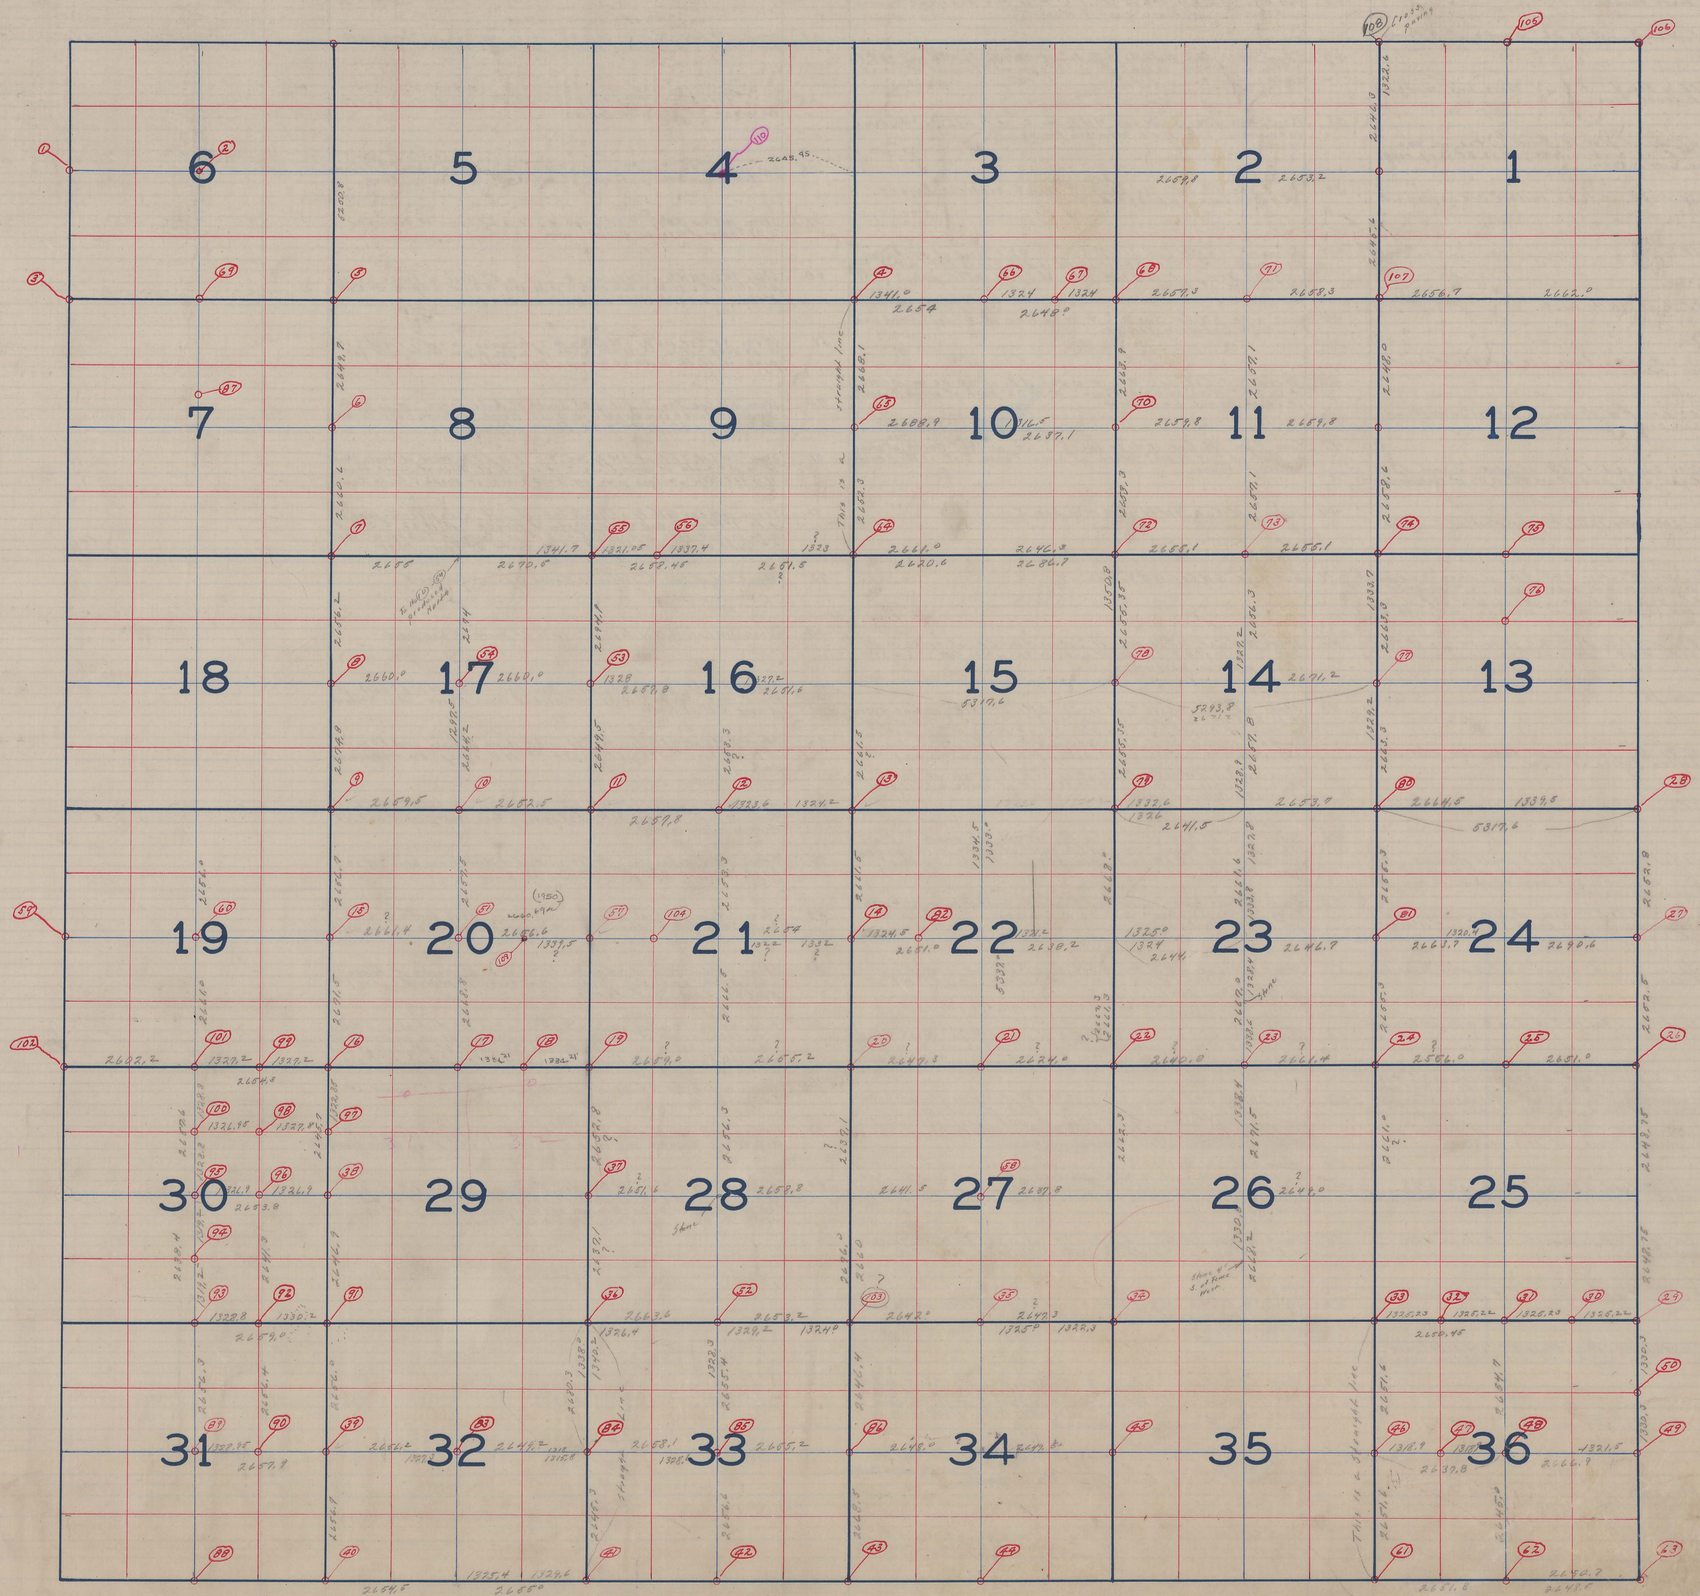
BLUE GRASS TOWNSHIP