


BUTLER

TOWNSHIP

1	Stone	near Cor. post	30	Gas pipe SE Cor. NE 1/4 Sec. 20; it is 30' West of hedge east side of road; it is on line of Hedge West	59	Stone SW Cor. Sec. 35; it is about 2' between road fences
2	Iron bar	NW Cor. NE 1/4 of SW 1/4 Sec. 5	31	Stone SE Cor. NE 1/4 Sec. 21 no ties	60	Gas pipe NW Cor. Sec. 33; it is 49' NW of spike in maple; it is 4 1/2' SW of spike in hedge stump; it is 56 1/2' SE of spike in apple tree; it is 36 1/2' NE of spike in hedge Cor. post
3	Iron bar	NW Cor. SW 1/4 Sec. 5	32	Gas pipe Ctr. of Sec. 22; it is 1 1/2' South of Ctr. of 5" hedge Cor. post	61	Stone SW Cor. Sec. 3; it is 10' South of fence and it is 6755' east of a gas pipe in a road which said gas pipe is 2 1/2' ft. east of east fence; stone is on E. of Road produced east
4	Cone Monument	NW Cor. NE 1/4 of SW 1/4 Sec. 1	33	Stone SW Cor. NW 1/4 Sec. 23; it is 43.9' South of spike in Catterwood; it is 22.3' east of spike in Walnut and it is 3' North of fence West	62	Gas pipe 2650' Ft. North of stone (D) and 70'00' from SW line SW 1/4 Sec. 4; it did not go to enough trouble to determine if it is D.V. for corner P.R.
5	Stone	NW Cor. of SW 1/4 Sec. 10; it is above ground in ditch on fence line east; it is 59.4' NE of spike in Cor. post; it is 61.5' west of spike in 1' Box elder; it is 81' east of spike in willow	34	Stone Ctr. of Sec. 23; it is 40' South of gas pipe; it is 40' North of gas pipe; it is on fence line North & South	63	Stone SW Cor. SE 1/4 Sec. 36; it is in a between fences & is 33' north of gas pipe
6	Stone	SW Cor. of Sec. 10; it is 92' SW of 2 spikes in Tel. pole; it is 95 1/2' SE of 2 spikes in Tel. pole; it is 96' NE of spike in large catterwood	35	Stone SW Cor. NW 1/4 Sec. 24; it is 56.9' SW of gas pipe by steel post; it is 49.9' SE of spike in Tel. pole	64	Gas pipe SW Cor. SE 1/4 Sec. 4; it is 79.9' SW of 8' apple tree; it is 20.8' South of fence; it is 20.8' north of fence; it is 43' SW of spike in gate post; 41.2' NW of spike in Tel. pole; 40.9' NE of spike in Cor. post
7	Stone	SW Cor. Sec. 9; it is 82' NW of spike in power pole; it is 48.3' SE of spike in hedge post; it is 34.5' SW of spike in Tel. pole; it is 45.0' NE of spike in Tel. pole	36	Stone SE Cor. NE 1/4 Sec. 24; it is 60' west of gas pipe; it is 30' east of gas pipe	65	Gas pipe SW Cor. Sec. 4; it is 36' SW of iron post; it is 18 1/2' north of 2 spikes in Tel. pole; it is 49.7' NE of spike in hedge post
8	Stone	SW Cor. NW 1/4 of NW 1/4 of Sec. 16; it is 23' East of West fence; it is 31' west of east fence; it is on fence line West; it is 12' deep	37	Stone SE Cor. Sec. 24; it is 40.1' SE of spike in Cor. post; it is 36.8' SW of spike in Cor. post; it is 47.2' NW of spike in Cor. post; it is 39.9' NE of spike in Cor. post	66	Stone NE Cor. Sec. 7; it is 1.7' north of Cor. post; it is on line of hedge stump east & west
9	Stone	SW Cor. NW 1/4 Sec. 16; it is 31.4' west of S. fence post; it is 29' east of spike in hedge; it is 49.5' east of spike in fence post; it is 28' SE of spike in hedge fence; it is 23.8' North of fence west	38	Stone SW Cor. SE 1/4 Sec. 24; it is 40' North of gas pipe; it is on fence line S. it is 29.2' SW of spike in catterwood; it is 25.8' SW of spike in maple; it is 26.2' SE of 2 spikes in Maple	67	Stone NE Cor. SE 1/4 Sec. 2; it is 1.5' South of road fence; it is on line of Cor. post
10	Stone	NW Cor. of NW 1/4 of SW 1/4 Sec. 16; it is 30' from both fences and is on line of fence east	39	Stone SW Cor. Sec. 24; it is 53.6' NW of spike in apple tree; it is 34.9' east of spike in Box elder	68	Stone Ctr. Sec. 7; it is in a of fences and on line of fence north & south
11	Gas pipe	SW Cor. Sec. 14; it is 52.1' NW of spike in hedge; it is 85.1' SW of spike in 16' maple; it is 44.9' SE of spike in Cor. post	40	Stone SW Cor. SE 1/4 Sec. 24; it is SW of Cor. post; it is 8' deep	69	Stone SW Cor. SE 1/4 of SW 1/4 Sec. 7; it is 2' East of post; it is 6' deep
12	Stone	SW Cor. SE 1/4 Sec. 16; it is 53' north of gas pipe; it is 33' South of gas pipe and is 77.2' South of Cor. post	41	Stone SW Cor. Sec. 22; it is 17' east of spike in tree; it is 27.3' NE of spike in Cor. post; it is 31' SE of spike in 8' tree; 44.5' SW of spike in Apple tree; 43.0' NW of spike in Apples tree	70	Stone SW Cor. NW 1/4 Sec. 7; it is on line of NW fence
13	Wood Stake	SE Cor. Sec. 16; it is 45' SW of spike in Cor. post; it is 37.2' NW of spike in Tel. pole; it is 37.9' SE of spike in Tel. pole	42	Stone SW Cor. Sec. 21; it is 75.5' SW of spike in stump; it is 48.4' SE of spike in hedge; it is 50.4' NW of spike in hedge post; it is 40.4' West of fence spike in hedge post	71	Stone SE Cor. NE 1/4 Sec. 36; it is 27.7' E and 21' West of fence; it is 26.4' East of spike in Hedge tree; it is 22.6' SW of spike in Tel. pole; it is 31.0' W of spike in Box elder
14	Stone	NW Cor. SW 1/4 Sec. 16; it is 23.9' west of cross on Rock; it is 31' east of spike in post; it is 33.9' NE of spike in fence post	43	Stone SW Cor. SE 1/4 Sec. 17; it is on line of willow south; it is 3.6' South of fence post; it is 27.2' South of fence and; it is 11' North of fence east; it is 35' east of fence west; it is 3 1/2' south of willow	72	Stone NE Cor. Sec. 36; See Princeton Twp
15	Stone	Ctr. of Sec. 15; it is between 2 Cor. posts; it is about 6" deep	44	Gas pipe SE Cor. NE 1/4 Sec. 29; it is 30.1' west of spike in hedge stump; it is 33' east of gas pipe; it is 40.4' NW of spike in hedge stump	73	Cross on Ball of Railroad rail NE Cor. of SW 1/4 of NE 1/4 Stone is missing; Cross is 35.8' SW of nail in Maple; it is 42.5' SW of nail in Elm; it is 33.42' NW of nail in Oak; it is 19.28' N of nail in Oak; Established by HIGHWAY COMMISSION APR. 21-1939 - J.C. BRANDT & HOWARD PORTER
16	Stone	SW Cor. SE 1/4 Sec. 15; it is 3' deep; it is 5 1/2' South of center of Cor. post; it is 1 1/2' ft. West of fence north	45	Stone SE Cor. NE 1/4 Sec. 28; it is 38' NE of spike in Tel. pole; it is 34.9' SW of spike in Cor. post; it is 30' west of Cor. post	74	CONC MONT SEE BOOK 215 PAGE 5
17	Stone	NW Cor. Sec. 12; it is 35.3' NW of spike in Tel. pole; it is 68' SE of spike in apple tree; it is 71.7' NW of spike in power pole; it is 20' West of spike in NW fence; it is 52' E of fence in	46	Stone SW Cor. NW 1/4 of SW 1/4 Sec. 27; it is 81.9' west of spike in catterwood; it is 46.3' NE of spike in Tel. pole; it is 34' SE of spike in fence post	75	CONC MONT SEE BOOK 215 PAGE 5
18	Gas pipe	NW Cor. NE 1/4 Sec. 13; it is 17.2' west of present Cor. post and it is on line (D) (B) produced West	47	Stone SW Cor. NW 1/4 Sec. 26; it is on fence line east; it is 30' west of hedge south; it is 81' east of west fence	76	CONC MONT SEE BOOK 215 PAGE 5
19	Stone	NW Cor. SW 1/4 NE 1/4 Sec. 13	48	Stone at dead corner		
20	Stone	Ctr. of Sec. 13; it is 47.4' East of spike in Black locust; it is 73.9' NW of East end of Bearing pin at NE. Cor. of Bridge	49	Stone Ctr. of Sec. 25; it is 18' deep; it is 21' South and 8' east of Cor. post		
21	Stone	NW Cor. NE 1/4 SE 1/4 Sec. 13; it is about 7' north of Cor. post; it is about 8' deep	50	Stone SW Cor. of NW 1/4 of SE 1/4 Sec. 25; it is 11.1' North and 3' west of east of hedge		
22	Stone	SE Cor. Sec. 13; it is 1' E of fence; it is 50' S of gas pipe on fence; it is 20' S of fence E & W; it is	51	Stone at dead corner		
23	Stone	SW Cor. SE 1/4 Sec. 13	52	Stone NW Cor. SW 1/4 of SW 1/4 Sec. 25; it is on hedge line east; it is 28' West of fence and 27 1/2' ft. east		
24	Stone	SW Cor. SE 1/4 Sec. 12; it is 33' north of gas pipe; it is 37' South of gas pipe; it is 31.7' S. Ely from 2 spikes in apple tree	53	Stone SW Cor. Sec. 25; it is 40.7' W of NW Cor. of Barn foundation; it is 82.9' NW of SW Cor. of Barn foundation; it is 6" deep		
25	Stone	SW Cor. Sec. 17; it is 23' North of gas pipe; it is on line of fence South	54	Stone SW Cor. SE 1/4 Sec. 26; it is 7.7' ft. north of fence east; it is on line of hedge; it is 146' South of fence west		
26	Stone	SW Cor. SE 1/4 Sec. 18; it is 124.6' west of spike in west edge of paving; it is 83.4' NE of spike in Wood elm; it is 112.3' S. Ely from spike in locust	55	Stone SW Cor. NW 1/4 of NE 1/4 Sec. 34; it is 7 1/2' north and 4.8' east of Cor. post		
27	Stone	SW Cor. Sec. 18	56	Stone SW Cor. NW 1/4 of NW 1/4 of Sec. 36; it is 29' west of fence; it is 21' east of fence and is 36' South of fence post		
28	Stone		57	Stone SW Cor. NW 1/4 Sec. 36; it is 20' west of fence; it is 30 1/2' east of fence; it is 4 1/2' ft. North of fence west		
29	Stone	SE Cor. NE 1/4 Sec. 19; it is on West side of Cor. post	58	Stone SW Cor. Sec. 36; it is 19.5' South of fence west; it is 25 1/2' north of fence west and east; it is 21 1/2' South of fence east; it is 48.4' NE of spike in tree; it is 54.8' NW of spike in Cor. post		

T. 80 N. R. 4 E. OF 5TH P. M.

BUTLER TOWNSHIP

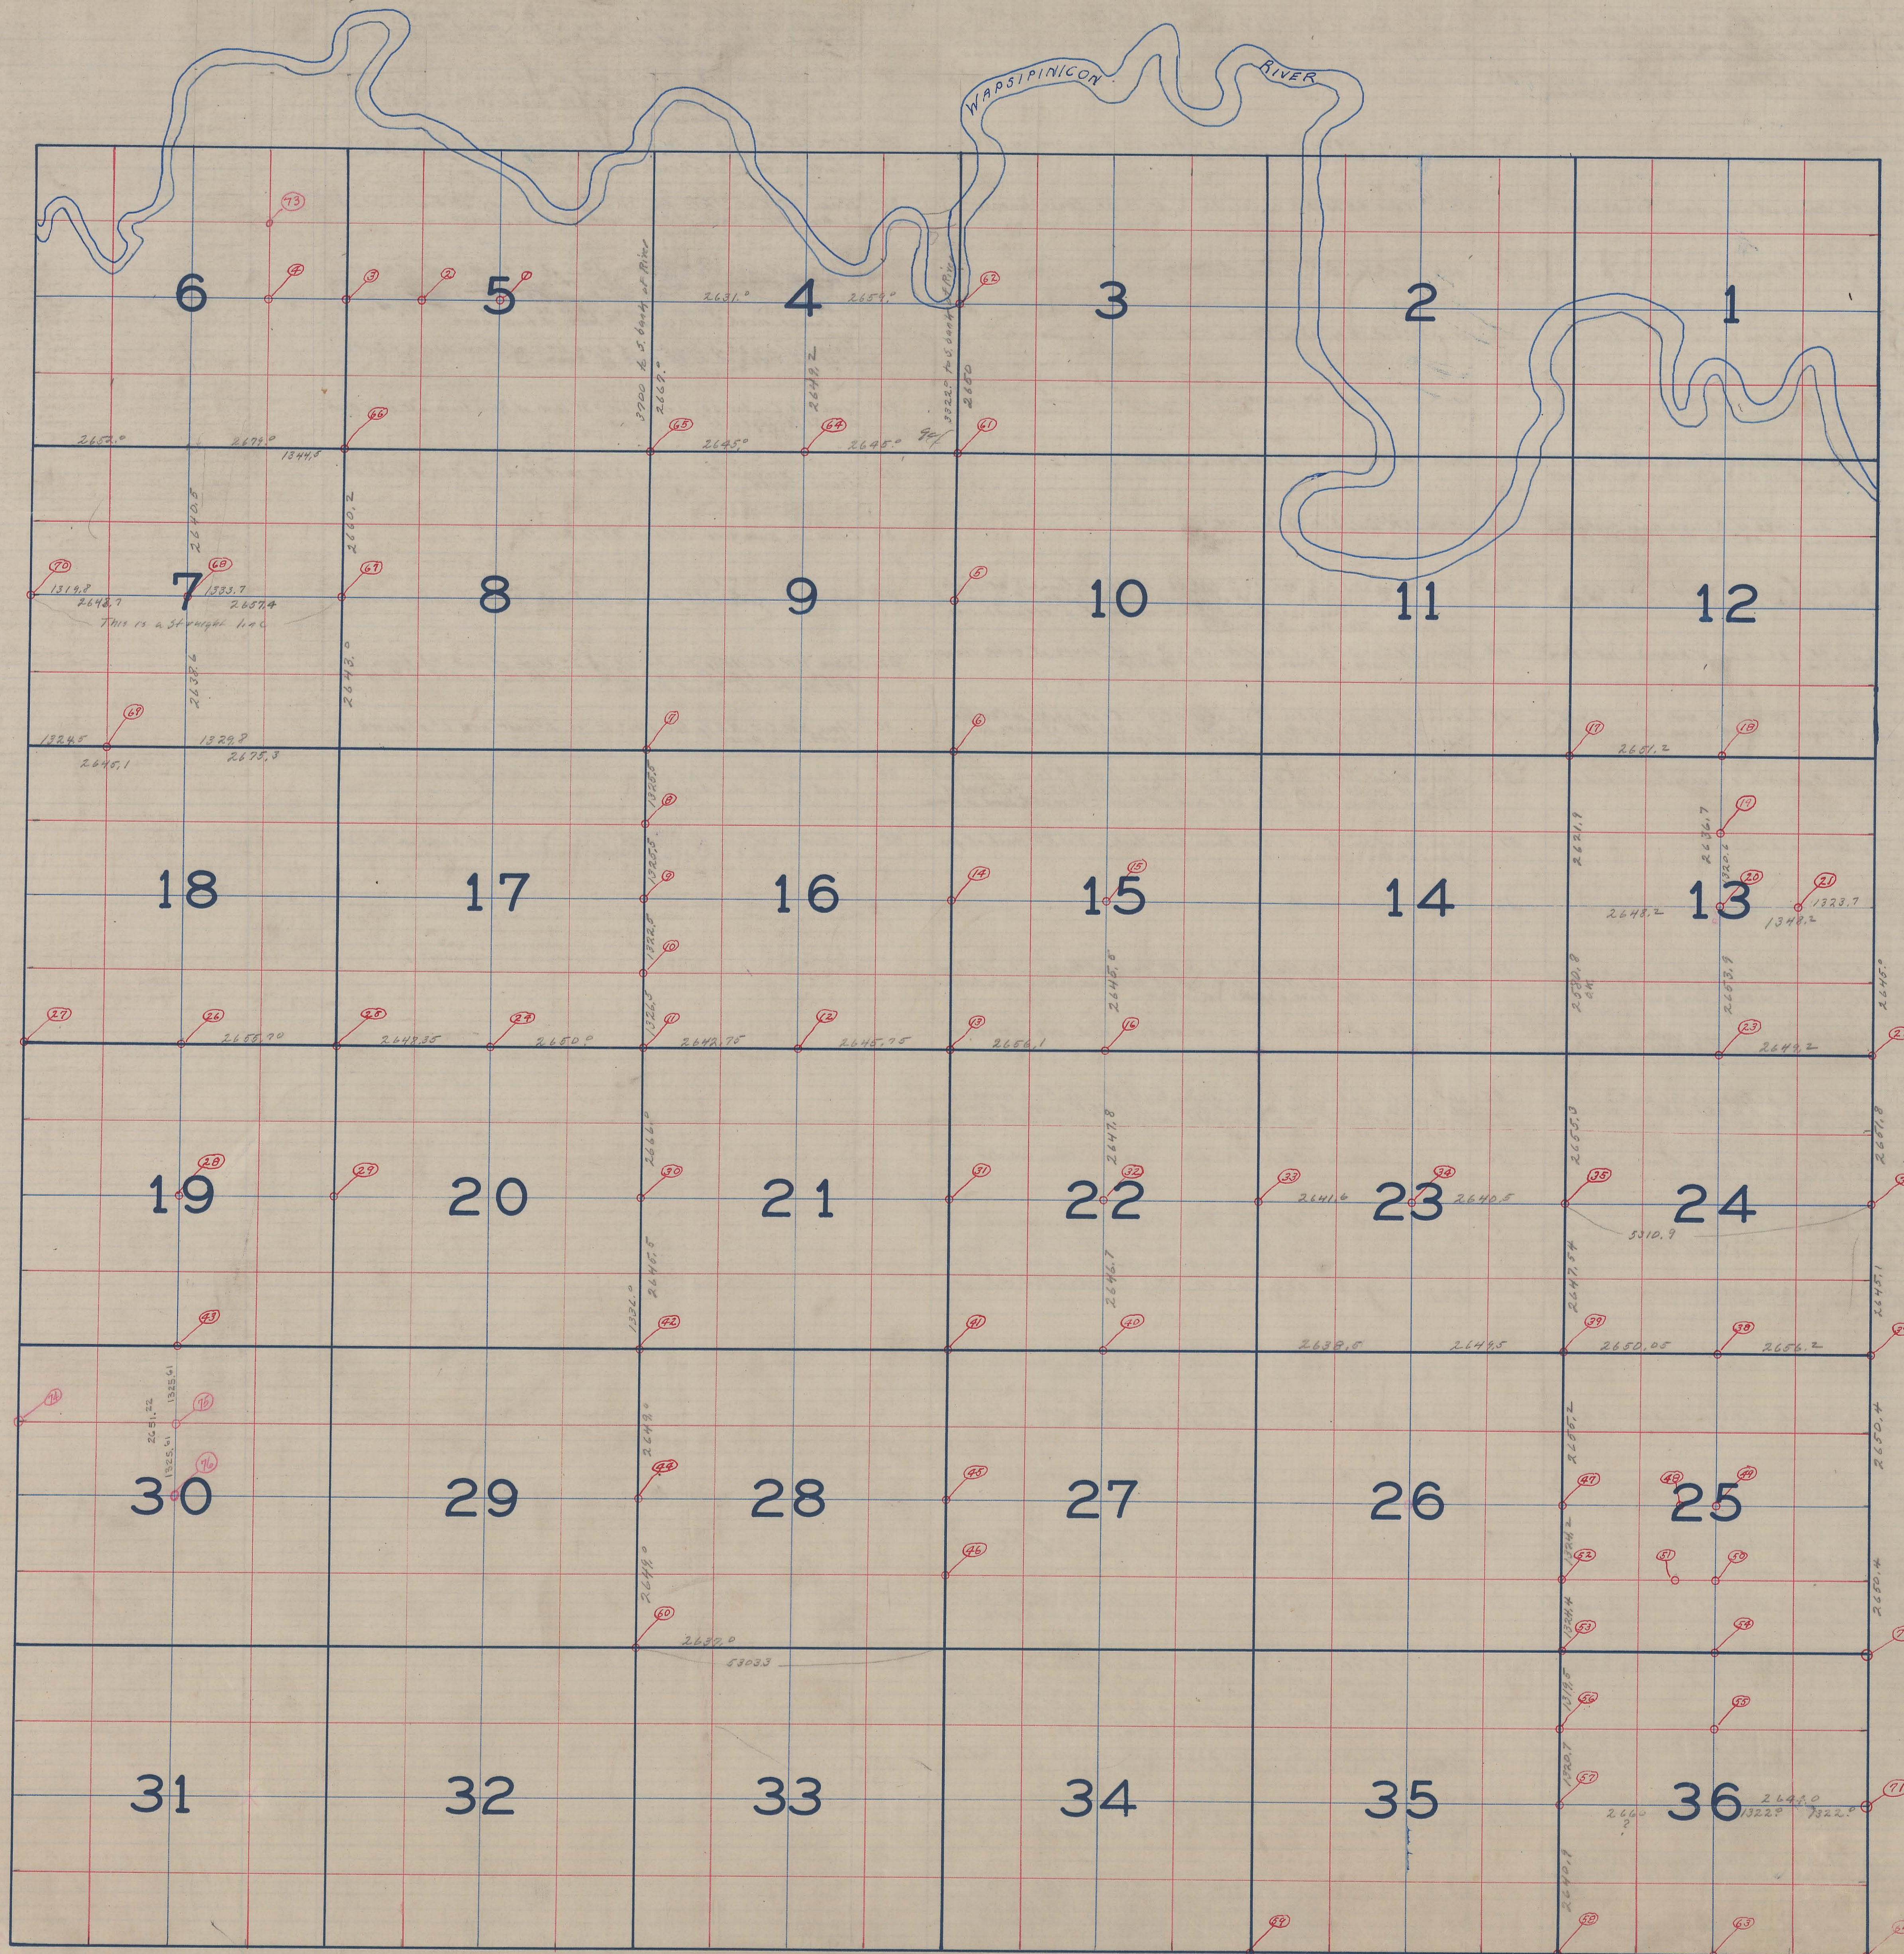

2172  
2173  
