1 Stone NE Cor Sec. 7 : it is 72.4 East of 2 spikes in Box elder tree : it is 111.0 Ft SE. of S.E. Cor of School Bldg : it is 29% East of Fence and 29% West of Fence

2 Stone NE Cor SE¼ Sec. 7 : it is 16.2 S. of Fence East it is in ℄ below Fences

3 Stone SE Cor Sec. 7 : it is 23' East of Fence South : it is 32.W. of Fence S. it is 28.2° W. of Fence North : it is 33' East of Fence North : it is 24' S. of Fence W. it is 25% N. of Fence W. it is 21% S. of Fence E. it is 26% N. of Fence East : it is 44' S.W. of spike in Tel. pole : it is 40.8 NW. of Cor. Cor. post : it is 53.2 N.E. of spike in Box elder : it is 52.2 SE. of spike in Fence post

4 Gas pipe SE Cor Sec. 18 : it is 45.1 NE. of spike in Cor. post : it is 41.2 SE. of spike in Tel. pole : it is 74.5 S.W. of spike in Power pole : it is 30' East of Fence North : it is 30' W. of Fence N. it is 30' N of Fence West : it is 30' S. of Fence West : it is 39.22 SE. of Drain Cap

5 Stone SE Cor. NE¼ Sec. 19 : it is 39.6 NW. from spike in W. Root of Maple : it is 56' N.W. from spike in N.W root of maple

6 Stone S.E. Cor. Sec. 19 : it is 28.5 S.W. of iron pipe fence post : it is 34.2 N.W. of spike in fence post : it is 28.3 NE. of spike in fence post : it is 29.5 SE. of iron pipe fence post.

7 Stone + gas pipe NE. Cor. N.W¼ Sec. 20 : it is 2' E. of Fence South : it is 40.° N. of spike in 3rd Fence post : it is 40 S. of spike in 3rd Fence post it is 36.5 W. of 2 spikes in fence post

8 Stone + gas pipe 10" deep NE Cor. Sec. 20 : it is 50' S. of gas pipe on fence line North : it is 55' N.E. of 2 spikes in top of hedge stump : it is on fence North : it is 44.2 N.W. of ALIGN Cor. post : it is 47.6 S.W. of spike in Tel pole

9 Stone + Gas pipe NE Cor. N.W¼ Sec. 21 : it is 3.5 West of fence South : it is 36.5 N.W. of spike in Box elder and 36.2 S.W. of spike in Box elder : it is 33.5 SE. of spike in pedestal post : it is 32.1 N.W. of spike in corner post : it is 63.0 N. of spike in fence post

10 Stone NE Cor. Sec. 21 : it is 57.4 N.W. of 2 spikes in maple : it is 49.8 S.W. of spike in fence post : it is 33.2 E. of Fence North : it is 30' W. of Fence North : it is 41.8 N. of S. fence : it is 43.2 N.W. of 2 spikes in walnut : it is 48.3 SE. of spike in post : it is 46.6 SE. of spike in Cor post

11 Stone + Gas pipe : it is on Fence line South on West side of Road : it is 50' N. of gas pipe : it is 50' S. of gas pipe : it is 63.2 NW. of spike in Wild Cherry

12 Stone + gas pipe SW Cor SE¼ of SE¼ Sec. 16 : it is 8' deep on Fence line South : it is 50.1' ft spike in "A" post : it is 32.2° N. of spike in cor post on line of fence S.

13 Stone SE Cor. Sec. 15 : it is on Fence line : it is 6" N of spike in RR. Tie fence post : it is 32.4 S. of Fence West

14 Stone Cte of Sec. 14 : it is 125.8 NE¼ from spike in tree : it is 41.25 S.W. from spike in Box elder : it is 215.8 East of spike in N.W. root of 20" white Oak : it is 54.8° East of Cor. post

15 Stone on Surface S.W. Cor. N.W¼ Sec. 13 : it is 101.° S. of S. RR. Fence : it is 143.° S. of ℄ of track : it is 37' east of east Tel. fence : it is 122.7 NE of end of NE wing of Conc. Bridge

16 Stone Cte of Sec. 13 : it is 26.5 South of ℄ of track : it is 46.3 S. of S. RR. Fence

17 Stone SE Cor NE¼ Sec. 13 : it is 29.6 S. of ℄ track : it is 110.6 SE of spike in RR. covering Sign post : it is 58.5 S.W. of RR covering sign post : it is 70.8 NW. of spike in pole : it is 45.5 S.W. of spike in pole : it is 82% E of Fence South : it is 14 West of Fence South : it is 35° W. of Fence North to track : it is 33' East of Fence North to track

18 Stone NE Cor Sec. 13 : it is 22 East of cross on West walk : it is 28' West of cross on east walk : it is on transit line between above mentioned crosses on walks : it is 33' West of gas pipe which is 6.0 Ft east of edge of walk + 1.7 Ft S. of edge of walk : it is 23.1 NW. of nut on top of fire hydrant : it is 10.0° N + 33' east of gas pipe at N.W. Cor. of Walnut St + Walcott St.

19 Stone S.W. Cor SE¼ Sec. 13 : it is on line of fences N+S. it is 23' North and 28.0° Ft. S. of Road Fences : it is 80 Ft North of h gas pipe

20 Stone N.W. Cor NE¼ Sec. 18 : it is in ℄ between Fences and it is on line of Fences North + South

21 Stone N.W. Cor. Sec. 18 : it is 24.4 South of spike in post : it is 24.2 North of spike in Box elder : it is 40.° N.W. of spike in hedge : it is 15' west of Fence North + 1.6° east of fence South

22 Stone + Gas pipe NE Cor. SE¼ Sec. 18 : it is 1.0° N of fence Vol. 17 is 73.8 NE of NE Cor of "Bourgeois Tomb Stone" : it is 40.° N of spike in walnut

23 Stone SE. Cor. Sec. 8 : it is 1.0° deep : it is on fence line South : it is 28.5 Ft South of fence : it is 27% North of fence

24 Stone Cte of Sec. 7 : it is on West side of west Cor. post

25 Stone N.W. Cor S.W¼ Sec. 7 : it is 2' North + 2.0° East east of true Cor. post

26 Stone N.W. Cor NE¼ Sec. 7 : it is 1.0° Ft. west of Cor. post

27 S.W. Cor. Sec. 6 : Referred to Cte of Cor. post (See above)

28 Not able to Locate : For future reference : it is on line of Fence S. and in ℄ between fences at Road

29 Stone SE Cor. SW¼ Sec. 20 : it is 33.8 SW. from spike in Box elder : it is 32' North of gas pipe : it is 12½ Ft. N. of fence : it is 3.4 E. of fence North : it is 7.5 Ft. East of fence South

30 Stone SE Cor. Sec. 20 : it is 53.0° E of spike in Box elder : it is 48.4 NE of spike in Willow : it is 57.3 N.W. of spike in maple : it is 35.5 SW. of spike in Cor. post : it is 27.5 South of Fence east : it is 30.5 Ft. North of fence east : it is 11.0 Feet north of Fence west : it is 30.0 South of fence west : it is 29.0° West of fence North

31 Stone Cte of Sec. 15 : it is on fence line west : it is 0.8 East of East Fence of Cor. post

32 Stone NE. Cor SE¼ Sec. 15 : it is 3.8 N. of fence west : it is 30.5 West of gas pipe : it is 27.0 N. 89 from Cor. post : it is 44.4 S.8 W. from spike in fence post

33 Stone SW. Cor. Sec. 1 : it is on hedge line east ½ ft N. of Cor. post

34 Stone SE Cor SW¼ of SW¼ Sec. 1 : it is 39.2 From spike in east side of Blazed 16" cottonwood : it is 57.0° NE of spike in maple

35 Stone SE Cor SW¼ Sec. 1 : it is 34.5 SW¼ From spike in Evergreen : it is 31.5 S.8 W. from spike in evergreen : it is 52.0 west of west Tree at residence

36 Stone SE Cor Sec. 1 : it is 22.3 South of fence : it is 23.7 north of fence : it is 8.4.7 SW¼ From spike in double elm : it is 61 NW of spike in maple

37 Stone NE Cor. SW¼ Sec. 1 : it is on N. side of Cor post
SEE BK 583 P 59

38 Stone N.W. Cor. SW¼ Sec. 1 : it is 12 W. of iron bar set by U.A.R. on hedge line : Stone is about 2.0 Feet West of hedge

39 Stone 3.0 feet deep put gas pipe on top : it is 4 Ft. SE East of SW¼ of NW¼ Sec. 1 : it is 50.0 east of gas pipe : it is 110 West of gas pipe

40 Stone NE Cor NW¼ of NW¼ Sec. 1 : it is on line of fence east + west and north : it is about 6.92 N. of Line 127-128

41 Stone N.W. Cor S.W¼ SE¼ Sec. 13 : it is at fence corner

42 Stone S.W. Cor Sec. 29 : it is in ℄ of both roads : it is 38.4 SW. of 2 spikes in plumb tree : it is 38.0° NW of 2 spikes in cor post : it is 38.4° SE. of 2 spikes in "Willow" : it is 28.1° NE of 2 spikes in Cor post

43 Cross on ℄ paving S.W. Cor Sec. 23 : it is 41.3 NE of cross on S. Hilton Curb : it is 44.25 SE of Cross on Hilton Curb : it is 52.35 NW. of cross on S. Hilton Curb : it is 65.4 SW. of cross on headwall of Curb

44 Stone SE Cor. NE¼ Sec. 32 : it is 45.5 east of spike in hedge stump : it is on line of fence west

45 Stone SE. Cor. Sec. 32 : it is 44.9 NE of spike in Cor. post : it is 44.6 SE of spike in power pole : it is 36.4 NW. of spike in Tower pole : it is 41.9 SW. of spike in power pole

46 Stone S.W. Cor. SE¼ Sec. 32 : it is in ℄ fences and 0.5 east of fence north : it is 0.5 West of fence south

47 Repaired (error)

48 Stone SE. Cor. Sec. 33 : it is 40' South of gas pipe : it is 33 North of spike in Mulberry tree

49 Stone N.W. Cor NE¼ of N.E¼ Sec. 14 : it is on S.W side of Cor. post

50 Stone N.W. Cor. Sec. 35 : it is 51.8 S.W. of 2 spikes in cottonwood : it is 38.3 NE of Conc. Cor. of corn crib : it is 38.3 SE of spike in Cor. post

51 Stone Cte. of Sec. 29 : it is on line of fence North + West : it is 6" deep

52 Stone N.W. Cor SW¼ Sec. 28 : it is 52.1 East of fence and 28' West of fence : it is 30' West of hedge stumps

53 Stone N.W. Cor Sec. 34 : it is 1.5 South of fence east + west : it is on line of hedge stumps South

54 Stone N.W. Cor NE¼ Sec. 34 : it is in ℄ below fences at 1885 Road : it is in ℄ below fences east + west and on line as line of pillars west : it is 38.2 S.W. of tree row in Cor. post : it is 44.2 NE of fence spikes in Tel. pole : it is 50.2 east of 2 spikes in Willow

55 Stone N.W. Cor of SW¼ Sec. 34 : it is 35.8 S.W. from spike in oak : it is 35.1 SE. of spike in oak : it is 28.2 West of spike in oak

56 Stone Cte of Sec. 34 : it is 53.2 SE of X Spk. Tel. Pole ; it is 38.0 SW of X Spk in Pa. Post ; it is 37.0 NE of X Spk. in Top of Fa. Post ; it is 49.5 NW of X Spk in Fa. Post ; it is 32.3 NW. of X Spk. Pa. Post. (New Ties April 1964)

57 Stone NE Cor SE¼ Sec. 34 : it is on line of Fence east + south and about 8' North of large willow

58 error did not dig for stone

59 Stone S.W. Cor. SE¼ Sec. 34 : it is 46.8° N.W. from pipe has marker : it is 67° NE. of spike in oak : it is 11.6 N. from 2 spikes in Box elder : it is 46.0° South of fence west : it is 30.0 N. of fence west : it is in ℄ of fences North + South

60 Stone S.W. Cor SE¼ Sec. 33 : it is 39.2 SE. of spike in hedge : it is 39.3 SW. of spike in hedge stump : it is 32.° south of spike in hedge stump : it is 29.9 NW of spike in Tel. pole : it is 2.8° North of fence : it is 32.° South of hedge stump

61 Stone N.W. Cor. SW¼ NW¼ Sec. 34 : it is 6" deep : it is on line of hedge north : it is 93.° South of spike in hedge stump

62 Stone Cte of Sec. 27 : it is 37.° SE X Spk. Fa. Post ; it is 37.2 SW of X Spk. in Fa. Post ; it is 52.0 NE of X Spk. Power Pole ; it is 47.0 NW of Spk. in Fa. Post ; it is 81.0 NW X Spk. Tel. Pole. (New Ties April 1964)

63 Stone N.W. Cor. SW¼ Sec. 5 : it is about 2¼ Ft. South of fence east : it is about in line of fence West : it is in ℄ between fences at North + South Road ; it is 81.° SE. spike fence post ; it is 32.8 Eaple Cor. post ; it is 66.6 SW spike in Cor. post

64 Stone S.W. Cor NW¼ of NW¼ of Sec. 5 : it is 12.82 south of south end of bridge : it is 58.0° NE of spike in Willow : it is 142.4 SE of spike in Willow : it is about 1 Ft between fences

65 Stone N.W. Cor. Sec. 5 : it is on line of fence east : it is 5.5° west + 6' North of Cor. post : it is 5.93 NW of NW corner of Paddock Tombstone : it is 6.5.6 NW of NW corner of Parker Tombstone ; it is 1.0 below surface

66 Stone Cte of Sec. 5 : it is 41.0° SE of Fa. Post ; it is 35.8 SE of Fa. Post ; it is 35.1 Due South of Cor. Post ; it is 46.0° SW of Fa. Post ; it is 49.6 NW of Fa. Post ; it is 48.9 NE of Fa. Post

67 Stone N.W. Cor NE¼ SE¼ Sec. 5 : it is 1.5 Ft. east of fence south : it is 56.4 NE of stump of box elder : it is 28.1 south of 2 spikes in Fork of fences

68 Stone N.E. Cor SE¼ Sec. 5 : it is on fence line N+S. : it is in ℄ between Road Fences : it is 89.0 north of spike in tree

69 gas pipe N.E. Cor. Sec. 24 : it is 22.0° west of spike in red + maple : it is 48.9 NE. of spike in power pole : it is 39.1 SE of spike in Cor. post

70 Stone N.W. Cor NE¼ Sec. 24 : it is in ℄ between fences and on fence lines north + south

71 Stone N.W. Cor. Sec. 24 : it is in ℄ between fences

72 Stone S.W. Cor. NW¼ Sec. 24 : it is 2' South of fence west : it is 39.0° east and 22.0 west of fence : it is 50' east of a gas pipe in fence line west : it is 4.0 Ft west of straight line from (71)-(73)

73 Gas pipe : SE Cor. NE¼ Sec. 24 : it is 34.7 SE of center of 1st steel post to north : it is 3' easterly from spike in power pole : it is 48.2 NE of spike in fence post : it is 31.5 NE¼ from spike in Tel. pole : it is 27.5 east of spike in fence post

74 Gas pipe SE Cor Sec. 24 : it is 35.55 NE of spike in power pole : it is 35.2 SE of spike in Cor. post : it is 36.55 NE of spike in Cor. post : it is 38.0° S.W. of spike in Tel. pole

75 Gas pipe S.W. Cor. SE¼ Sec. 24 : it is about in ℄ between fences

76 Stone S.W. Cor Sec. 24 : it is 30.8 North of spike in Cor. post : it is 15.6 NE of spike in hedge tree : it is 30.8 North of S. fence : it is 25.° South of North fence

77 Stone S.W. Cor SE¼ Sec. 23 : it is on fence line south : it is in ℄ between road fences

78 Stone S.W. Cor. Sec. 23 : it is 125½ E. of West fence line of lane running north : it is 48.3 N.E. of spikes in post : it is 58.0° Ft. NW. of spike in Cor. post : it is in ℄ between fences

79 S.W. Cor. SE¼ Sec 22 error no point here

80 Stone S.W. Cor. Sec. 22 : it is in ℄ between fences : it is 50' North of a gas pipe on fence line south : it is 41.8 NE. of spike in evergreen

81 Stone S.W. Cor SE¼ Sec. 21 : it is 29.4 N. of fence and 30' South of fence : it is 1.5 Ft. west of fence north : it is 3.8 east of fence south : it is 6" deep

82 Stone S.W. Cor. SE¼ N.W¼ Sec. 22 : it is 6" north of Cor. post

83 Stone S.W. Cor. SE¼ of N.W¼ Sec. 24

84 Stone S.W. Cor SE¼ SE¼ Sec. 23 : it is 24.8 north of spike in Cor. post : it is 57.4 SE of spike in Mulberry : it is 41.5 NE of spike in Cor. post : it is 44.4 NW of spike in Cor. post : it is 35 West of fence south : it is 23.0 Ft East of fence south : it is 49.0 Ft east of fence north : it is 2.0 Ft west of fence north : it is 25.° Ft South of fence east : it is 30' south of fence west : it is 38.0° north of south fences

85 Stone Cte of Sec. 26 : it is on line of hedge S + N. it is 4' north of hedge running east : it is 6.5 Ft east of hedge north

86 Stone : S.W. Cor SE¼ NW¼ Sec. 26 : it is on N.W. side of Cor. post

87 Stone S.W. Cor. NW¼ Sec. 26 : it is on west side of post

88 Stone S.W. Cor. SE¼ NE¼ Sec. 27 : it is by Cor. post

89 Stone S.W. Cor. NW¼ S.W¼ Sec. 26 : it is 2.0° east of brace post of fence line running west

90 Stone S.W. Cor. NW¼ of NW¼ Sec. 18 : it is 3.° south of Wild cherry

91 Stone S.W. Cor N.W¼ Sec. 18 : it is 9.° South of east and west fence : it is 9.° Ft south of gas pipe on fence line : it is 18" deep

92 Stone S.W. Cor Sec. 18 : it is 31.5 SE of Cte. of catch basin : it is 39.4 N.E. of Cor. of catch basin : it is 41.5 SW. of Chief catch basin : it is 40.9 NW. of iron Cor. post : it is 23.0 south of fence east and 28.0° south of fence west : it is 23.0° North of fence east : it is 30' North of fence west : it is 20.° east of fence north : it is 2.4° west of fence south : it is 27.° east of fence south : it is 32.° west of fence north

93 Stone S.W. Cor. SE¼ Sec. 17 : it is in ℄ between fences : it is 1.0° west of fence north : it is on line of fence S.

94 Stone Cte. Sec. 16 : it is 2.° west of hedge south

95 Stone N.W. Cor. SW¼ Sec. 21 : it is 3½ Ft. west of a straight line from point (B) to point (D) : it is on line of fence east : it is 33.0° east of fence : it is 23% west of fence

96 Stone N.W. Cor. Sec. 16 : it is 32.4 NE of corner of corn crib : it is 66.5° SE of 2 spikes in maple : it is 29.0° South + 23° Ft north of fence east : it is 27.° Ft. West and 28° east of fence south

97 Stone S.W. Cor NW¼ Sec. 32 : it is 50.° West of gas pipe : it is 18.° east and 21° west of fences

98 Stone S.W. Cor. Sec. 32 : it is 23½ south of north road fences : it is 29.° north of fence east : it is 20.° north of hedge west : it is 28½ east and 26.° Ft. west of road fence : it is 11.° East + 8.° west of fence north : it is 42.° NW. of spike in Power pole : it is 45.° SW. of pipe line station marker : it is 38.° SW of spike in Cor. post

99 Stone N.W. Cor Sec. 30 : it is 36.3 SE of iron Cor. post : it is 43.6 NE of iron Cor. post : it is 28° north + 24½ south of fences west : it is 20° north + 21° East south of fences east : it is 38° east and 38° west of fences south : it is 27° east and 33 west of fences north

100 Stone N.W. Cor S.W¼ Sec. 19 : it is 2.° South of fence west : it is 50.° east of gas pipe : it is 30.° west and 35% east of road fences

101 Stone N.W. Cor. SW¼ Sec. 30 : it is 5.3 east of a straight line from No. (B) to (D) : it is 27° West and 22° east of fences : it is 45.° east of spike in east of walnut

102 Stone S.W. Cor. Sec. 30 : it is 51.3 SE of spike in Tel. pole : it is 58.2 NE of spike in Tel. pole : it is 28.0° east and 28.° west of fence north : it is 24.0° east and 29° west of fence south : it is 17% south and 19.0 Ft north of fences east : it is 29.° south and 27.° north of fences west

103 Stone (A) gas pipe SW Cor NW¼ Sec. 31 : it is 31.0° east and 31.0° west of road fences : it is on line of fence east : it is 3.0° south of fence west : it is 50° east of a gas pipe on fence line West

104 Stone SW Cor. Sec. 31 : it is 38.2 SE of spike in Cor. post : it is 41.7 SW of spike in Cor. post : it is 46.° NW of spike in power pole

105 Stone NE Cor Sec. 5 : it is by Cor. post

106 Stone SW Cor SE¼ Sec. 5 : it is on north + south fence line

107 Stone Cte Sec. 11 : it is by west gate post : it is 15.° west of N.+S. fence

108 Stone SW Cor NW¼ NE¼ Sec. 12 : it is 1½ Ft. south of Cor. post

109 Stone N.W. Cor NE¼ Sec. 31 : it is 1.0° south of straight line (B) to (D) : it is 18 south and 28° north of fences : it is 50.° north of gas pipe : it is on fence line South

110 Stone SW Cor SE¼ Sec. 31 : it is 53.0 N. of gas pipe : it is 22% south and 28° north of fence

111 Stone S.W. Cor. S.E. ¼ Sec. 31 : it is on line (33)-(112) : it is 14½ Ft North and 38 Ft South of Road Fences : it is on fence line north : it is 26.° north of the face of a post fence : it is 36½ Ft east of a fence running South

112 Stone S.W. Cor. of Sec. 2 : it is 22' South and 40' north of gas pipes : it is on a straight line from south gas pipes : it is 6.0 Ft east of fence South : it is 22½ N. of fence east and 25½ N. of fence West : it is 22½ S. of N. fence : it is 41.° N.E. of spike in Box Elder tree

113 Stone : N.W. Cor. Sec. 2 : it is 27.4 N. of fence of Concrete post : it is 24.5 South of Cor. post : it is 28.0 south of hedge

113 X Stone N.W. Cor. S.W¼ Sec. 2 : it is on East + West fence line and it is 333 Ft. West of a Cor. Post

114 Stone Cte of Sec. 2 : it is between Cor. Posts.

115 Stone S.W. Cor. SE¼ of SE¼ Sec. 3 : it is 27½ N + 27.92 South of fence North : it is 24 N. of fence east : it is 24.5 + 32.5 N. of fence West : it is 24 and 9.22 N. of fence North : it is 24½ East + 30 N. of fence South : it is 31.5 Ft NE of Spike in power pole : it is 16.° 60.° N.W. of Spike in 18" Willow SEE BK 200 P 77

116 Gas pipe S.W. Cor. SE¼ Sec. 3 : it is 15½ Ft. N. of a Straight line from (112) to (113) : it is on fence line North : it is 46½ east of east Face of house : it is 50 S. of a gas pipe on fence line north : it is 27½ Ft. S. + 27 N. of Road fences

117 Stone S.W. Cor. SE¼ of SE¼ Sec. 4 : it is 26½ Ft. N of fence + 27 Ft. S. of fences : it is 20½ east + 24½ W. of Road fences : it is 33.9 NW of Spike in Tel pole

118 Stone S.W. Cor SE¼ Sec. 4 : it is on fence line North : it is on line of (33)-(113) : it is 17 N. + 33 Ft. S. of fences. it is 30.° South of a gas pipe on fence line North : Stone is on fence line North

119 S.W. Cor SE¼ of NE¼ Sec. 3
TILE MONT BK 200 P 77

120 Stone Cte of Sec. 3 : it is at fence Corner
BK 200 P 77 & 64

121 Stone S.W. Cor N.W¼ Sec. 3 : it is 26' N. + 26' S. of Road fences : it is 50.° N. of a gas pipe

122 Stone S.W. Cor SE¼ of NE¼ Sec. 4 : it is 4½ Ft N.W. of spike in Evergreen : it is 6½ NE of Spike in Tel. pole : it is 21½ S. of Spike in Tel. guy pole : it is 3N. east and 1N West of fences South : it is 35' S. of fence West + 26.° S. of fence East : it is 5.0° east of fence North : Stone is 6" deep

123 Gas pipe Cte of Sec 4 : it is on line (B) + (121) : it is 26.4 N. + 26.9 S. of Rd. fences : it is 40.10 NE of Spike in blazed base of Wild Cherry tree

124 Gas Pipe SW Cor SE¼ of SW¼ Sec. 4 : it is 7.2 Ft. West of fence line North : it is 50' Ft From a gas pipe on line of fence North : it is 29.5 N.W. of Spike in power pole it is 50.4 NE of Spike in Power pole

125 Stone S.W. Cor. SE¼ Sec. 2 : it is 46.2 N.W. of Spike in apple tree : it is 25.2 NE of Conc. Post : it is 26.0 N. of fence : it is 33' S. of Fence

126 Stone S.W. Cor. SE¼ of NE¼ Sec. 3 : it is 22.6 NE of Spike in Wild Cherry tree : it is 18.6 SE of 2 spikes in Cor. post : it is 3.0° east of Fence N+S : it is 10.0 S. of Fence line east : it is 11.0 N + 39 Ft S. of Road Fences

127 Stone N.E. Cor. N.W¼ Sec. 1 : it is 1.0° South of Cor. post

128 Stone N.W. Cor. Sec. 1 : it is just east of two posts marking division point of Fences : it is on fence line

129 Stone N.W. Cor. NE¼ of NE¼ of Section 2 : it is on line (128) (130) and is about 1.0 South of Cor. post

130 Stone N.W. Cor. N.E¼ Sec. 2 : it is on Fence line East + West and is 235' West of Fence North

131 NE Cor Sec 34 N.E¼ Sec. 4 where : it is 69.6 SE of X Spk. Guard Rail ; it is 121.8 SW of X Spk. Top Fa. Post ; it is 99.3 NW of X Spk. in Fa. Post

132 Stone NE Cor N.W ¼ Sec 3 : it is by carpost on line of hedge South.

133

134 See Field Book # 200 pages 65-76

135 See Field Book # " pages 65-76

136 See Field Book # " pages 65-76 # 1

137 See Field Book # " pages 65-76

138 See Field Book # " pages 65-76

139 See Field Book # " pages 65-76

140 GAS PIPE SEE BOOK 600 PAGE 65

141 CONC MONT SEE BOOK 207 PAGE 43

142 CONC MONT SEE BOOK 207 PAGE 43
NOTE 2 CORTON

143 CONC MONT SEE BOOK 595 PAGE 21

144 GAS PIPE SEE BOOK 595 PAGE 21

145 GAS PIPE SEE BOOK 595 PAGE 21

146 CASTINGS SEE BOOK 595 PAGE 21

147 CONC. MONT W/ PIN BK 583 P 59 Ties Pg. 56

148 GAS PIPE BK 583 P 59

149 TILE MONT BK 200 P 77

150 GAS PIPE SEE SURVEY BOOK 200 P 64 & 77

151 GAS PIPE SEE SURVEY BOOK 200 P 64 & 77

152 GAS PIPE SEE SURVEY BOOK 200 P

153 GAS PIPE SEE SURVEY BOOK 200 P

154 CONC MONT SEE SURVEY BOOK 200 P

T. 80 N. R. 1 E. OF 5TH P.M.
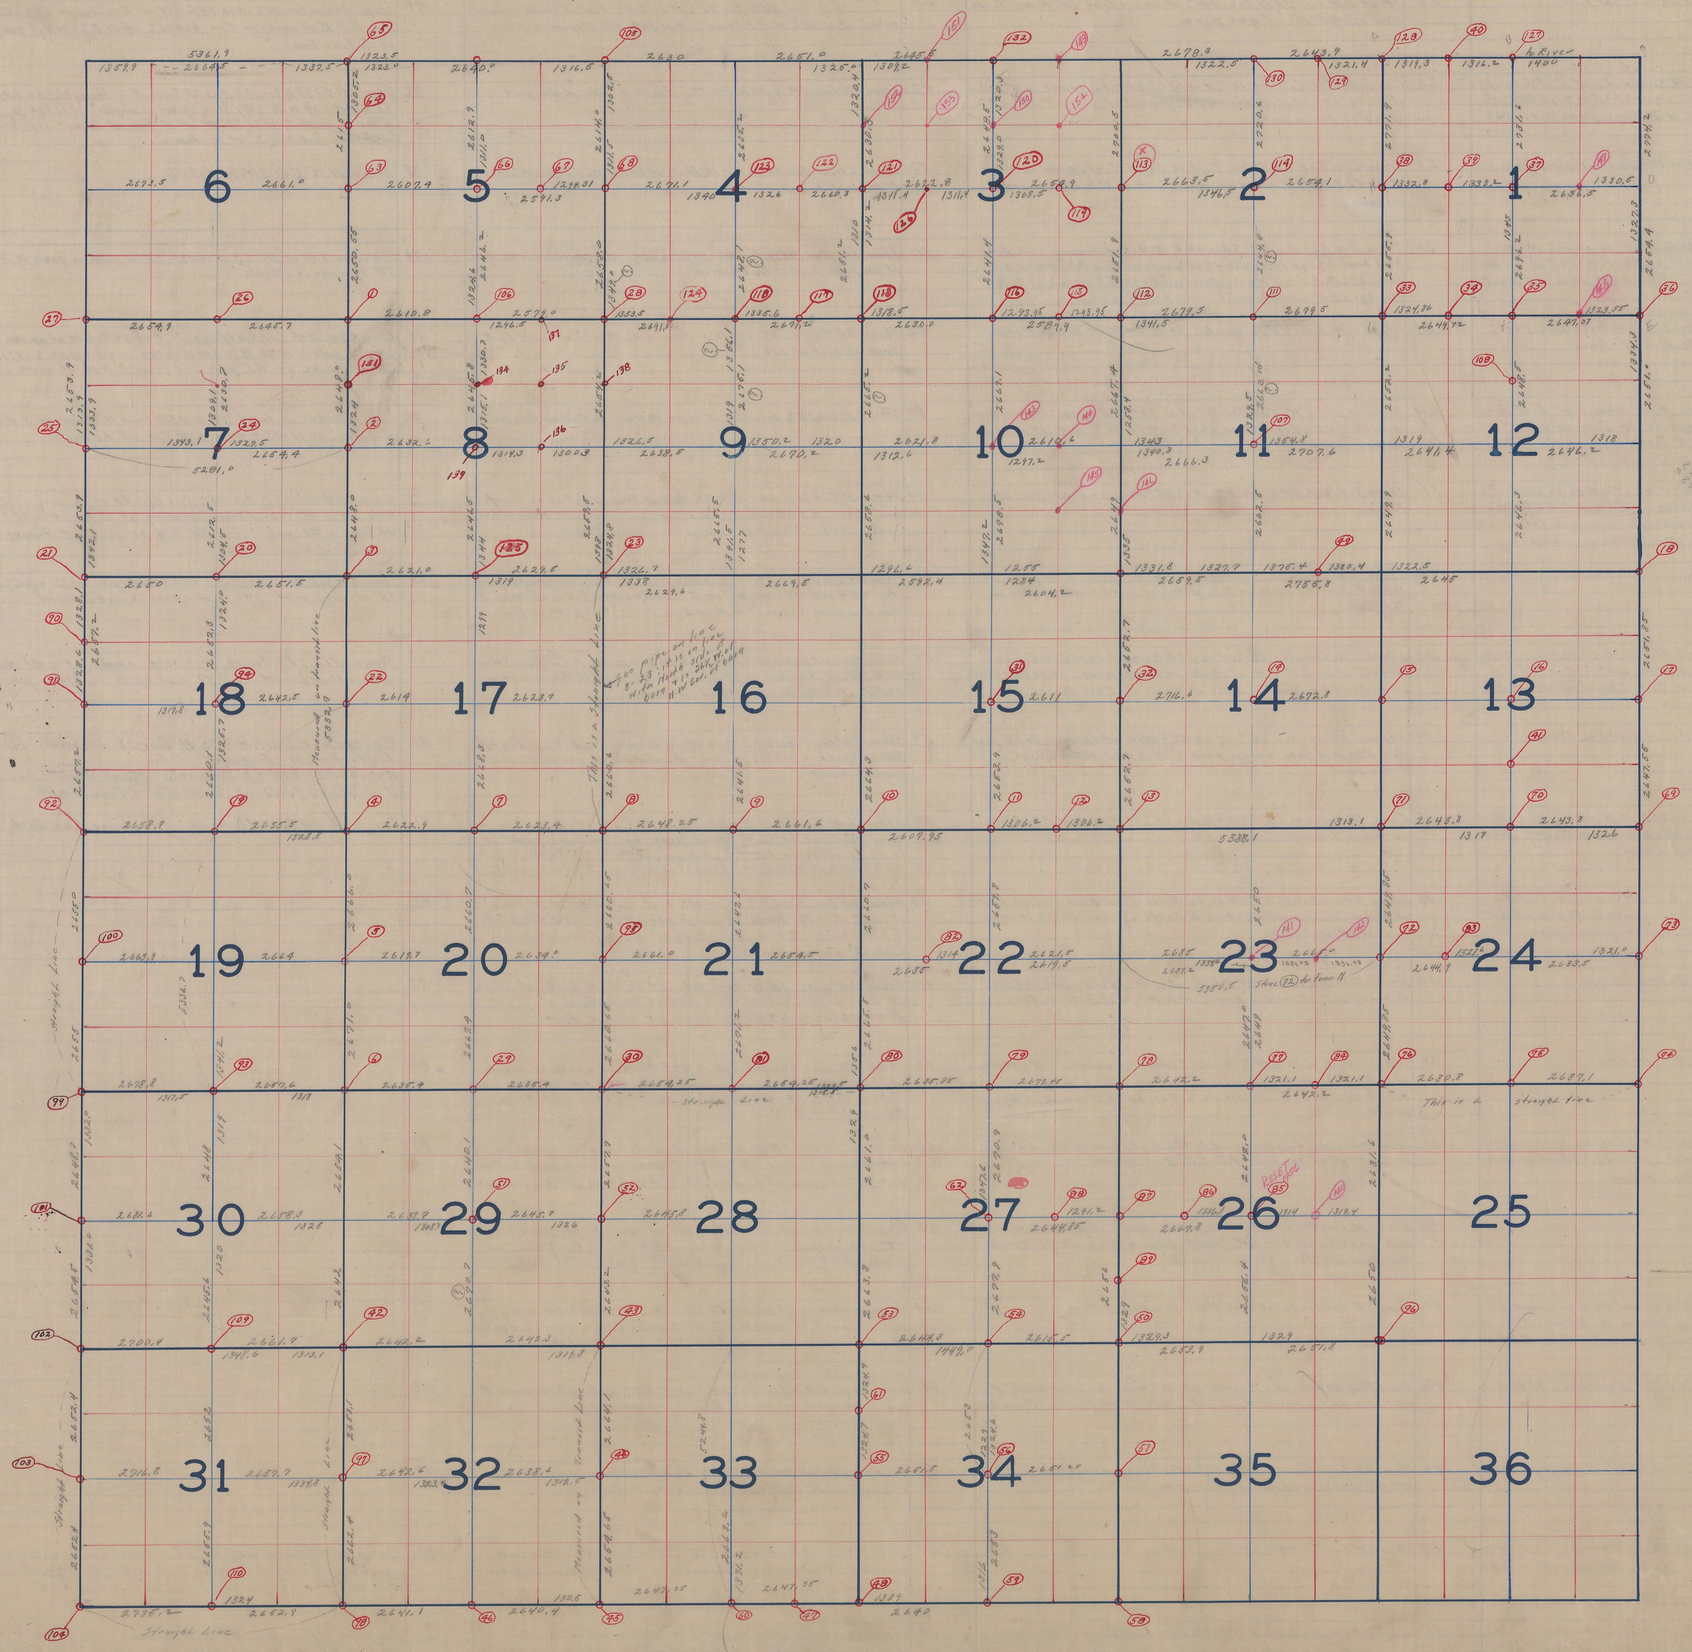
LIBERTY TOWNSHIP