


T. 80 N. R. 3 E. OF 5TH P.M.

1	Stone No. 10	26	Stone S.W. Cor. SE 1/4 Sec. 17; it is 68.9 S.E. of spike in 4th of hedge clamp; it is 33.2 NE of spike in hedge line; it is 27.3 North of Ctr. of Car. post	43	in fence post	74	Stone Ctr. of Sec. 9; it is 368 ft. S. of bridge spike in RR line; it is 32.2 N. of Rd. fence; it is 75.2 East of Rd. fence; it is 15.2 N. of S. RR fence; it is on line of hedge east and fence north
2	Stone Ctr. of Sec. 10; it is on fence line; it is 38' South and 27' North of fence	27	Stone S.W. Cor. Sec. 17; it is 01.1 NE. of spike in Car. at base; it is 39.7 NW. of 2 spikes in Car. post; it is 38.1 SW. of 2 spikes in Car. post; it is 37.5 SE. of 2 spikes in Car. post	47	Stone NE Cor. SE 1/4 Sec. 22; it is 11.4 N. of it is in a plowed field and is 133.25 South of a gas pipe on a fence line running E. & W.; it is 57.9 East of 2 of Road	75	Stone NW Cor. SW 1/4 Sec. 13; it is 79.2 S.W. 2 spikes in 2nd "Cotton wood"; it is 52.5 W. of 2 spikes in 2nd "Cotton wood"; it is 20.1 N. of fence; it is 20.1 W. of Gas pipe; it is 2.0 W. of car post; it is 14.5 W. of the road fence; it is on line of fence N.
3	Stone NW Cor. SW 1/4 Sec. 10; it is on line of fence south and is 9' between Road Fence	28	Stone SW Cor. SE 1/4 of SE 1/4 Sec. 17; it is about on fence line N. and is 8.3 S.W. of spike in willow; it is 36.1 NE of spike in West fence post; it is on line 27-29	50	Stone NE Cor. Sec. 29; it is on S. Fence of E. & W. Road and is on line of fence N.	76	Center of Sec. 14 TILE MONT it is S.W. 18' x spk in fence Post it is W. 8' x spk in fence Post it is N.W. 8' x spk in fence Post
4	Stone Ctr. of Sec. 9; it is 26.5 S. of fence West; it is 14.1 West from Post 30' N. of fence East; 26.5 S. of fence East; 46.5 NE. of spike in locust; 39.7 NW. of spike in Car. post; 42.2 S.W. of spike in Tel. Pole; 38' East of fence S.; 27' W. of fence S.; it is 30' W. of fence North; it is 26' East of fence North	29	Stone SW Cor. SE 1/4 Sec. 18; it is 50.8 NW. of 2 spikes in Catalpa tree; it is 47.5 S.W. from 2 spikes in 2nd; it is 69.9 S.E. of 2 spikes in apple tree	51	Stone Ctr. of 36" Maple; NW Cor. of NE 1/4 Sec. 29; there is a cluster of spikes on S. side and East side of tree; there is also a stone 30' East of tree	77	CONC. MONT SEE BOOK 206 PAGE 55 & 56
5	Stone NW Cor. SW 1/4 Sec. 9; it is 27.7 S. of fence; it is 40' S. of fence; it is 36.4 East of fence & 26.4 W. of fence	30	Stone SW Cor. Sec. 18; it is 43.1 SE. of spike in fence post; it is 45.8 SW. of spike in hedge Car. post; it is 43.1 NW. of Ctr. of base; it is 24.4 NE. of spike in Car. post	52	Gas pipe NW Cor. of S.W. 1/4 of S.E. 1/4 Sec. 22; it is on line of fence East and is 6' West of West Rd. fence and is 30' West of a gas pipe on fence line East	78	GAS PIPE SEE BOOK 206 PAGE 55 & 56
6	Stone 6' deep; it is NW Cor. of S.W. 1/4 of Sec. 8; it is on West side of Car. post	31	Stone NW Cor. SW 1/4 Sec. 20; it is 32.8 East of fence post; 27' West of Wild cherry; it is 30.4 NW. of Boulder tree; it is 73.8 SW. of a wild cherry tree	54	Stone NE Cor. NW 1/4 of NW 1/4 Sec. 28; it is 58.5 S.E. of spike in Car. post; it is 32.5 SW. of spike in Tel. pole; it is 50.5 NW. of spike in Tel. pole; it is 40' East of fence North; it is 17.8 West of fence North; it is 19.4 West of fence South; it is 36' East of fence South and is in E. between fence East & West	79	CONC. MONT SEE BOOK 206 PAGE 55 & 56
7	Stone SW Cor. Sec. 8; it is 68.1 NW. of spike in hedge line; it is 42.2 NE. of spike in Tel. pole; it is 26.0 S.W. of spike in willow clamp; it is 30' S. of a gas pipe	32	Stone NW Cor. of SW 1/4 of Sec. 21; it is 8' deep; it is 73.0 NW. from 2 spikes in 4th cotton wood; it is 31.1 East of 2 spikes in 12" cotton wood; it is 46.5 E. of 2 spikes in 24" cotton wood; it is 27.8 E. of W. fence; it is 29' West of East fence; it is 15' N. of fence West; gas pipe on top	55	Stone SE Cor. SW 1/4 of NW 1/4 Sec. 23; it is 30.5 East of the Car. post; it is 78.4 West of spike in fence post; it is 83.1 NE. of spike in Tel. pole; it is 30' East of fence; it is 28' West of fence; it is 1.3 South of fence East & West	80	CONC. MONT SEE BOOK 206 PAGE 55
8	Stone SW Cor. SE 1/4 Sec. 8; it is 28.5 N. of S. fence and is on line of fence East	33	Stone SW Cor. SE 1/4 Sec. 20; it is 2' South of Ctr. of fence post; it is on line of fence North and hedge South	57		81	CONC. MONT SEE BOOK 206 PAGE 10 & 11
9	Stone SE Cor. Sec. 8; it is 30' W. of hedge, 30' E. of hedge; it is 42.2 SE. of spike in Car. post; 47.1 NE. of spike in willow	34	Stone SE Cor. Sec. 20; it is 20.8 West of East fence; it is 25.2 East of West fence; it is on line of fence East & West; it is 6' deep;	58	Stone SW Cor. SE 1/4 NE 1/4 Sec. 24; it is 11.2 S.W. of 2 spikes in Boulder; it is 88.1 NW. of spike in 6" evergreen; it is 33' West of gas pipe in Road on line 49-55	82	GAS PIPE SEE BOOK 206 PAGE 10 & 11
10	Stone SW Cor. SE 1/4 Sec. 9	35	Stone SE Cor. of NE 1/4 Sec. 21; it is 20.8 N.W. of corner in S.W. Hwy culvert; it is 94.5 N.E. of 2 spikes in Tel. post; it is 87.5 S.E. of N. face of Hwy	59	Stone Ctr. Sec. 26; it is in E. of Road fence and on line of fence North & South	83	GAS PIPE SEE BOOK 206 PAGE 10 & 11
11	Stone SE Cor. Sec. 9; it is 30.1 SE. of spike in Box elder; it is 63.8 NE. of spike in Tel. pole; it is 60' West of gas pipe on line of fence East	36	Stone 1" deep Ctr. of Sec. 28; it is 3.2 West of fence North; it is 34.4 S. of N. fence; it is 32.4 N. of S. fence	60	Stone SE Cor. NE 1/4 Sec. 26; it is 32.0 East of fence South; it is 3' West and 20' North of a gas pipe on South fence line	84	CONC. MONT SEE BOOK 206 PAGE 10 & 11
12	Stone SE Cor. Sec. 10; it is 2' West of Car. post	37	Stone NE Cor. of SE 1/4 Sec. 28; it is on N. side of Car. post	61	Found Stone NE Cor. SW 1/4 Sec. 10; it is on surface 4' North of Car. post	85	CONC. MONT SEE BOOK 206 PAGE 10 & 11 # Book 614 Page 16
13	Stone SE Cor. Sec. 13; it is 33' N. of S. fence; 33' S. of N. fence; it is 6.2 East of fence South & 14.4 West of fence North; it is 33.1 S. of spike in hedge fence post; it is 36.6 S.W. of spike in Car. post	38	Stone Ctr. of Sec. 29; it is 7.5 East of fence North; it is 28' South of North fence; it is 24.8 West of S. fence; it is 43.8 SE. of spike in maple; it is 57.8 South of spike in fence post	62	Stone Ctr. Sec. 11; it is 3.5 South of Car. post	86	CONC. MONT SEE BOOK 206 PAGE 10 & 11
14	Stone SW Cor. SE 1/4 Sec. 13; it is 33.4 S. of N. fence; it is 33.4 N. of S. fence; it is 36.1 SE. of spike in fence post; it is 41.5 N. of spike in fence post; it is 41.8 S. of spike in fence post; it is 93.0 NE. of spike in apple tree	39	Stone NW Cor. SW 1/4 Sec. 29; it is 27.8 East of West fence North and South; it is 26' West of fence North; it is 24' West of fence South; it is 27.8 North of fence East; it is 29.4 S. of fence East; it is 30.5 SE. of spike in Car. post; it is 30.8 NW. of spike in Car. post; it is 32.8 SW. of spike in Car. post; it is 36.2 NE. of spike in Car. post	63	Stone SE Cor. NE 1/4 Sec. 11; it is 20.5 S.W. from spike in Wild cherry; it is 2.2 S. Ely from spike in Wild cherry	87	CONC. MONT SEE BOOK 206 PAGE 10 & 11 See Book 614 Page 20
15	Stone SW Cor. Sec. 13; it is 42.3 S. of spike in hedge tree; it is 77.8 SE. of spike in 30" willow; it is 30' S. of N. hedge; it is 29' N. of S. hedge	40	Stone Ctr. of Sec. 30; it is on fence line North and is 27.4 South of North fence; it is 33' North of South fence	64	Stone SE Cor. NE 1/4 Sec. 12	88	TILE MONT SEE 220 PAGE 54
16	Stone NW Cor. NE 1/4 of NE 1/4 Sec. 22; it is 30' S. of fence, 30' N. of fence; it is on line of hedge running North & South about 300' N. of Rd.	41	Stone SW Cor. of NW 1/4 of Sec. 30; it is 2.2 East of fence South; it is 19.2 East of fence North; it is 16' West of fence North; it is 23.6 West of S. fence; it is 32.0 S. of N. fence East	65	Gas pipe by J.M. Malley NW Cor. NE 1/4 Sec. 12; it is 3' West of North & South fence	89	TILE MONT SEE 220 PAGE 54
17	Stone SW Cor. SE 1/4 Sec. 14; it is 17.2 S.E. of spike in Wild cherry in church yard; it is 17.2 S.W. of spike in Maple on Edge of hedge to church; it is 30' S. of N. hedge	42	Stone NE Cor. of Sec. 33; it is 37' West of Car. post and on line fence East NW.	66	Stone NW Cor. NE 1/4 Sec. 11; it is in plowed field; it is about 2' deep; it is 302.0 R. S. of a gas pipe in east & west fence line; it is on line with said gas pipe and stone No. 6	90	STONE: SEE BK 206 P. 1
18	Stone SW Cor. Sec. 14; it is 18' deep and has a gas pipe on top; it is 29.8 South of hedge; 29.4 N. of S. fence 22' East of N.E. fence	43	Stone NE Cor. Sec. 33; it is 35.8 East of spike in Car. post; it is 30.4 N. of spike in Boulder tree; it is 6.8 SE. of spike in Tel. pole	67	Stone NW Cor. NE 1/4 Sec. 11; it is on E. side of Car. post	91	STONE: SEE BK 206 P. 1
19	Gas pipe SW Cor. SE 1/4 Sec. 15; it is 30' S. of hedge & 23.5 S. of NW fence and is on line of fence North	44	Stone on line of fence N. it is 30.4 S. of fence & 30.4 N. of fence	68	Stone NW Cor. NE 1/4 Sec. 11; it is on N. edge of pond; 10' N. of fence 6'; it is on surface	92	STONE: SEE BK 206 P. 1
20	Stone SW Cor. Sec. 15; it is 44.3 N. of 2 spikes in top of hedge stump and is on line of hedge about 50' South	45	Stone SW Cor. Sec. 26; it is 93.6 S.W. of spike in Tel. pole; it is 122.4 NE. of spike in Tel. pole; it is 30.4 S.E. of spike in Tel. pole; it is 30' N. of S. fence	69	Stone NE Cor. Sec. 9; it is 7' West of post	93	Ref. from Iron Pins BK. 600 pg. 77
21	Stone NW Cor. SW 1/4 NW 1/4 Sec. 15; it is 1.5 N. of fence West and is on West of fence	46	Gas pipe SE Cor. SW 1/4 Sec. 26; it is on West side of Car. post	70	Stone NW Cor. Sec. 9; it is on plowed field; it is about 2' deep; it is 302.0 R. S. of a gas pipe in east & west fence line; it is on line with said gas pipe and stone No. 6	94	Ref. from Iron Pins BK. 602 pg. 77
22	Stone it is 30.4 SE. of 200' in Box Elder; it is 1.0 ft. S. of fence West and is 40' East of a gas pipe on fence line West	47	Stone SW Cor. NW 1/4 Sec. 32; it is 40' West of gas pipe on fence line East; it is 23.4 West of East fence; it is 28' East of fence South; it is 35' East of fence North	71	Stone NW Cor. Sec. 9; it is on plowed field; it is about 2' deep; it is 302.0 R. S. of a gas pipe in east & west fence line; it is on line with said gas pipe and stone No. 6	95	Ref. from Iron Pins BK. 602 pg. 77
23	Gas pipe SW Cor. SE 1/4 Sec. 16; it is 27.7 NE. of 6" Box elder; it is 28.9 S. of corner in Car. post; it is 27.7 S. of 2 spikes in Car. post	48	Stone SW Cor. Sec. 33; it is 40' West of a gas pipe on fence line East; it is 122.4 SE. of spike in willow; it is 39.9 S.E. of spike	72	Stone NW Cor. NE 1/4 Sec. 11; it is on N. edge of pond; 10' N. of fence 6'; it is on surface	96	Nail on Hwy #61
24	Stone NE Cor. Sec. 20; it is 6' deep; it is 40.8 NW. of spike in Tel. pole; it is 44.5 N.E. of Car. post; 46.3 S.E. of Car. post	49	Stone SW Cor. Sec. 33; it is 40' West of a gas pipe on fence line East; it is 122.4 SE. of spike in willow; it is 39.9 S.E. of spike	73	Stone NW Cor. NE 1/4 Sec. 11; it is on N. edge of pond; 10' N. of fence 6'; it is on surface		

T. 80 N. R. 3 E. OF 5TH P. M.

WINFIELD TOWNSHIP

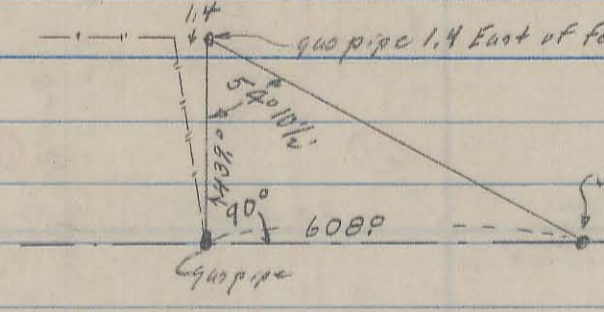