

PROPERTY PLAT

Acquired from WILLIAM SCHNOOR

Married or Single? _____ (Give full name of spouse)

R. O. W. Area 0.83 ± Acres.

Borrow Area _____ Acres. Total Consideration \$ _____


Acquired by EASEMENT Date of Contract _____, 19____
(Easement—Deed—Condemnation—Contract)

LOCATION

From CL Station 62+50.00 to CL Station 85+21.47

Section 15, Township 79 N, Range 4 E

Township (Civil) LINCOLN Iowa.

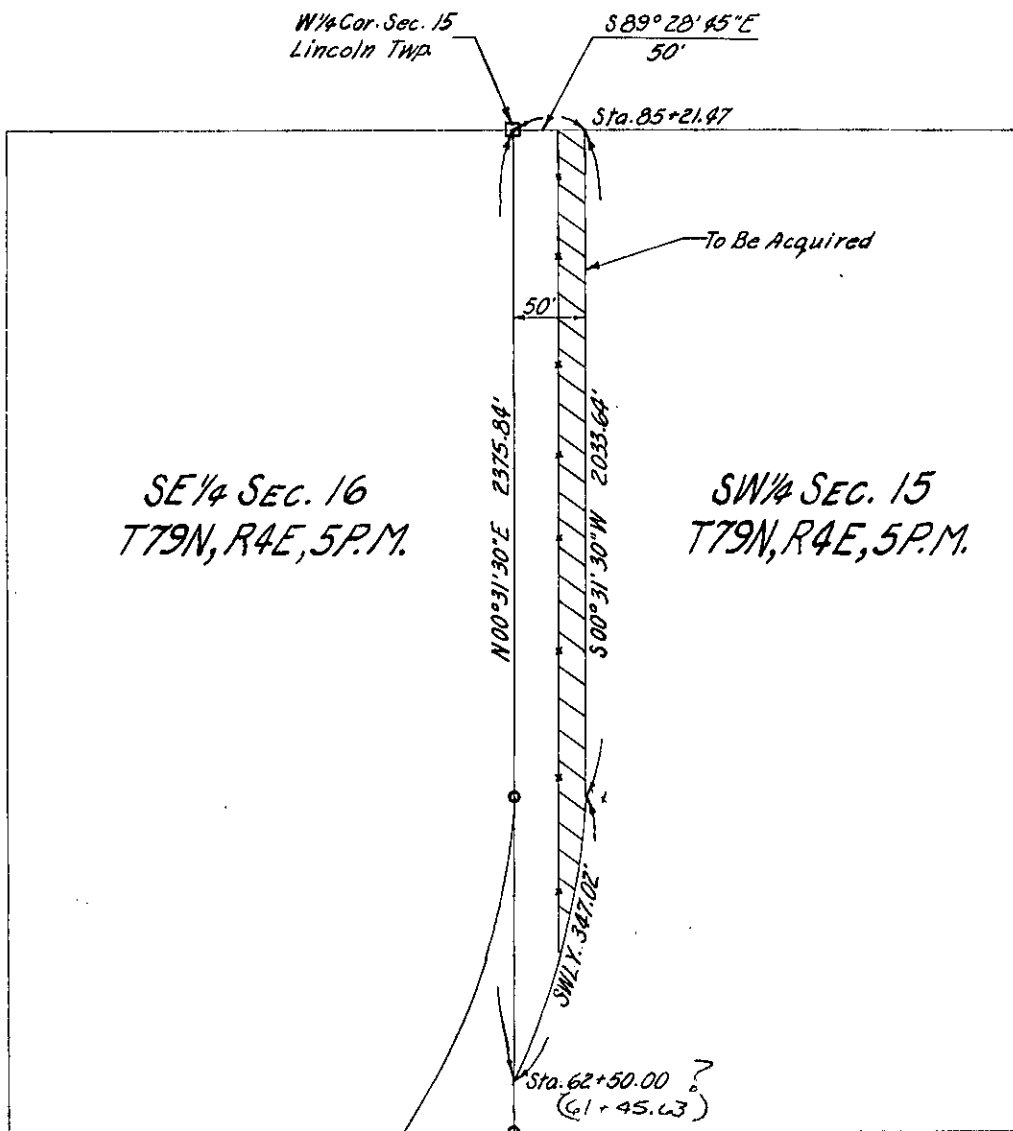

SCOTT
(County)

Project No. 462 PROP. # 5