

Parcel No. 21

PROPERTY PLAT Microfilm File # 13476-75

Acquired from CLIFFORD W. ECKERMANN & WIFE

Married or Single?

(Give full name of spouse)

Area by Deed _____ Acres.

Area by Easement 0.60 ± Acres. Total Consideration \$ _____


Borrow Area 0.28 ± Acres. Contract Date _____, 19 _____

LOCATION

From CL Station 142+37.30 to CL Station 163+91.24

Section 28, Township 79 N, Range 4 E.

Township (Civil) LINCOLN Iowa.

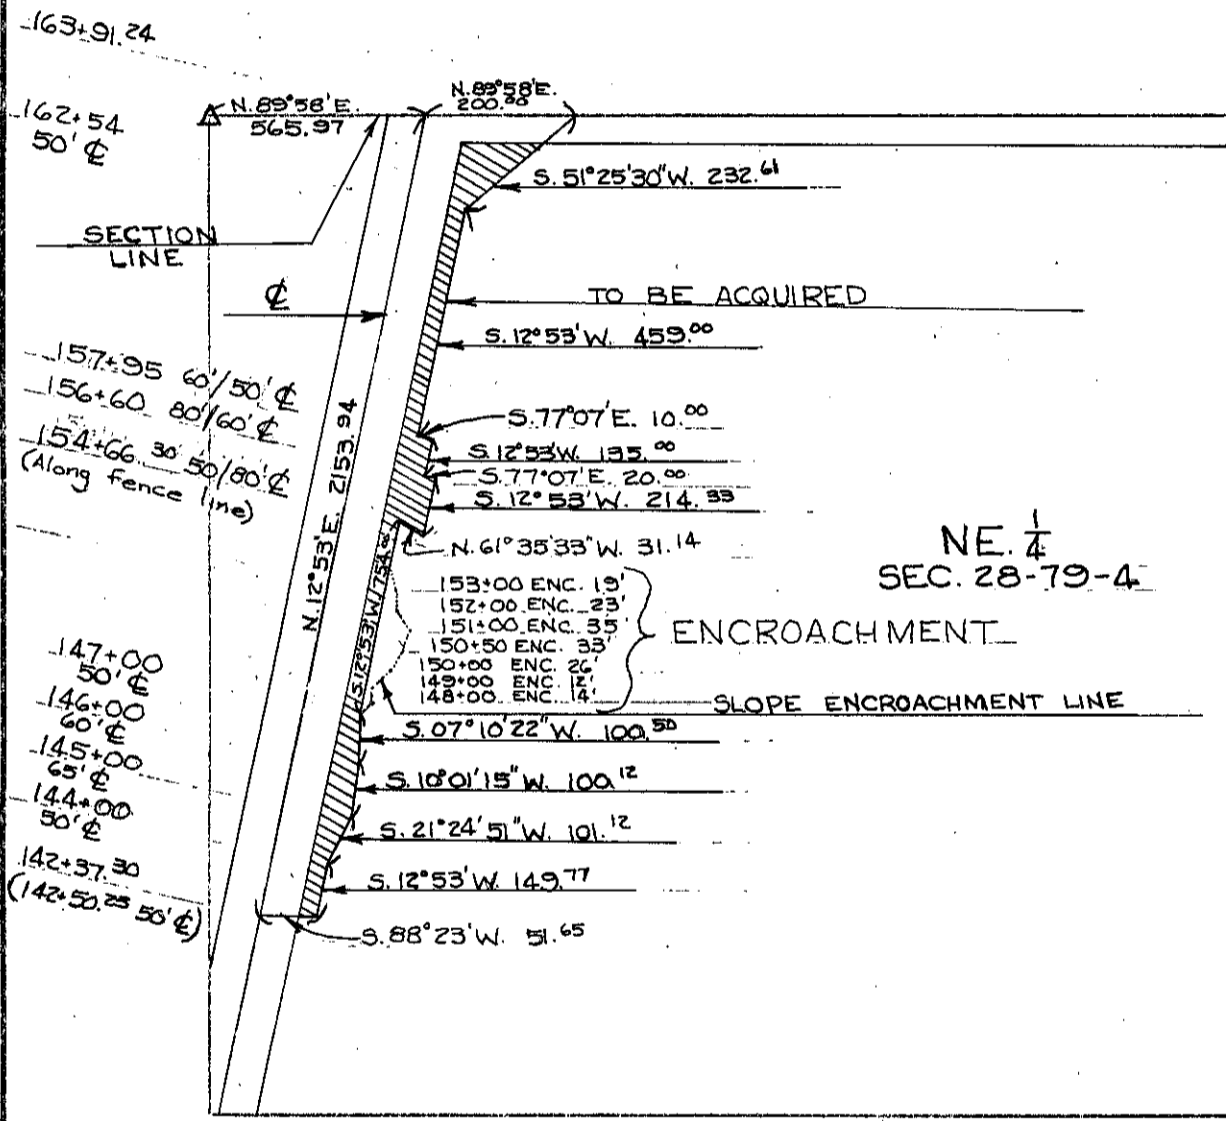

NE 1/4
SEC. 28-79-4

SCOTT
(County)

Project No. L-274

List areas by 40 acre tracts or Gov't lots, etc. (to tenths of an acre).