

### PROPERTY PLAT

Acquired from CENTERLINE RELOCATION & REESTABLISHMENT  
(Name of owner must agree exactly with Name in which property stands of Record.)

Married or Single? \_\_\_\_\_ (Give full name of spouse)


R. O. W. Area \_\_\_\_\_ Acres.

Borrow Area \_\_\_\_\_ Acres. Total Consideration \$ \_\_\_\_\_

Acquired by CONSENT PETITION Date of Contract \_\_\_\_\_, 19\_\_\_\_  
(Easement—Deed—Condemnation—Contract)

#### LOCATION

From CL Station 6+12 to CL Station 158+69.91  
Section 31, 30, 19, Township 79, Range 1  
Township (Civil) CLEONA, County of SCOTT Iowa.

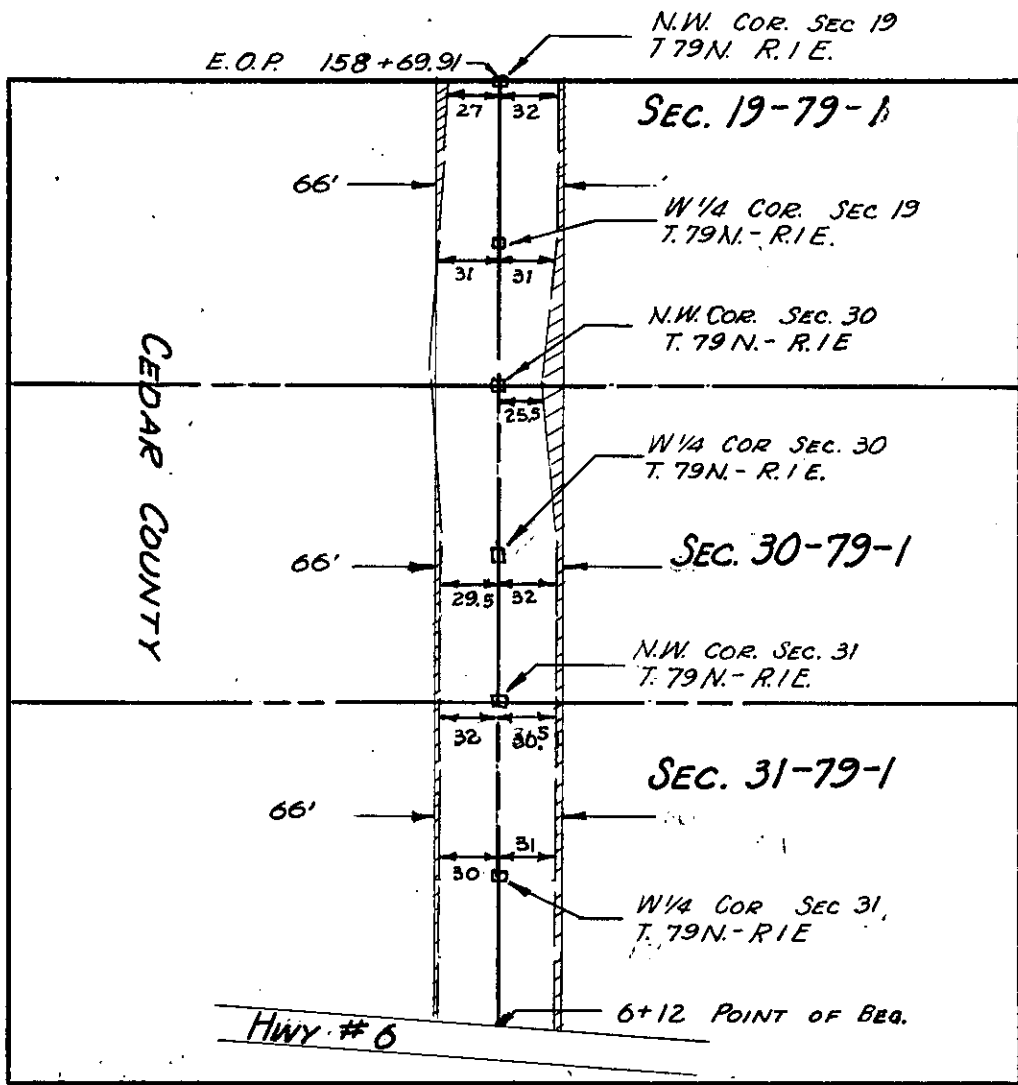

SCOTT  
(County)

Project No. S-2435