


R. IV

R.

V

12a

12  
12b

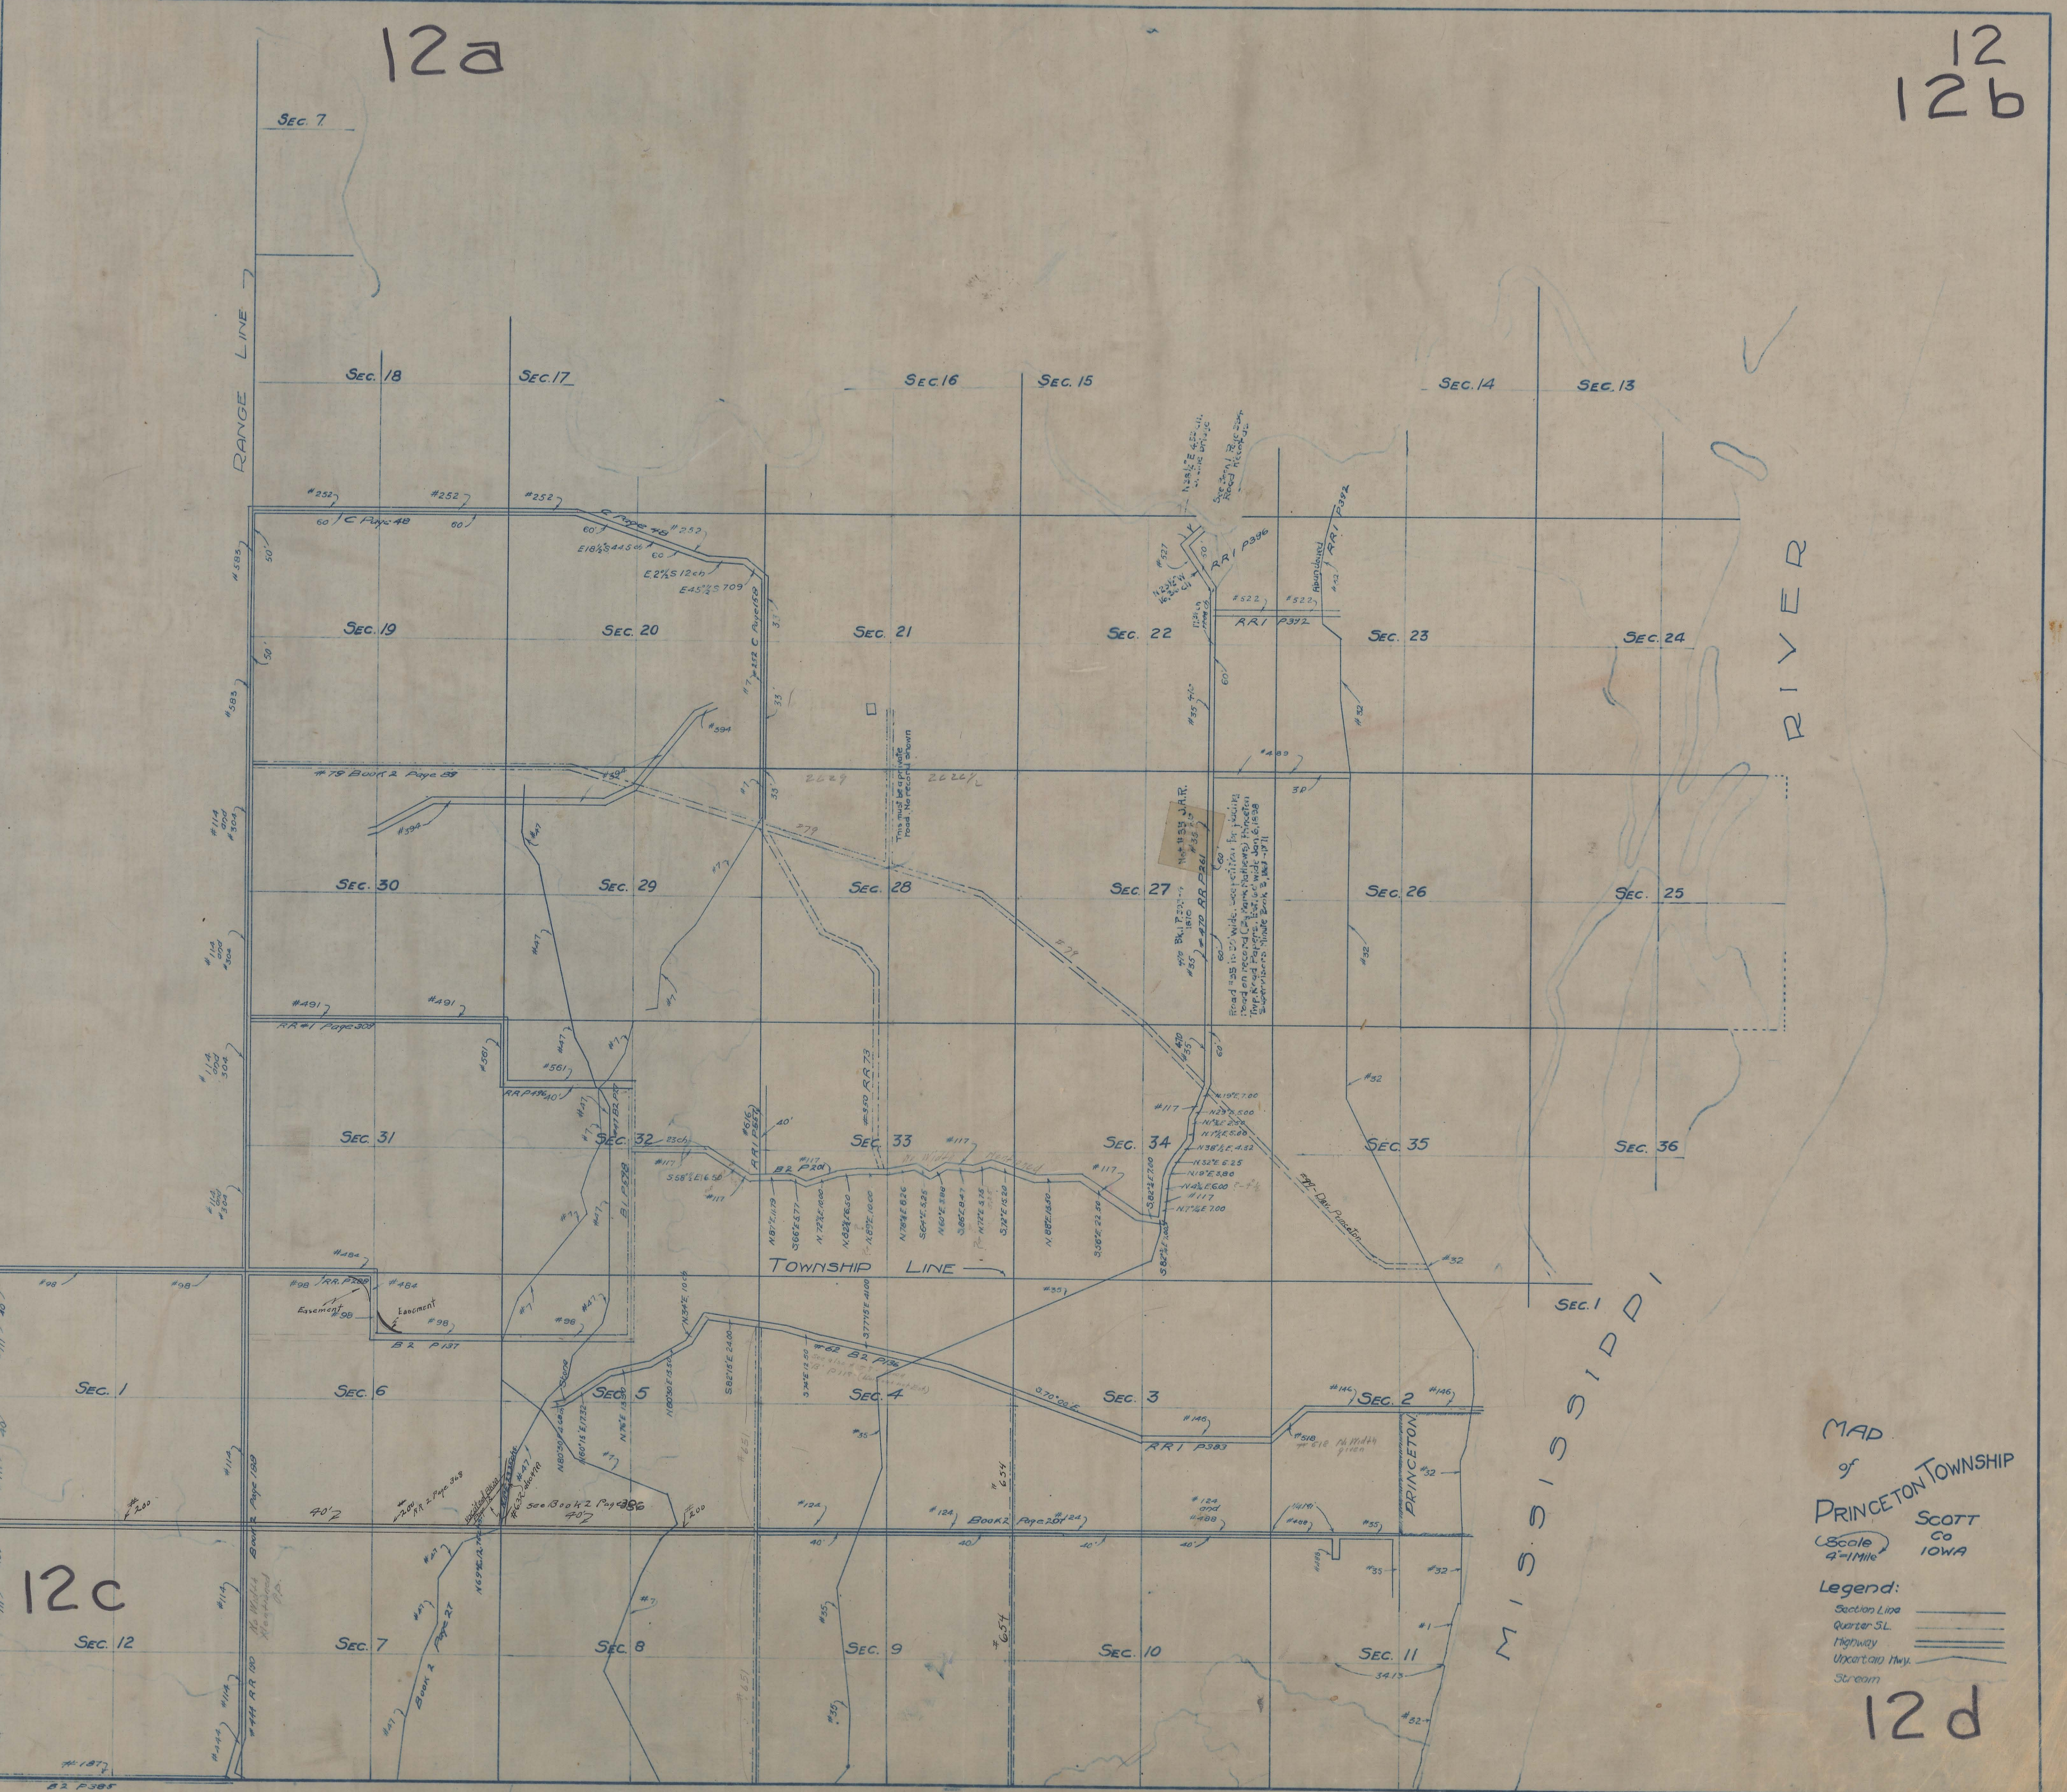

RIVER

MISSISSIPPI

MAD  
of  
PRINCETON TOWNSHIP  
SCOTT  
CO  
IOWA

Scale  
4"=1 Mile

Legend:  
Section Line  
Quarter SL  
Highway  
Unimproved Hwy.  
Stream

12c

12d

B2 P 308