


15a

15
15b

R III

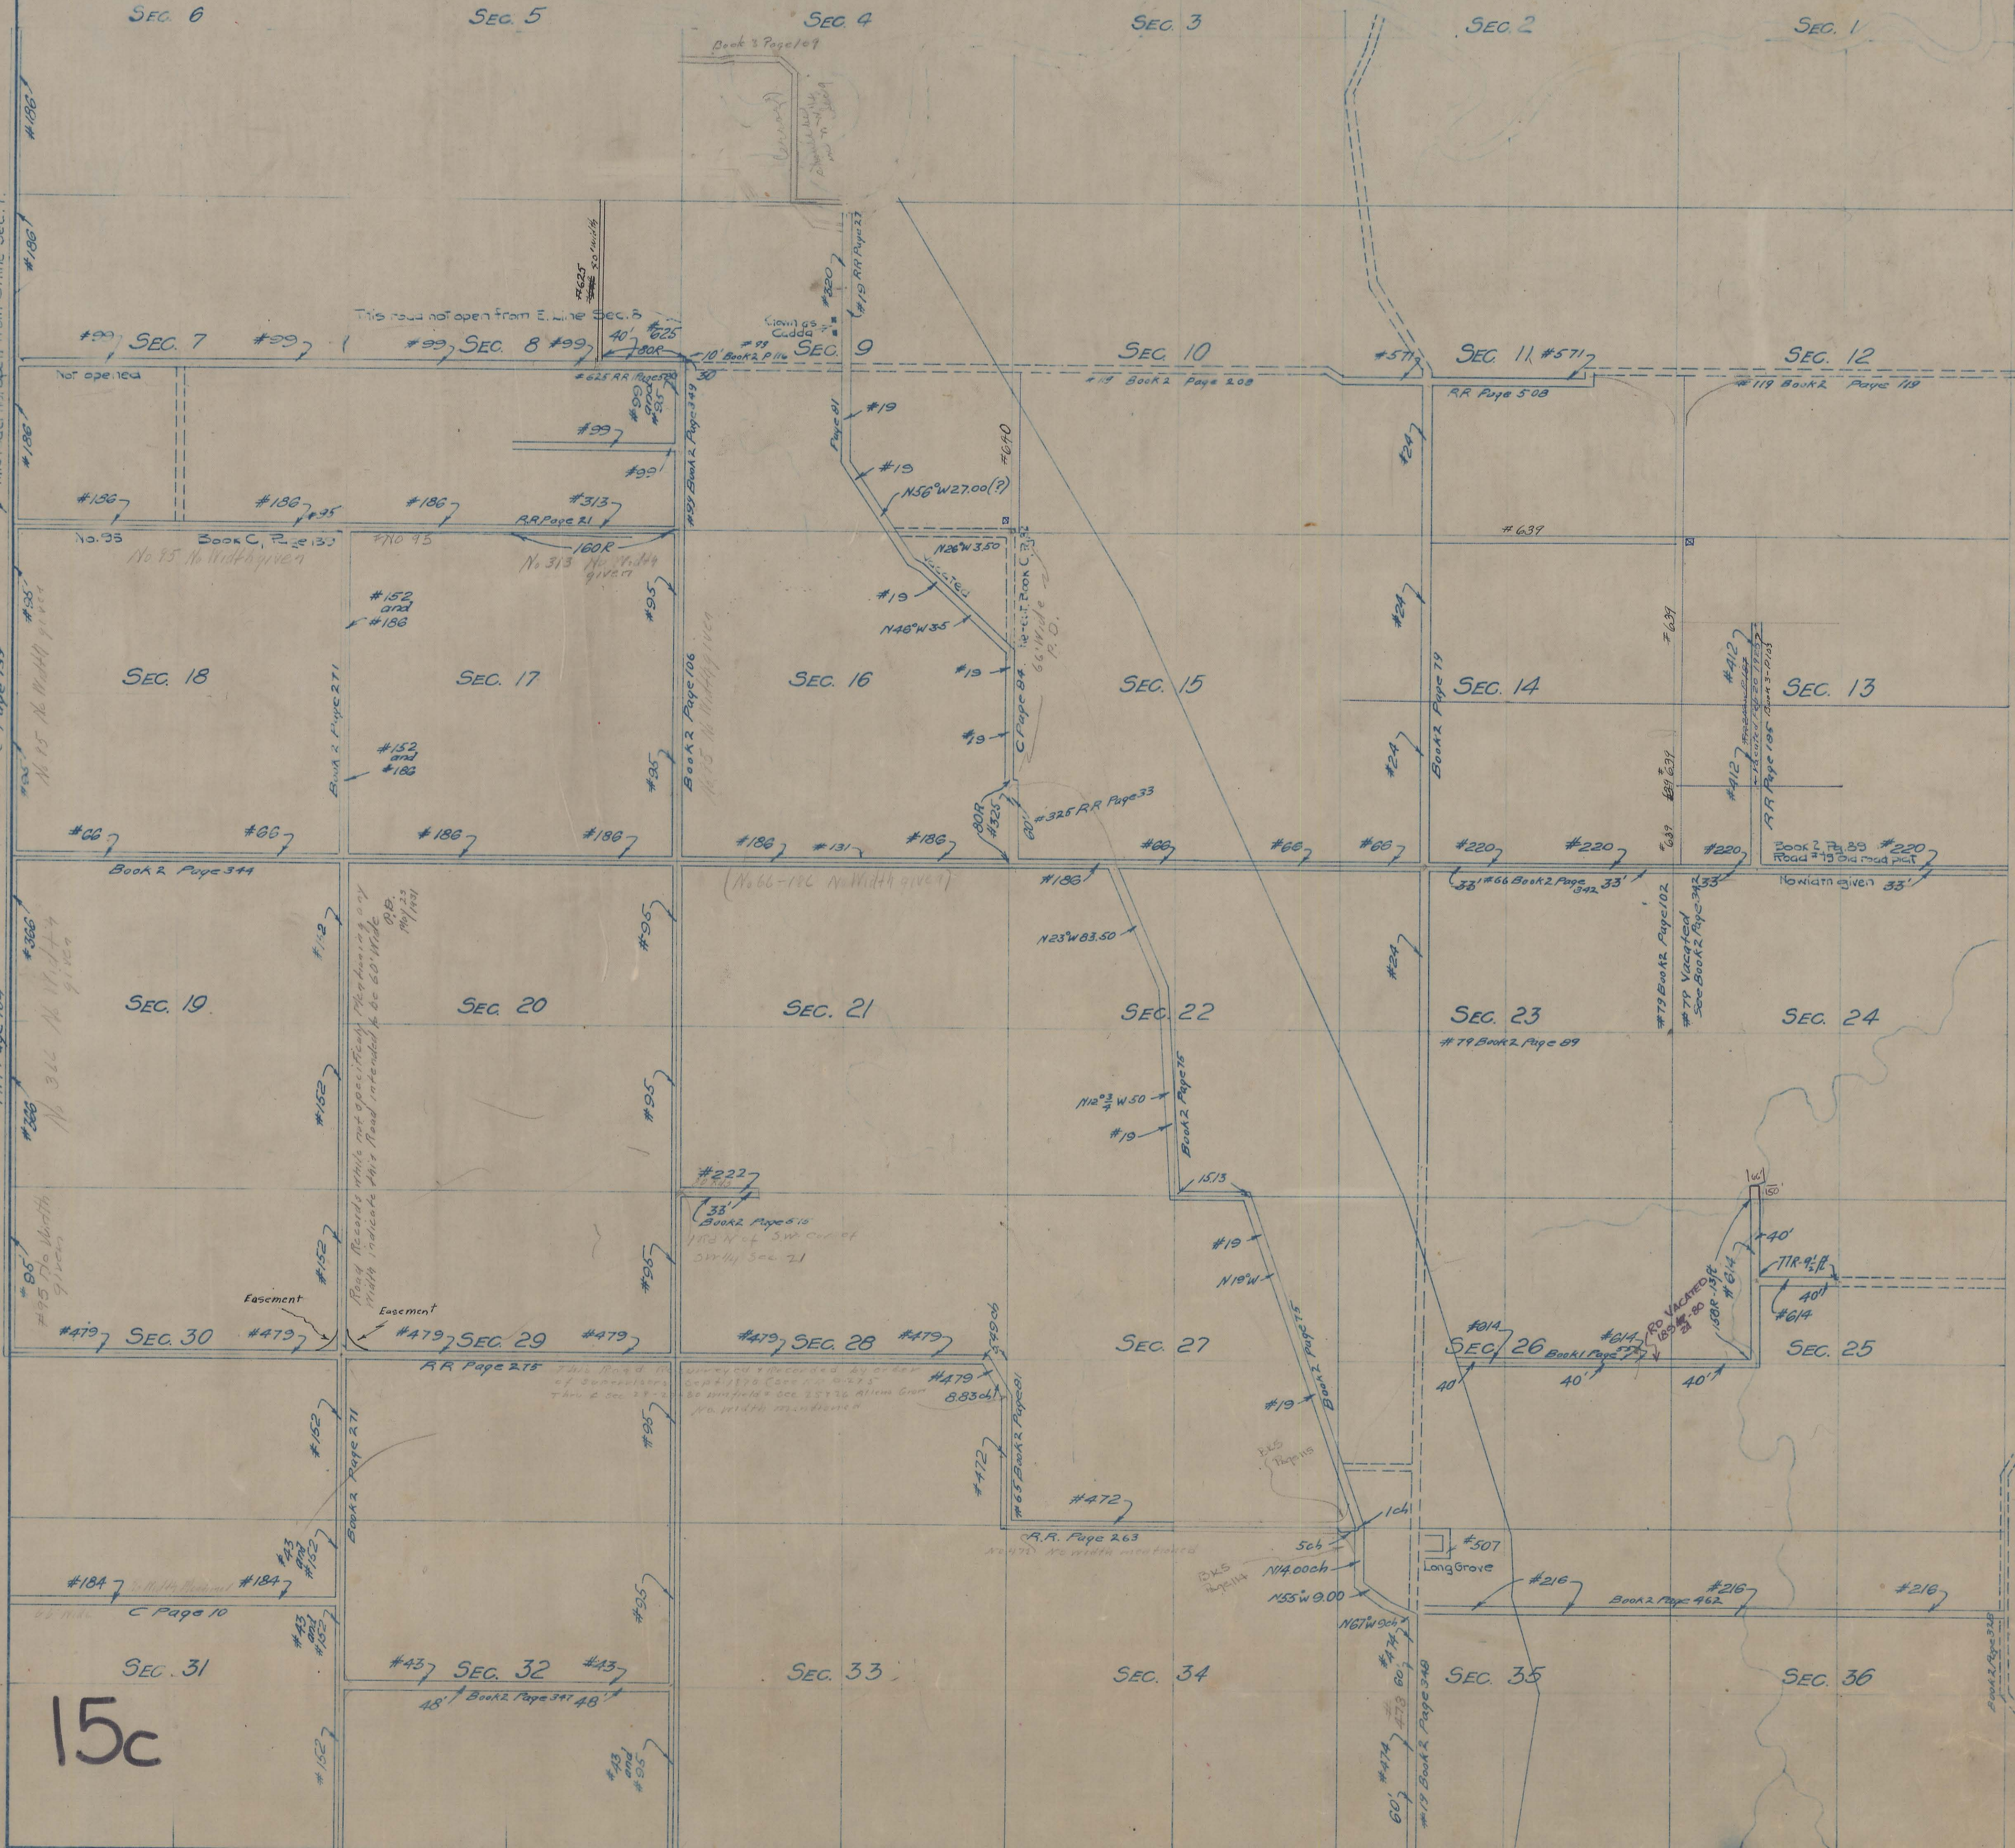

MAP of TOWNSHIP WINFIELD SCOTT Co. IOWA
 Scale 4"=1 1/2 mile

Legend:
 Section Line
 Quarter 3/4
 Highway
 Unclearway
 Stream

15c

15d